

ADDENDUM NO.: THREE DATE: 29 July 2013

PROJECT TITLE: HORIZON GROUND AND FOURTH FLOOR UPFIT

University of South Carolina State Project No. H27-6081-AC WTS Project No. 11700/ File 7.0

WTS FILE NO.: 11700 / 7.0

WRITTEN BY: John McLean, AIA. LEED AP

J. Sanders Tate, AIA LEED AP

TO: Prospective Bidders / Plan Holders

This addendum is issued pursuant to Article 1.1.1 of the AIA General Conditions of the Contract (A201) in connection with the revision of Bidding Documents which have been previously issued.

Addenda are issued prior to execution of Contract. All instructions contained herein shall be reflected in the Contract Sum and this Addendum will be made a part of the Contract Documents, if, as, and when a Construction Contract is awarded.

This Addendum forms a part of the Contract Documents and modifies the original documents dated 17 June 2013 as noted below. Acknowledge receipt of this Addendum in this space provided on the Bid Form. Failure to do so will subject the Bidder to disqualification.

This Addendum consists of 01 page and the following attachment(s):

A. BID POSTPONED

BID CLOSING DATE: 8/6/2013

TIME: 2:00 PM

LOCATION: USC, 743 Greene Street, Columbia, SC 29208

B. CLARIFICATION

- 1. Addendum 2 is being re-issued unaltered from first issue except for corrupted text now printed accurately.
- 2. The General Contractor shall provide all firestopping for the Work through a single firestopping subcontractor for all trades.

END OF ADDENDUM



ADDENDUM NO.: TWO DATE: 25 July 2013

PROJECT TITLE: HORIZON GROUND AND FOURTH FLOOR UPFIT

University of South Carolina State Project No. H27-6081-AC WTS Project No. 11700/ File 7.0

WTS FILE NO.: 11700 / 7.0

WRITTEN BY: John McLean, AIA. LEED AP

J. Sanders Tate, AIA LEED AP

TO: Prospective Bidders / Plan Holders

This addendum is issued pursuant to Article 1.1.1 of the AIA General Conditions of the Contract (A201) in connection with the revision of Bidding Documents which have been previously issued.

Addenda are issued prior to execution of Contract. All instructions contained herein shall be reflected in the Contract Sum and this Addendum will be made a part of the Contract Documents, if, as, and when a Construction Contract is awarded.

This Addendum forms a part of the Contract Documents and modifies the original documents dated 17 June 2013 as noted below. Acknowledge receipt of this Addendum in this space provided on the Bid Form. Failure to do so will subject the Bidder to disqualification.

This Addendum consists of 03 pages and the following attachments:

SECTION 09941 – SPECIALTY PAINT FINISHES	4 pages
Drawing A2.01	1 sheet
Drawing A2.41	1 sheet
Drawing A2.51	1 sheet
Drawing A3.1	
Drawing A4.1	1 sheet
Drawing A5.1	1 sheet
Drawing I 1.3	1 sheet
Drawing I 2.3	
Drawing 13.3	1 sheet
SST Addendum 2	7 pages & 3 sheets
SSOE Addendum 2	5 pages & 13 sheets

A. REVISIONS TO THE PROJECT MANUAL:

- 1. Incorporate revisions as listed in attached Addendum 2 documents
- 2. SECTION 01331 ELECTRONIC SUBMITTAL PROCEEDURES
 - a. Article 2.1 B: add Newforma Project Cloud as approved vendor-hosted website

- 3. SECTION 04200 UNIT MASONRY
 - a. Article 2.8.E.1: add "e. Hohmann-Barnard"
- 4. SECTION 07271 UNDER SLAB VAPOR BARRIERS
 - a. Article 2.1.A.2: add Viper VAPORCHECK II 15 "Class A" vapor barrier as approved product
- 5. SECTION 07841 THROUGH PENITRATION FIRESTOP SYSTEMS
 - a. Article 1.1, Add the following; B. Provide 200 l.f. of bottom of wall firestopping and 200 l.f. of top of wall firestopping in addition to firestopping shown in the documents to be provided at existing partitions. Locations shall be identified in advance and approved by the Architect prior to this work being done.
 - b. Article 1.5, replace A with the following; A. Installer Qualifications; A firm that has been approved by FMG according to FMG 4991, "Approval of Firestop Contractors." or a UL Qualified Firestop Contractor
- 6. SECTION 8710 FINISH HARDWARE
 - a. Article 2.2, A; Add Cores: 7 pin Best shall be provided (no substitutions)
 - b. Part 4, Schedule, Hardware Set 4; add door 019A to this set.
- 7. SECTION 09941 SPECIALTY PAINT
 - a. Add this specification section for painting FRP columns at fourth floor

B. <u>REVISIONS TO DRAWINGS</u>:

- 1. Replace Drawings listed as attachment to this addendum with revised Drawings that are a part of this addendum.
- 2. Replace Drawings listed within Addendum 2 attachments to this addendum with revised Drawings that are a part of Addendum 2 attachments.

C. RESPONSES TO QUESTIONS:

- 1. Is the roof patio under a roofing warranty? Who has the warranty and who installed the system? Response; Product specified is a specific compatible roof system that is by the manufacturer of the spray applied system that is existing. The scope of work is not warranty work but added scope. There is no current problem with the membrane. A pre-installation conference with the manufacturers rep on site will be part of the work.
- General note 6 on sheet A2.11 indicates that the finishes are to be patched. Please clarify what finishes need to be patched beyond the base.
 Response; bidders shall assume existing finishes in existing data closets are painted gypsum wallboard and unpainted structure a the ceiling and VCT at the floor.
- 3. The finish schedule indicates that the finishes need to be patched/repaired in existing areas as necessary. However, the types of finishes in those areas are not indicated. Please provide. Response; finish schedules for floors 1-3 are included for information only.

- 4. 414 server and an area in the penthouse have a fire rated insulation protection detail (a6.21/4). There is a general note on this detail that indicated that this detail should apply to all locations that duct has fire rated insulation. The plans only indicate these two locations. Please verify that these two location are the only location requiring this detail. Response; See section references and notations on RCPs and penthouse plan calling out detail 6 on sheet A6.21, also designated by hatched area.
- 5. Please clarify the requirement for the installer qualifications for section 08412. Response, specified qualifications are unchanged per this addendum.

END OF ADDENDUM

SECTION 09941 - SPECIALTY PAINT FINISHES

PART 1 - GENERAL

1.1 SECTION INCLUDES

- A. Surface preparation and finishing of all surfaces to receive specialty paint finish as indicated on the drawings.
- B. "Paint" includes primers, sealers and fillers as recommended by the specialty paint finish manufacturer. All materials within this section, including finishes, primers and basecoats are to be provided by one manufacturer.

1.2 SYSTEM DESCRIPTION

- A. Finish Materials: Conform to applicable code for flame/fuel/smoke rating requirements.
- B. Fire Ratings:
 - 1. Class A Fire Hazard Classification.
 - 2. Test Procedure ASTM E-84.

1.3 SUBMITTALS

- A. Product Data: Provide data on all finishing products.
- B. Paint Schedule: Submit schedule for each substrate type and paint product to be applied including number of coats and finish prep (between coats).
- C. Submit manufacturer's full color line for initial selection process.
- D. Samples: Submit two samples, 5 x 8 inch in size illustrating range of colors and textures available for each surface finishing product selected from initial submission.
- E. Final selection will be from job-applied samples only. Allow at least three minor shading changes of job-applied sample before final selection.

1.4 DELIVERY, STORAGE, AND HANDLING

- A. Deliver materials in their original, unopened containers bearing manufacturer's labels.
- B. Provide fire extinguishers in storage area. Do not leave containers open. Remove empty cans and rags with oil or solvent from building every day.
- C. Container label to include manufacturer's name, type of paint, brand name, lot number, brand code, coverage, surface preparation, drying time, cleanup requirements, color designation, and instructions to mixing and reducing as required.
- D. Store paint materials at minimum ambient temperature of 50 degrees F and a maximum of 85 degrees F in ventilated area, and as required by manufacturer's instructions. Protect from freezing.

1.5 ENVIRONMENTAL REQUIREMENTS

- A. Do not apply materials when surface and ambient temperatures are outside the temperature ranges required by the paint product manufacturer.
- B. Apply coating under the following conditions:
 - 1. Temperature is between 50 and 85 degrees F.
 - 2. Temperature of substrate is above dew point.
 - 3. Substrate is dry to touch.
- C. Protect surfaces not to be coated.
- D. Provide lighting level of 80-footcandles measured mid-height at substrate surface.
- E. Provide adequate fresh air and ventilation during application.

1.6 EXTRA MATERIALS

- A. Furnish under provisions of Division 1.
- B. Provide 2 (two) sheets of pre-finished repair samples for each color blend used.
- C. Submit complete manufacturer maintenance manual to Owner.
- D. Provide 1 (one) gallon of each color blend used to Owner in sealed, labeled containers.
- E. Label each container with color, type, texture, and room locations in addition to the manufacturer's label.

PART 2 - PRODUCTS

2.1 MANUFACTURERS

- A. Manufacturers:
 - Zolatone Interior Finishes Basis of Design.
 - a. Surface Protection Industries, Inc.

400 Charter Way

N. Billerica, MA 01862

b. Available through local Zolatone Interior Finishes representative:

Cheryl Simerly & Associates

3208 Sadler Road

Charlotte. NC 28278-9668

(704) 577-8717

- 2. Approved Equal.
- B. Primers, Sealers and Fillers: Provide basecoats recommended by manufacturer. Do not tint basecoats. Use only products manufactured by the same manufacturer as as the finish coats.
- C. Finish Coats:

- 1. Counterpointe™ by Zolatone® light reflective wall finish. Finish shall be readymixed; no tinting required.
 - a. Pearltone Finish. Apply with airless spray equipment as recommended by manufacturer.
 - b. Sandtone Finish. Apply with conventional air-spraying equipment as recommended by manufacturer.
- 2. Approved Equal.
- D. Provide waterbased, Low VOC paint only, for LEED certification.
- E. Provide primers and undercoat paint produced by the same manufacturer as the finish coats.
- F. Accessory Materials: Linseed oil, shellac, turpentine, paint thinners and other materials required to achieve the finishes specified as recommended by the coating manufacturer.
- G. All materials utilized must be lead-free and shall comply with Section 401(b) of the Lead-Based Poisoning Prevention Act.
- H. All paints, coatings, and accessory materials shall comply with Volatile Organic Compound (VOC) regulations currently in effect at the project location.

PART 3 - EXECUTION

3.1 EXAMINATION AND PREPARATON

- A. Applicator Qualifications:
 - 1. Applicator shall certify in writing that technicians utilized for work in this section have been trained by the manufacturer or its representative.
 - 2. Applicator shall include in his certification that specialized equipment as required by the manufacturer will be used for work in this section.
- B. Verify that substrate conditions are ready to receive Work and are in accordance with coating manufacturer's requirements.
- C. Measure moisture content of porous surfaces using an electronic moisture meter. Do not apply finishes unless moisture content is less than 12 percent or as recommended by the manufacturer.
- D. Verify that pH of surfaces to be coated is under 10.
- E. Sand and reprime all abrasions and damage spots in the surface of the basecoat before proceeding with subsequent finish coat.
- F. Ferrous Metals: Remove rust and mill scale. Shop coated, unprimed or damaged areas shall be cleaned to meet the requirements of the Steel Structures Painting Council 5P-3 Power Tool Cleaning and primed in accordance with these recommendations. Wire brush or sand damaged or rusted areas to bright metal.

Remove grease and other foreign materials with mineral spirits. Touch-up damaged areas of shop primer.

- G. Non-Ferrous Metals: Clean with lacquer thinner.
- H. Gypsum Board: Apply joint tape and compound to joints, fastener heads, dents, and surface flaws as specified in Section 09250. Prepare surface to a Level 5 drywall finish. Use acrylic joint compound (light-weight muds may cause joint problems). Sand smooth and flush with adjacent surfaces. For moisture-resistant and impact-resistant board, apply primer manufacturer's recommendations.
- I. Shop Primed Steel Surfaces: Sand and scrape to remove loose primer and rust, feather edges; clean surfaces with solvent. Prime bare steel surfaces.

3.2 APPLICATION

- A. Apply products in accordance with manufacturer's instructions.
- B. All materials shall be applied under adequate illumination, evenly spread and smoothly applied, free of runs, sags, lapmarks, air bubbles and pinholes to insure a smooth finish.
- C. Basecoat: Apply as many coats as necessary to produce a uniform substrate appearance. Do not exceed manufacturer's recommended coverage rate. Allow individual coats to dry prior to application of subsequent coats. Over drywall, back-roll basecoat if airless applied.
- D. Gypsum Board: Sand basecoat with 100 grit or finer sandpaper. Remove dust.
- E. Light Reflective Finish: Apply coating material in accordance with manufacturer's recommendation for finish coat.
- F. Apply multicolor finish to "repair sheets" as same time as application to specified substrate. Include repair sheets in Owner's maintenance manual or in job close-out package.


3.3 PROGESS CLEANING


- A. As work proceeds, promptly remove spilled, splashed, or spattered finishes.
- B. Collect waste material which may constitute a fire hazard, place in closed containers and remove daily from site


3.4 SCHEDULE –SURFACES

- A. Interior Column Enclosures at Fourth floor.
 - 1. Basecoat as recommended by the manufacturer.
 - 2. Finish coat as recommended by the manufacturer.

END OF SECTION 09941

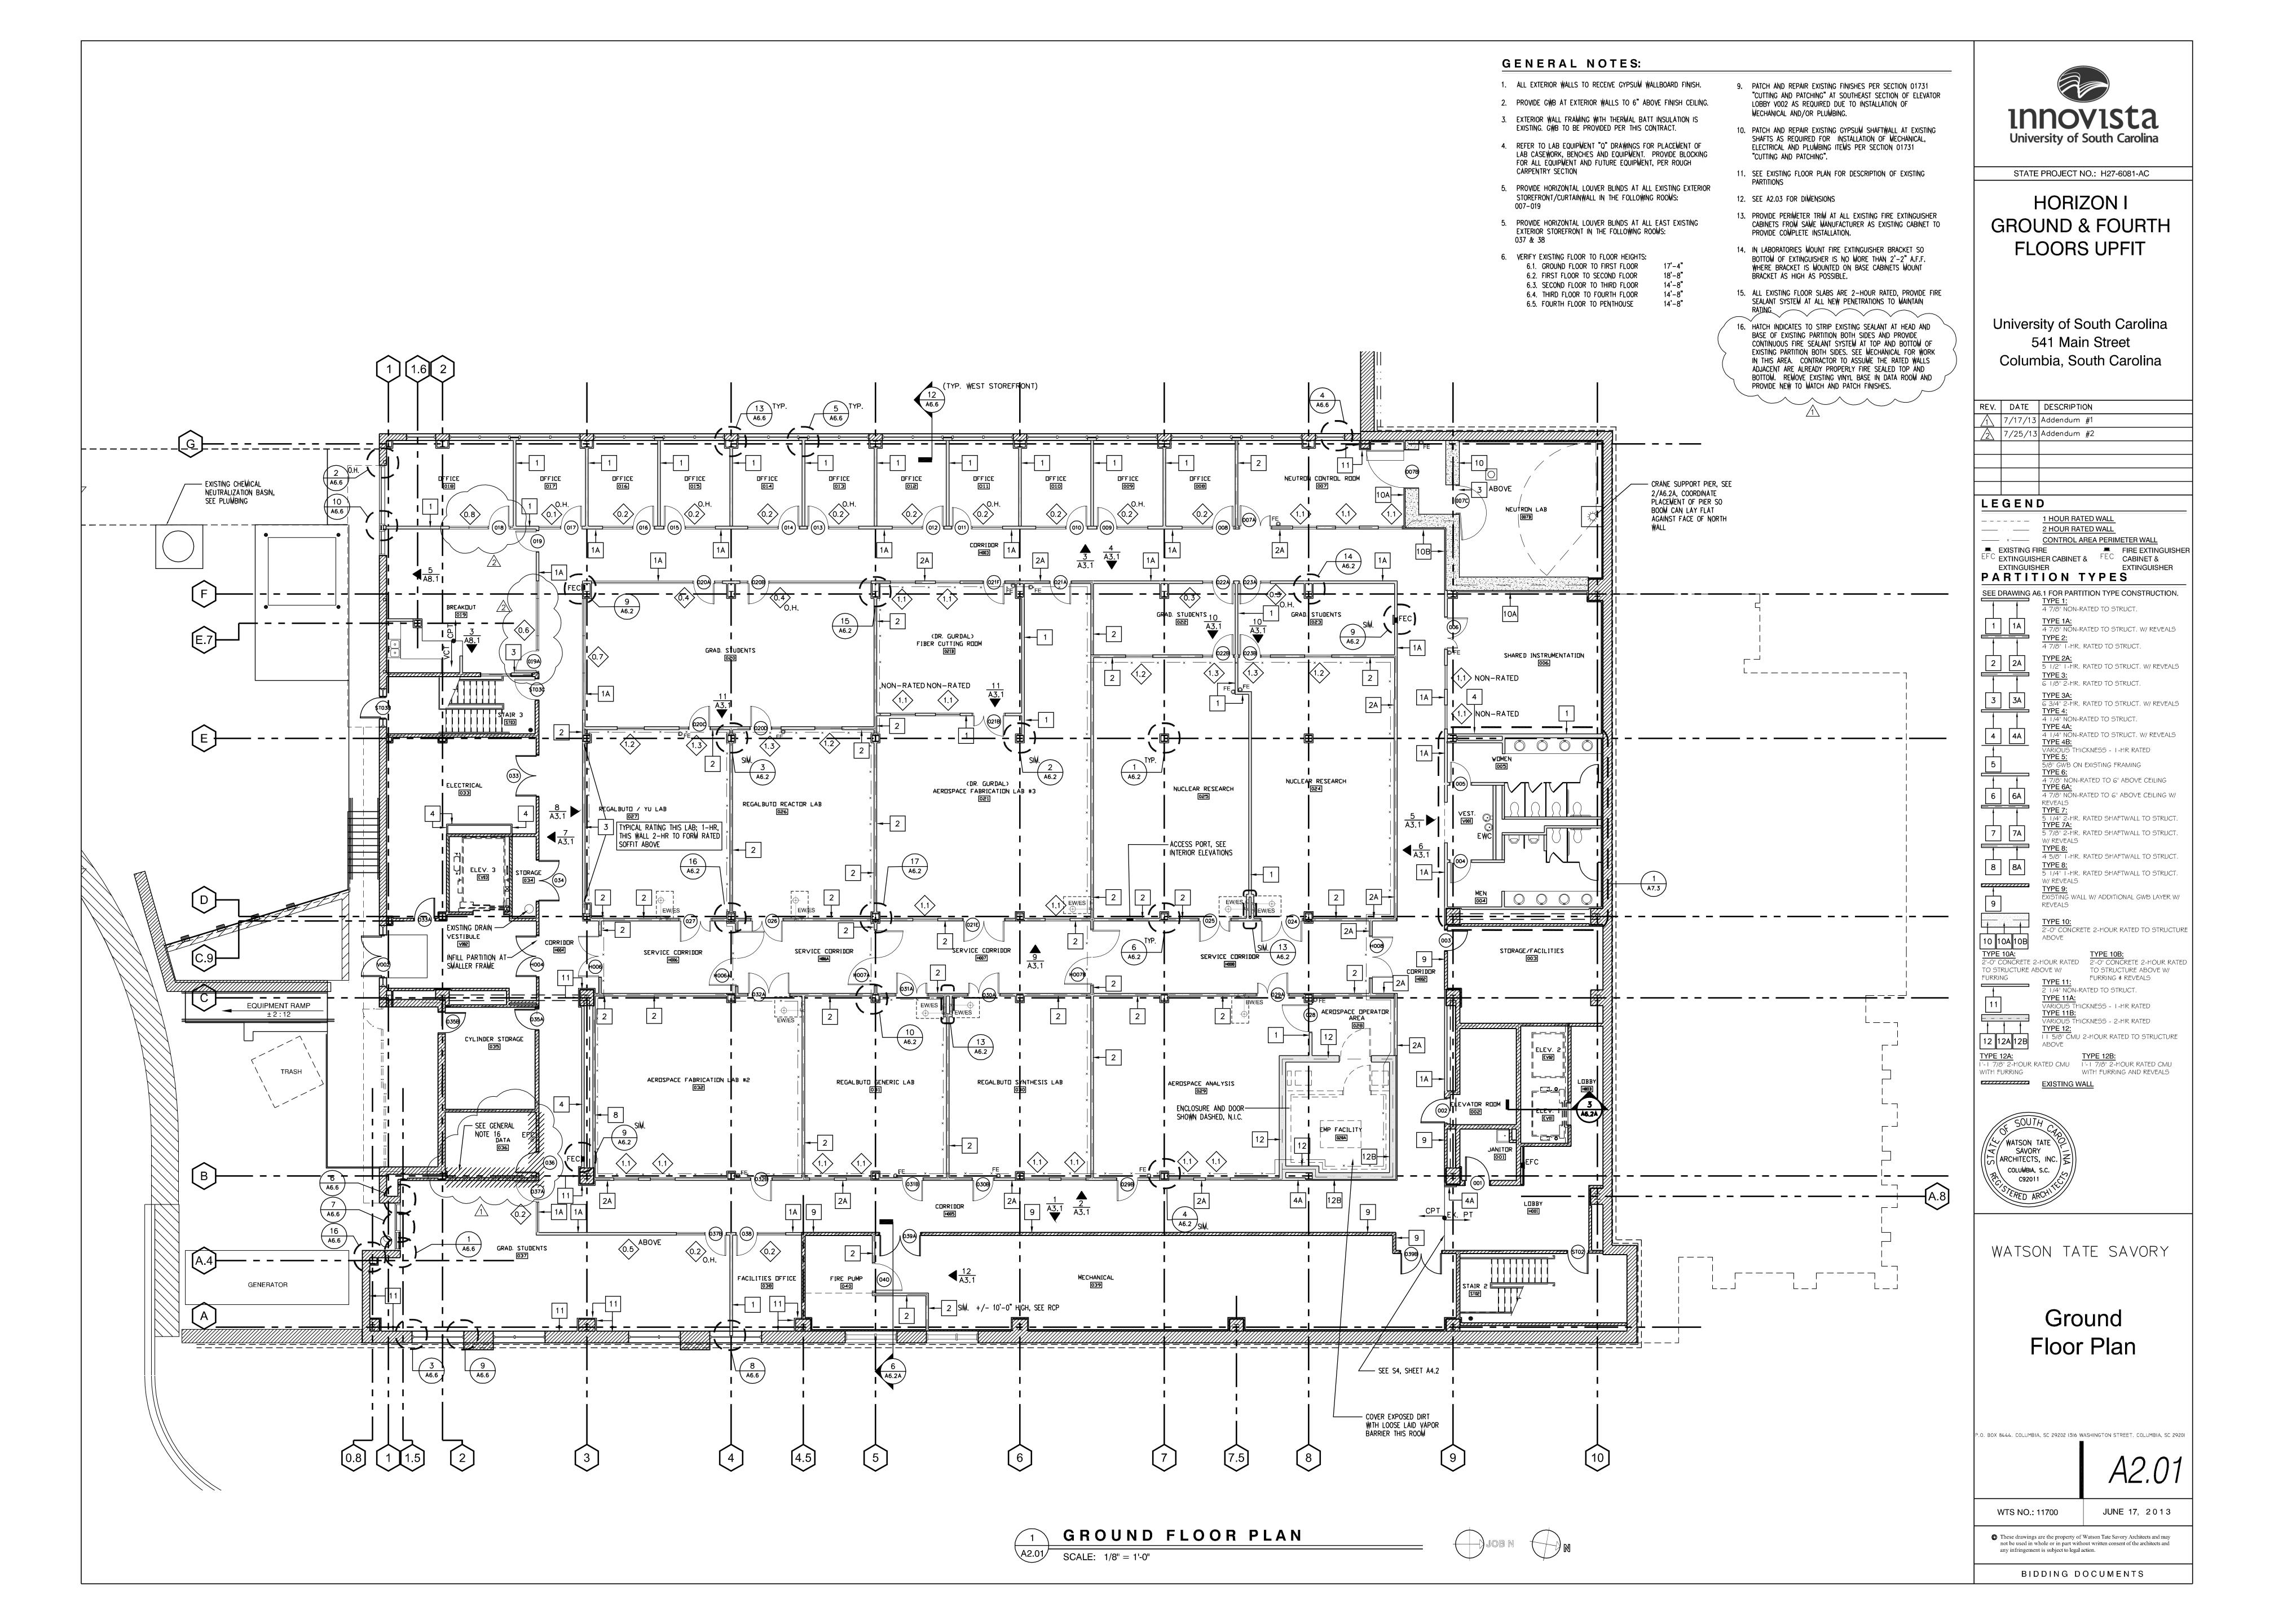

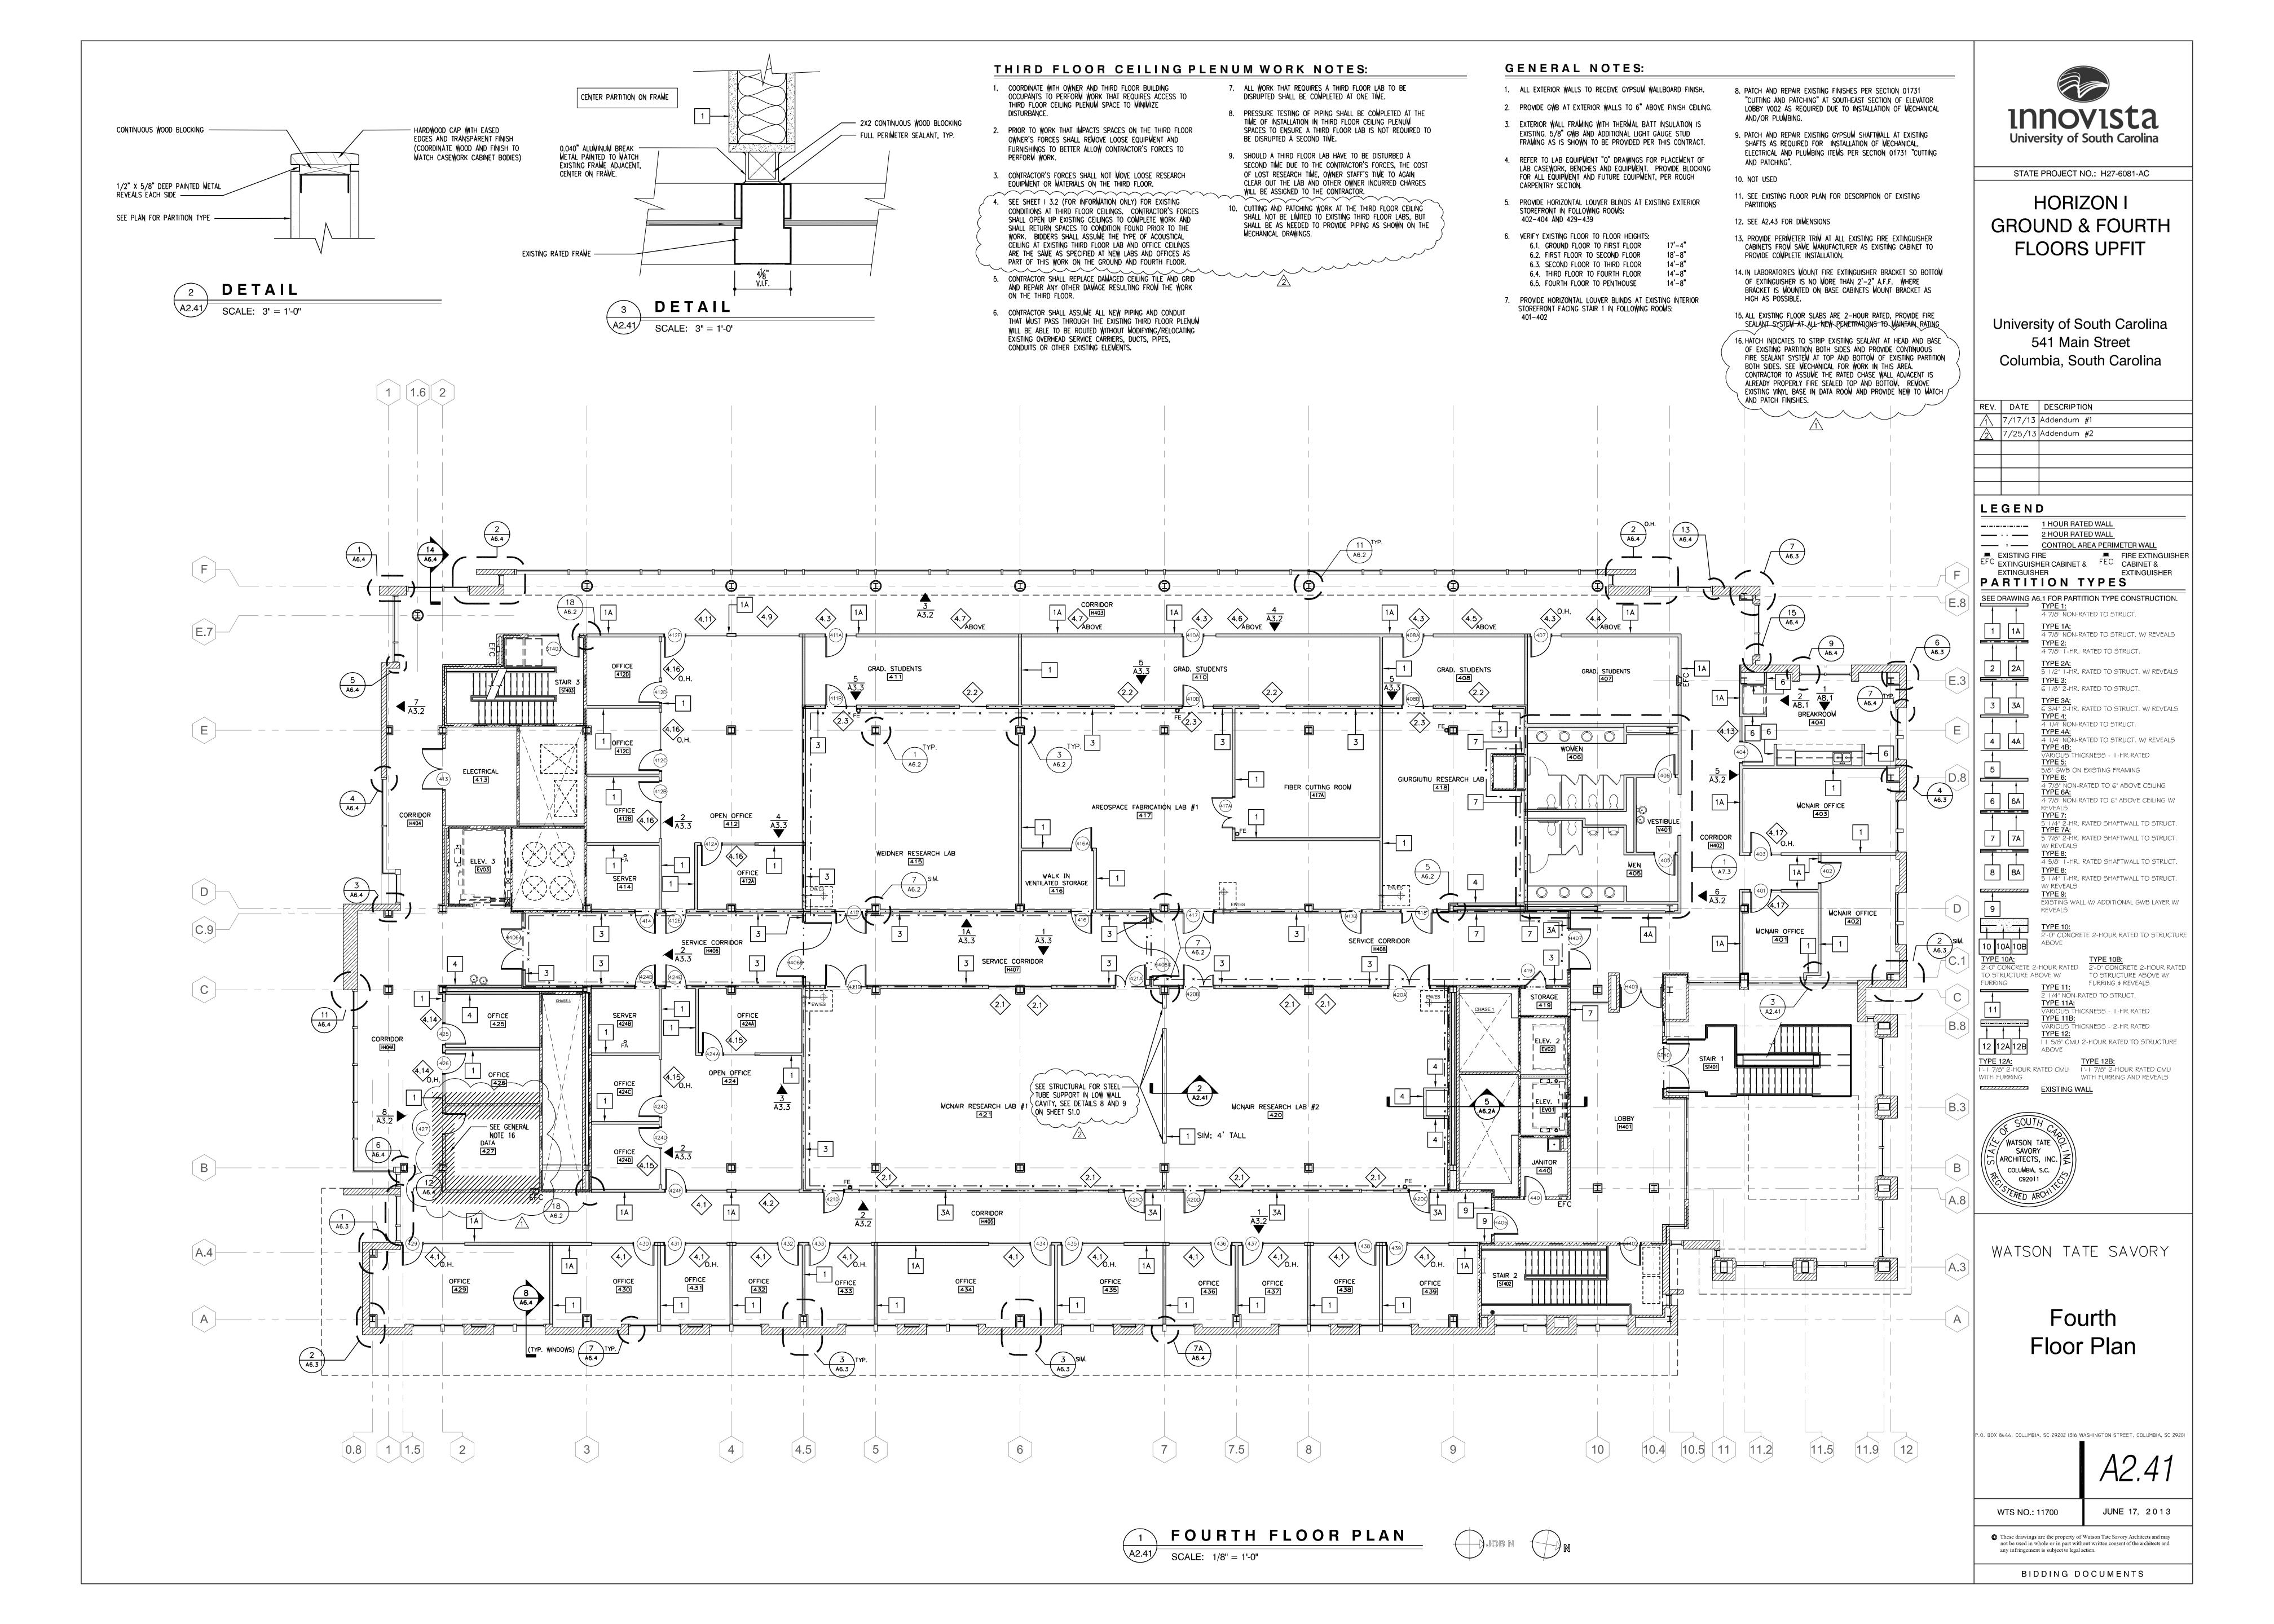

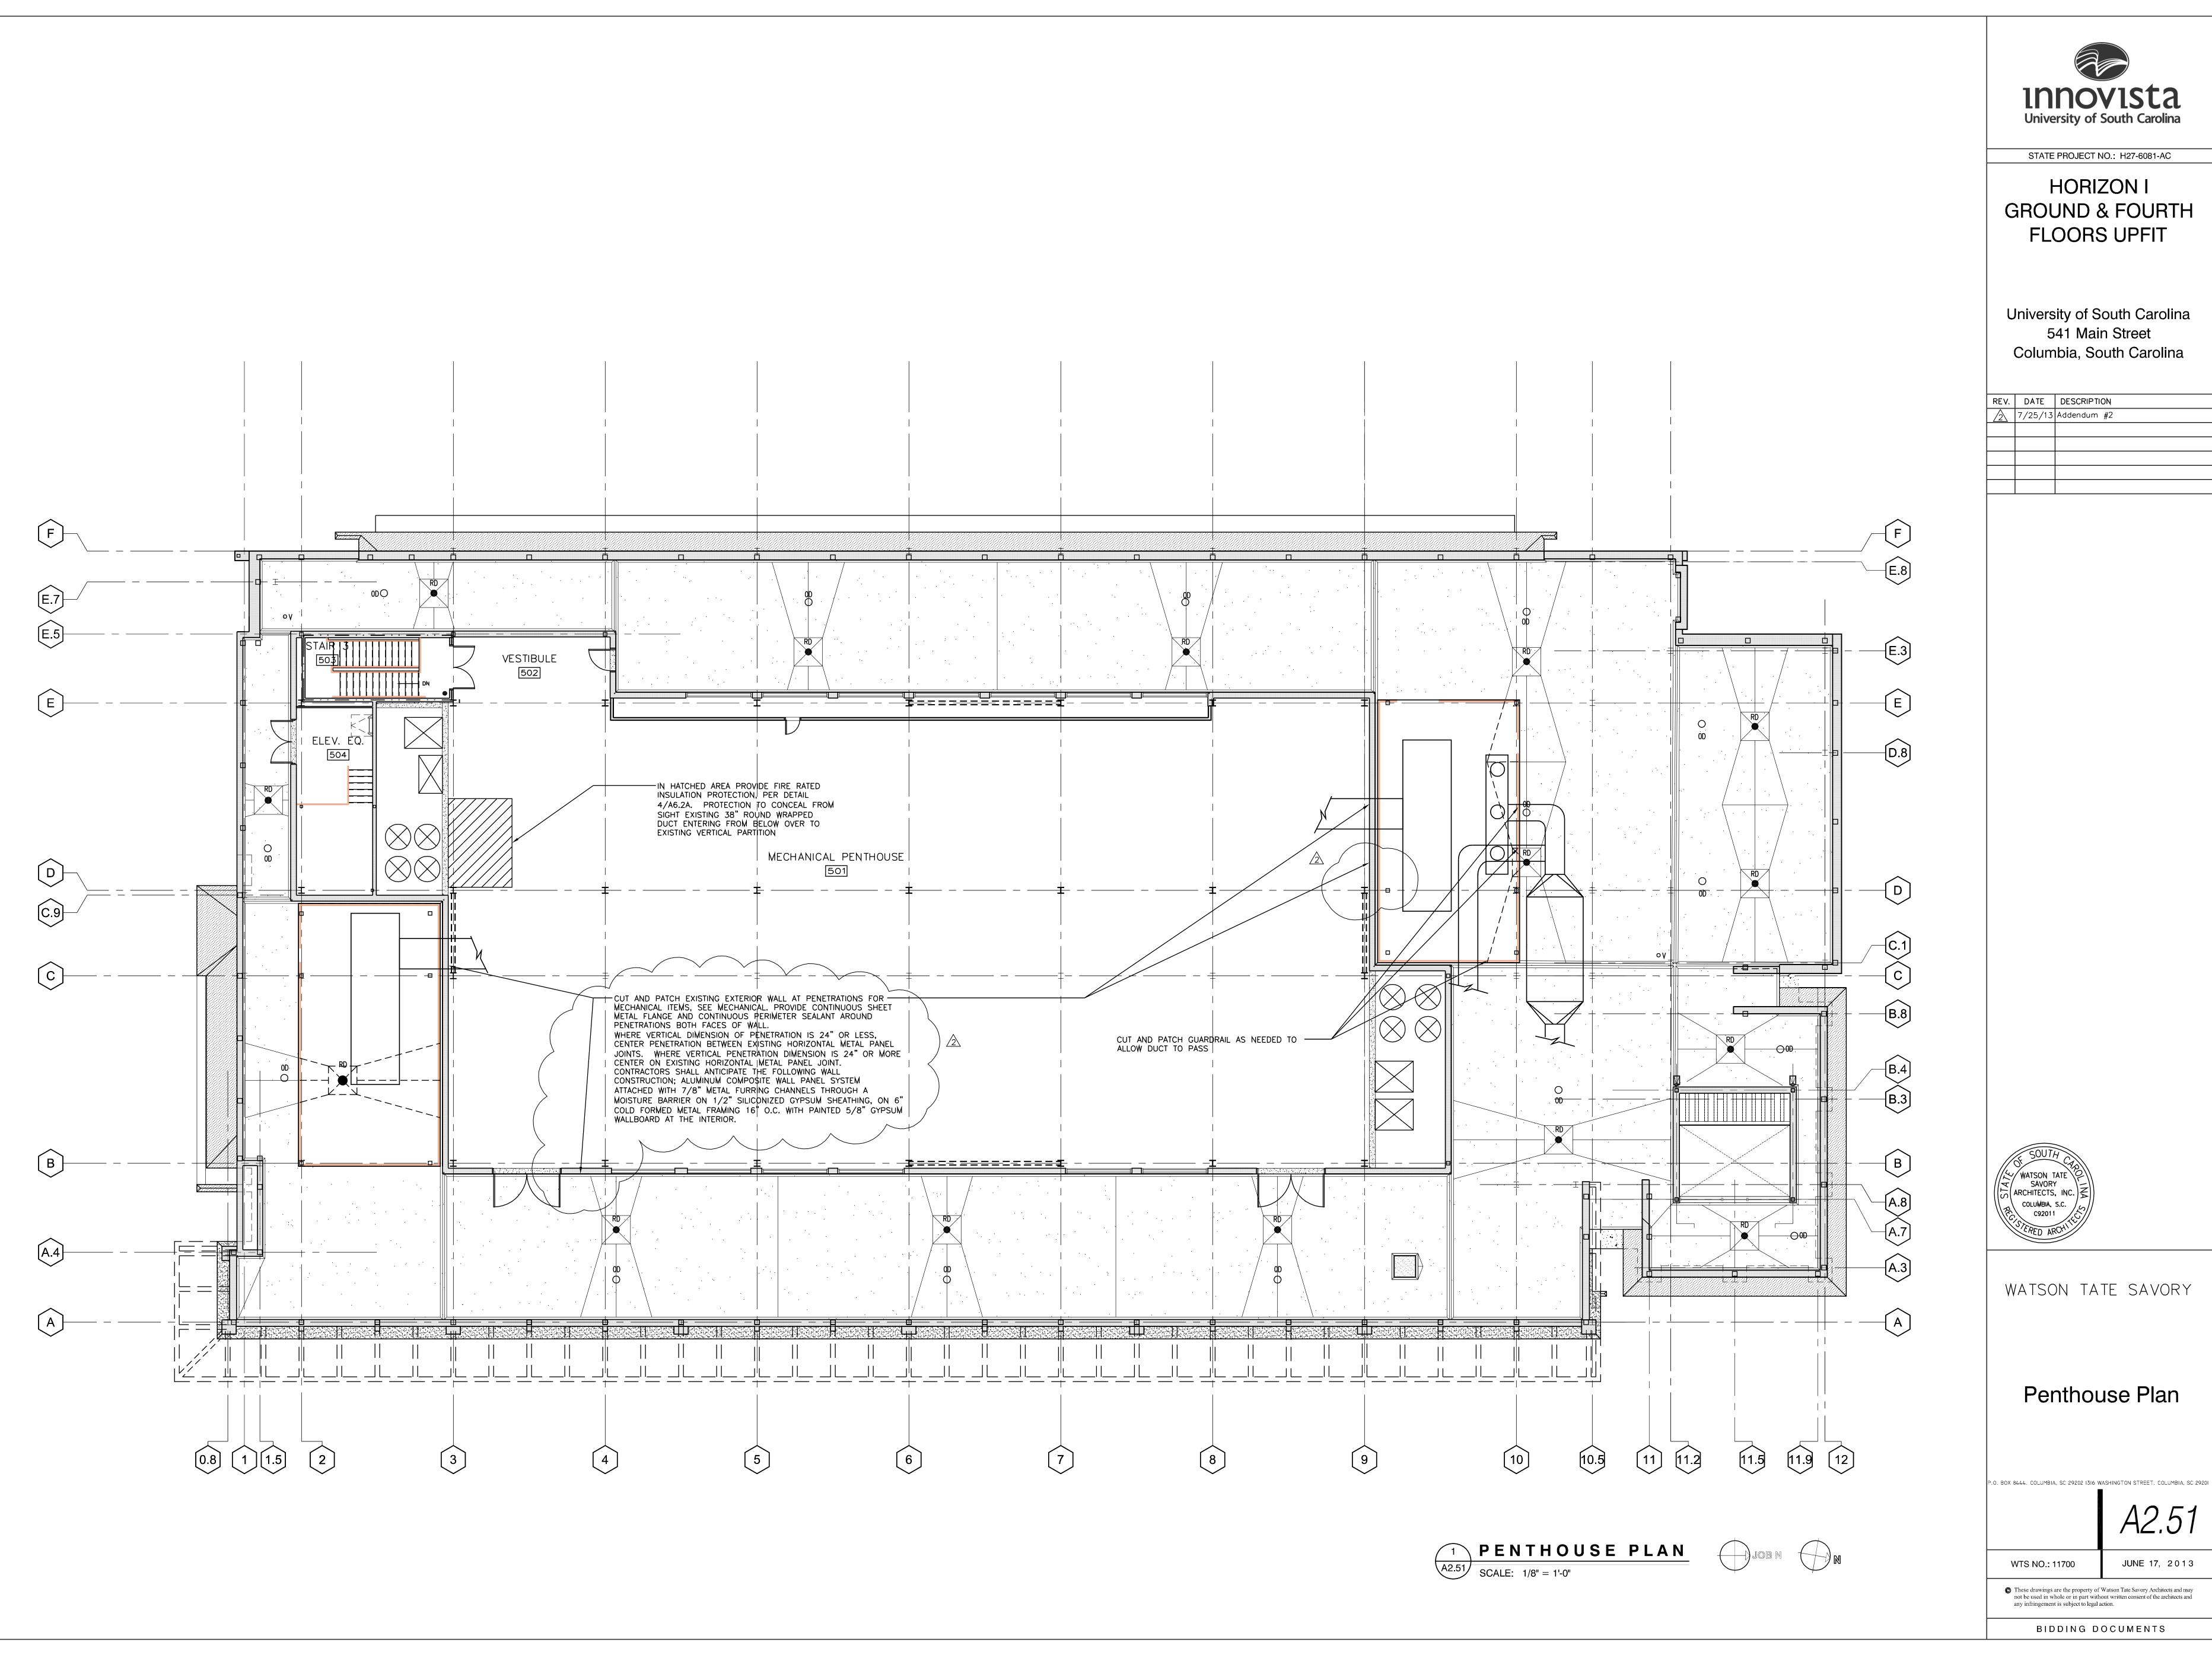

Innovista
University of South Carolina

STATE PROJECT NO.: H27-6081-AC

HORIZON I **GROUND & FOURTH FLOORS UPFIT**

University of South Carolina 541 Main Street Columbia, South Carolina


7/25/13 Addendum #2

WATSON TATE SAVORY

Penthouse Plan


These drawings are the property of Watson Tate Savory Architects and may not be used in whole or in part without written consent of the architects and any infringement is subject to legal action.


BIDDING DOCUMENTS

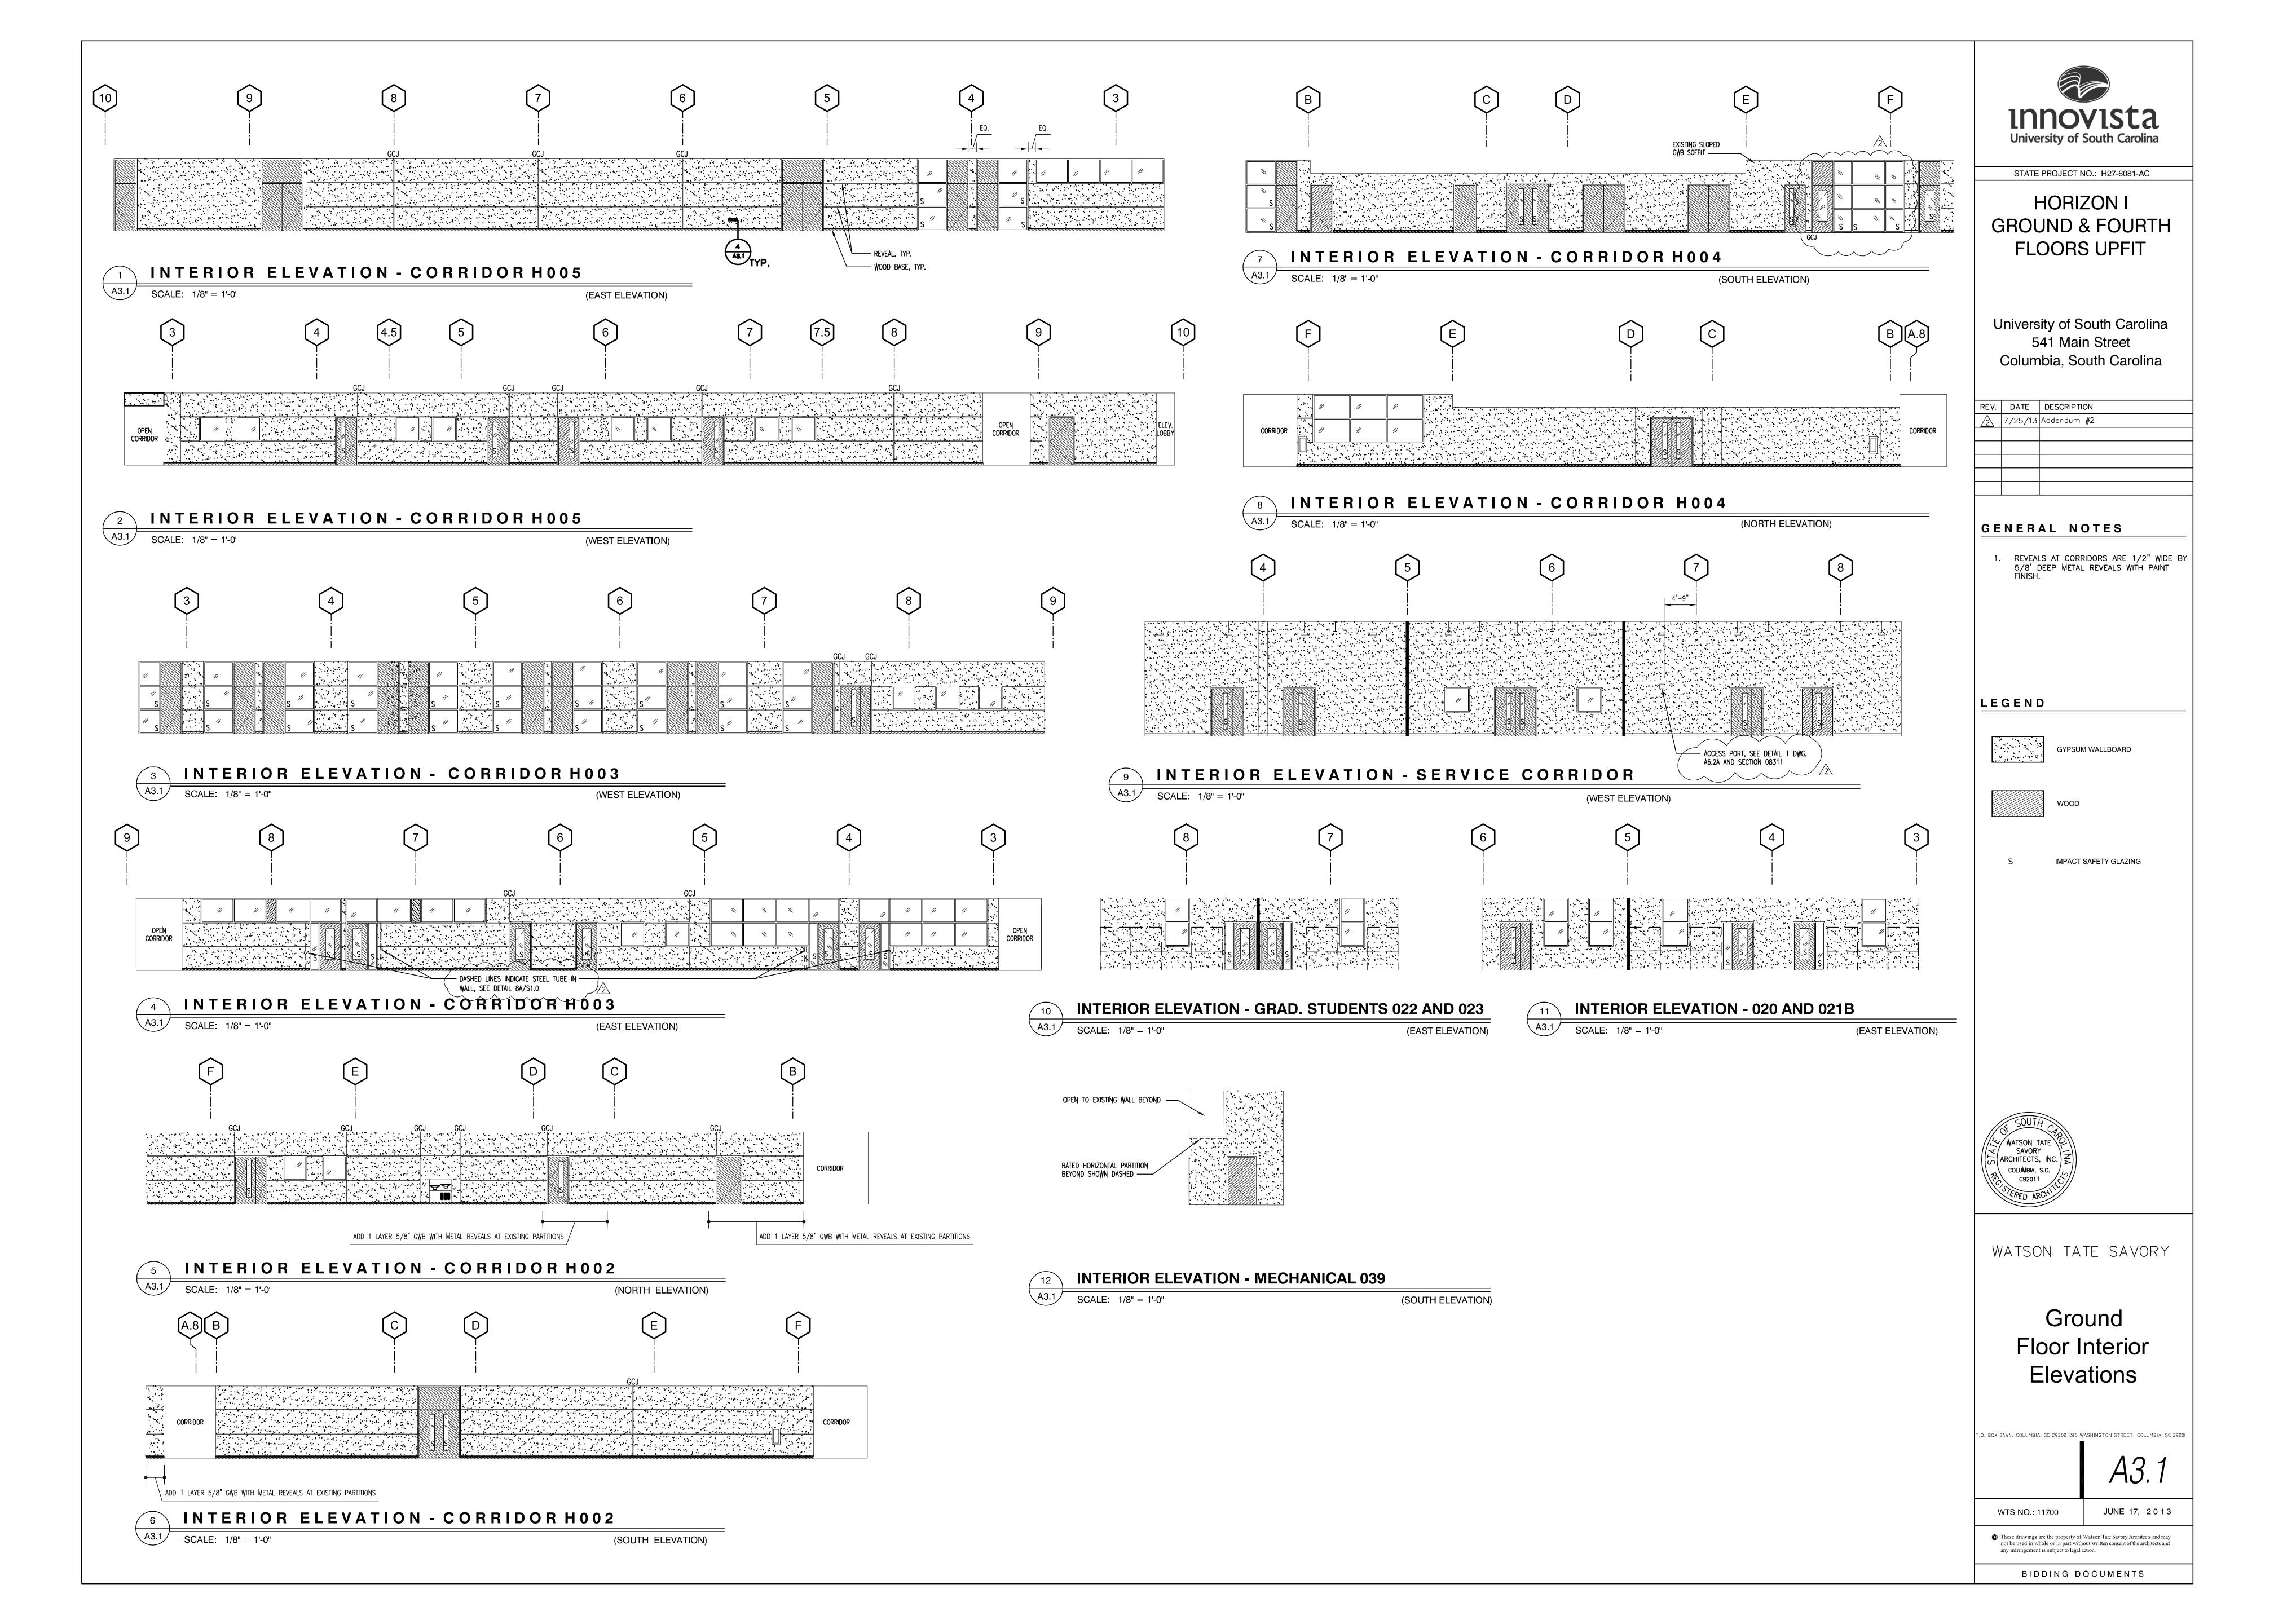


	OOR SC			 				<u> </u>			
DOOR MARK	DOOR SIZE	DOOR TYPE	THK.	MATL.	FINISH	RATING	FRAME TYPE	HEAD	JAMB	SILL	- REMARKS
ST02	3'-0" X 10'-6"	EXISTING	DOOR	•	•	90 MIN.	EXISTING	FRAME	•	EXIST.	
ST03B	3'-0" X 10'-6"	EXISTING	G DOOR				EXISTING	FRAME		EXIST.	
ST03C	3'-0" X 7'-0"	С	1 3/4"	SCW	STAIN	90 MIN.	1	H3	J3	S 3	
V002	PR.(3'-0" X 10'-6")	EXISTING) DOOR	1	l	<u> </u>	EXISTING	FRAME	1	EXIST.	* REMOVE AND REINSTALL EXISTING WALK-OFF MAT AND TRESHOLD TO ACCOMODATE WORK
H004	DD (0 0 V 7 0 V F **)										
H004 H006	PR.(3'-0" X 7'-0" V.I.F. **)	EXISTING		SCW	CTAIN	45 MIN.	1	H1	J 1	\$ 3	** NEW FRAME TO FIT EXISTING DOORS
	PR.(3'-0" X 7'-0")	CC	1 3/4"		STAIN	45 MIN.	1	H 1	J 1	\$ 3	* DOUBLE ECDESS
H006A H007A	PR.(3'-0" X 10'-6") PR.(4'-0" X 7'-0")*	CC	1 3/4"	SCW	STAIN	45 MIN.	1	H 1	J 1	S 1	* DOUBLE EGRESS
H007A	PR.(4'-0" X 7'-0")*	CC	1 3/4"	SCW	STAIN	45 MIN.	1	H 1	J 1	S 1	* DOUBLE EGRESS * DOUBLE EGRESS
H007B	PR.(3'-0" X 10'-6")	EE	1 3/4"	SCW	STAIN STAIN	45 MIN.	1	H 1	J 1	S 1 S 3	DOUBLE EGNESS
					O I / KII V						
001	3'-0" X 10'-6" 3'-0" X 10'-6"	EXISTING				90 MIN.	EXISTING			EXIST.	
002	3'-0" X 10'-6"	EXISTING				90 MIN. 90 MIN.	EXISTING	H 4	J 4	S 3	
		EXISTING	6 DOOR 1 3/4"	SCW	CTVIVI	⊎U IVIIIN.	EXISTING 1	H 4	J 4	\$3	
004	3'-0" X 7'-0"	Α			STAIN		1	H1	J 1	S 2	
005	3'-0" X 7'-0" 4'-6" X 7'-0"	A 	1 3/4"	SCW SCW	STAIN STAIN		'	H1	J 1	S 2	
006 	(UNEVEN PAIR) 4'-6" X 7'-0"	D	1 3/4"	SCW	STAIN	45 MIN.	1	H2	J2	S 3	
007A 007B	(UNEVEN PAIR) ±5'-6" X 7'-0"			PECIFIED SHIELDIN		45 MIN. 	1 FRAME AND D	H 2 DETAILS - T.B.D.	J 2	S 3	SEE SPECIALTY DOOR SPECIFICATION
007B	±5'-6" X 7'-0" 4'-0" X 7'-0"	A	1 3/4"	HM	PNT	90 MIN.	1	H 1	J 1	S 1	MAINTAIN 4'-0" MIN. CLEAR WHEN OPEN 90 DEGREES CONNECT TO FIRE ALARM SYSTEM FOR HOLD OPEN
008	3'-0" X 10'-6"	В	1 3/4"	SCW	STAIN		0.2 (SEE	E A5 SERIES DRAI		S 1	* INTERIOR ALUMINUM STOREFRONT
009	3'-0" X 10'-6"	В	1 3/4"	SCW	STAIN			E A5 SERIES DRAI	•	S 1	* INTERIOR ALUMINUM STOREFRONT
010	3'-0" X 10'-6"	В	1 3/4"	SCW	STAIN			E A5 SERIES DRAI		S 1	* INTERIOR ALUMINUM STOREFRONT
011	3'-0" X 10'-6"	В	1 3/4"	SCW	STAIN			E A5 SERIES DRAI		S 1	* INTERIOR ALUMINUM STOREFRONT
012	3'-0" X 10'-6"	В	1 3/4"	SCW	STAIN			E A5 SERIES DRAI		S 1	* INTERIOR ALUMINUM STOREFRONT
013	3'-0" X 10'-6"	В	1 3/4"	SCW	STAIN			E A5 SERIES DRAI	,	S 1	* INTERIOR ALUMINUM STOREFRONT
014	3'-0" X 10'-6"	В	1 3/4"	SCW	STAIN			E A5 SERIES DRAI		S 1	* INTERIOR ALUMINUM STOREFRONT
015	3'-0" X 10'-6"	В	1 3/4"	SCW	STAIN			E A5 SERIES DRAI	·	S 1	* INTERIOR ALUMINUM STOREFRONT
016	3'-0" X 10'-6"	В	1 3/4"	SCW	STAIN		0.2 (SEE	E A5 SERIES DRAI	WINGS)*	S 1	* INTERIOR ALUMINUM STOREFRONT
017	3'-0" X 10'-6"	В	1 3/4"	SCW	STAIN		0.1 (SEE	E A5 SERIES DRA	WINGS)*	S 1	* INTERIOR ALUMINUM STOREFRONT
018	3'-0" X 10'-6"	B	1 3/4"	SCW	STAIN		0.8 (SEE	A5 SERIES DRA	WINGS)*	S 1	* INTERIOR ALUMINUM STOREFBONT
019	3'-0" X 10'-6"	G	1 3/4"	SCW	STAIN		1	H 1	J 1	S 1	
019A	3'-0" X 10'-6"	G	1 3/4"	SCW	STAIN		(SEE	E A5 SERIES DRA		S 1	* INTERIOR ALUMINUM STOREFRONT
020A	3'-0" X 7'-0"	F	1 3/4"	SCW	STAIN		0.4 (SEE	E A5 SERIES DRAI	WINGS)*	S 1	* INTERIOR ALUMINUM STOREFRONT
020B	3'-0" X 7'-0"	F	1 3/4"	SCW	STAIN		0.4 (SEE	E A5 SERIES DRAI	WINGS)*	S 1	* INTERIOR ALUMINUM STOREFRONT
020C	3'-0" X 7'-0"	F	1 3/4"	SCW	STAIN	45 MIN.	1.3 (SEE	E DRAWING A4.3)	*	S 3	* RATED H.M.
020D	3'-0" X 7'-0"	F	1 3/4"	SCW	STAIN	45 MIN.	1.3 (SEE	E DRAWING A4.3)	*	S 3	* RATED H.M.
021A	3'-0" X 7'-0"	F	1 3/4"	SCW	STAIN	45 MIN.	1	H2	J 2	S 3	
021B	4'-6" X 7'-0" (UNEVEN PAIR)	D	1 3/4"	SCW	STAIN		1	H 1	J 1	S 1	
021E	PR.(3'-0" X 7'-0")	CC	1 3/4"	SCW	STAIN	45 MIN.	1	H 1	J 1	S 1	
021F	3'-0" X 7'-0"	F	1 3/4"	SCW	STAIN	45 MIN.	1	H2	J 2	S 1	
022A	3'-0" X 7'-0"	F	1 3/4"	SCW	STAIN		0.3 (SEE	E A5 SERIES DRA	VINGS)*	S 1	* INTERIOR ALUMINUM STOREFRONT
022B	3'-0" X 7'-0"	F	1 3/4"	SCW	STAIN	45 MIN.	1.3 (SEE	E DRAWING A4.3)	k	S 3	* RATED H.M.
023A	3'-0" X 7'-0"	F	1 3/4"	SCW	STAIN		0.3 (SEE	E A5 SERIES DRA	WINGS)*	S 3	* INTERIOR ALUMINUM STOREFRONT
023B	3'-0" X 7'-0"	F	1 3/4"	SCW	STAIN	45 MIN.	1.3 (SEE	E DRAWING A4.3)	*	S 3	* RATED H.M.
024	PR (3'-0" X 7'-0")	CC	1 3/4"	SCW	STAIN	45 MIN.	1	H 1	J 1	S 1	
025	4'-6" X 7'-0" (UNEVEN PAIR)	D	1 3/4"	SCW	STAIN	45 MIN.	1	H 1	J 1	S 1	
026	4'-6" X 7'-0" (UNEVEN PAIR)	D	1 3/4"	SCW	STAIN	45 MIN.	1	H 1	J 1	S 1	
027	4'-6" X 7'-0" (UNEVEN PAIR)	D	1 3/4"	SCW	STAIN	45 MIN.	1	H 1	J 1	S 1	
028	4'-0" X 7'-0"	F	1 3/4"	SCW	STAIN		1	H 1	J 1	S 1	
029A	4'-6" X 7'-0" (UNEVEN PAIR)	D	1 3/4"	SCW	STAIN	45 MIN.	1	H 1	J 1	S 1	
029B	3'-0" X 7'-0"	С				45 MIN.					<u> </u>


DOOR	DOOD 0175	DOOR	T 1 11/	NAAT!	FINIO	DATINO	FRAME	F	RAME DETAII	_S	DEMARKO
MARK	DOOR SIZE	TYPE	THK.	MATL.	FINISH	RATING	TYPE	HEAD	JAMB	SILL	REMARKS
030A	4'-6" X 7'-0" (UNEVEN PAIR)	D	1 3/4"	SCW	STAIN	45 MIN.	1	H 1	J 1	S 1	
030B	3'-0" X 7'-0"	С	1 3/4"	SCW	STAIN	45 MIN.	1	H2	J2	S 3	
031A	4'-6" X 7'-0" (UNEVEN PAIR)	D	1 3/4"	SCW	STAIN	45 MIN.	1	H 1	J 1	S 1	
031B	3'-0" X 7'-0"	С	1 3/4"	SCW	STAIN	45 MIN.	1	H2	J 2	S 3	
032A	PR.(3'-0" X 7'-0")	CC	1 3/4"	SCW	STAIN	45 MIN.	1	H 1	J 1	S 1	
032B	3'-0" X 7'-0"	С	1 3/4"	SCW	STAIN	45 MIN.	1	H2	J2	S 3	
033	PR.(3'-0" X 7'-0")	EXISTING	DOOR				EXISTING	FRAME		S 3	
033A	3'-0" X 7'-0"	EXISTING	G DOOR				EXISTING	FRAME		EXIST.	
034	PR.(3'-0" X 7'-0")	EXISTING	DOOR				EXISTING	FRAME		S 3	
035A	3'-0" X 7'-0"	EXISTING	DOOR			90 MIN.	EXISTING	FRAME		S 3	
035B	3'-0" X 7'-0"	EXISTING	DOOR			90 MIN.	EXISTING	FRAME		EXIST.	
036	3'-0" X 7'-0"	EXISTING	DOOR			90 MIN.	EXISTING	FRAME		S 3	
037A	3'-0" X 10'-6"	В	1 3/4"	SCW	STAIN		0.2 (SE	EE A5 SERIES DRA	AWINGS)*	S 1	* INTERIOR ALUMINUM STOREFRONT
037B	3'-0" X 10'-6"	В	1 3/4"	SCW	STAIN		0.2 (SE	EE A5 SERIES DRA	AWINGS)*	S 1	* INTERIOR ALUMINUM STOREFRONT
038	3'-0" X 10'-6"	В	1 3/4"	SCW	STAIN		0.2 (SE	EE A5 SERIES DRA	AWINGS)*	S 1	* INTERIOR ALUMINUM STOREFRONT
039A	PR.(3'-0" X 10'-6")	EXISTING	DOOR		_	45 MIN.	EXISTING	H 4	J 4	S 3	
039B	PR.(3'-0" X 10'-6")	EXISTING	DOOR			45 MIN.	EXISTING	FRAME	I	S 3	
040	4'-0" X 7'-0"	Δ	1 3/4"	НМ	PNT	45 MIN.	1	H 1	J 1	S 1	

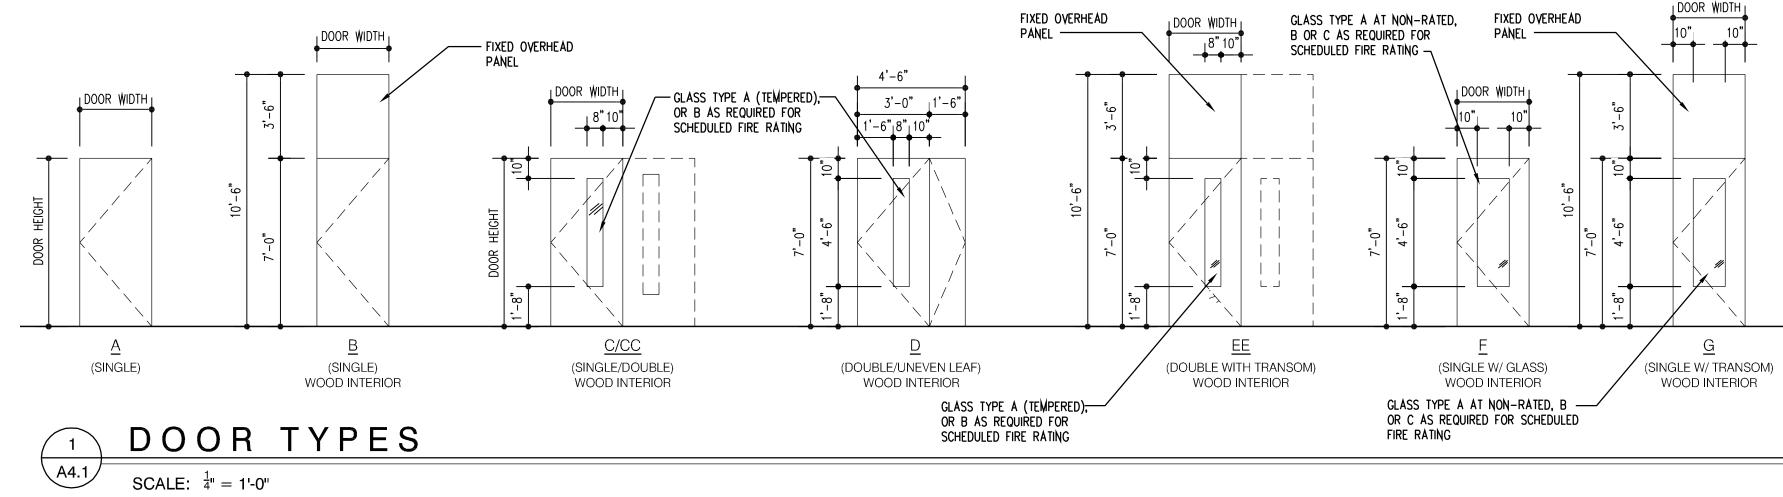

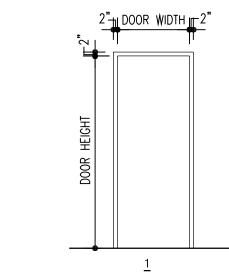

SCALE: $\frac{1}{4}$ " = 1'-0"

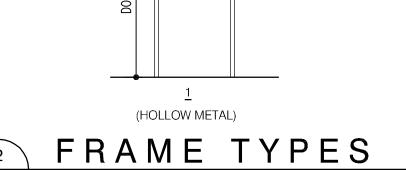

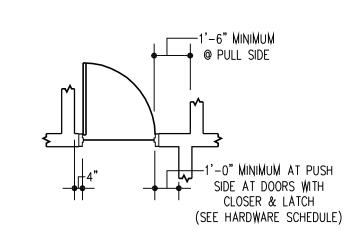

TYPICAL DOOR $\begin{array}{|c|c|c|c|c|c|}\hline & L & O & C & A & T & I & O & N \\\hline \hline A4.1 & SCALE: & \frac{1}{4}" & = 1'-0" & & & \\ \hline \end{array}$



STATE PROJECT NO.: H27-6081-AC

HORIZON I **GROUND & FOURTH FLOORS UPFIT**

University of South Carolina 541 Main Street Columbia, South Carolina

REV.	DATE	DESCRIPTION
2	7/25/13	Addendum #2

NOTES:

- YENEER AT DOOR AND FIXED OVERDOOR PANELS TO BE OF ONE CONTINUOUS PIECE (TYP.)
- PROVIDE GLASS TYPE AT DOORS AS REQUIRED TO MEET SPECIFIED RATING
- 3. ALL HOLLOW METAL FRAMES TO HAVE PAINT FINISH.

GLASS SCHEDULE:

- A 1/4" CLEAR (TEMPERED WHERE NOTED W/ "T")
- B 45 MINUTE FIRE RATED C 90 MINUTE FIRE RATED
- D 120 MINUTE FIRE RATED



WATSON TATE SAVORY


Ground Floor Door Schedule & Types

O. BOX 8444. COLUMBIA, SC 29202 1316 WASHINGTON STREET. COLUMBIA, SC 29201

JUNE 17, 2013 WTS NO.: 11700

These drawings are the property of Watson Tate Savory Architects and may not be used in whole or in part without written consent of the architects and any infringement is subject to legal action.

BIDDING DOCUMENTS

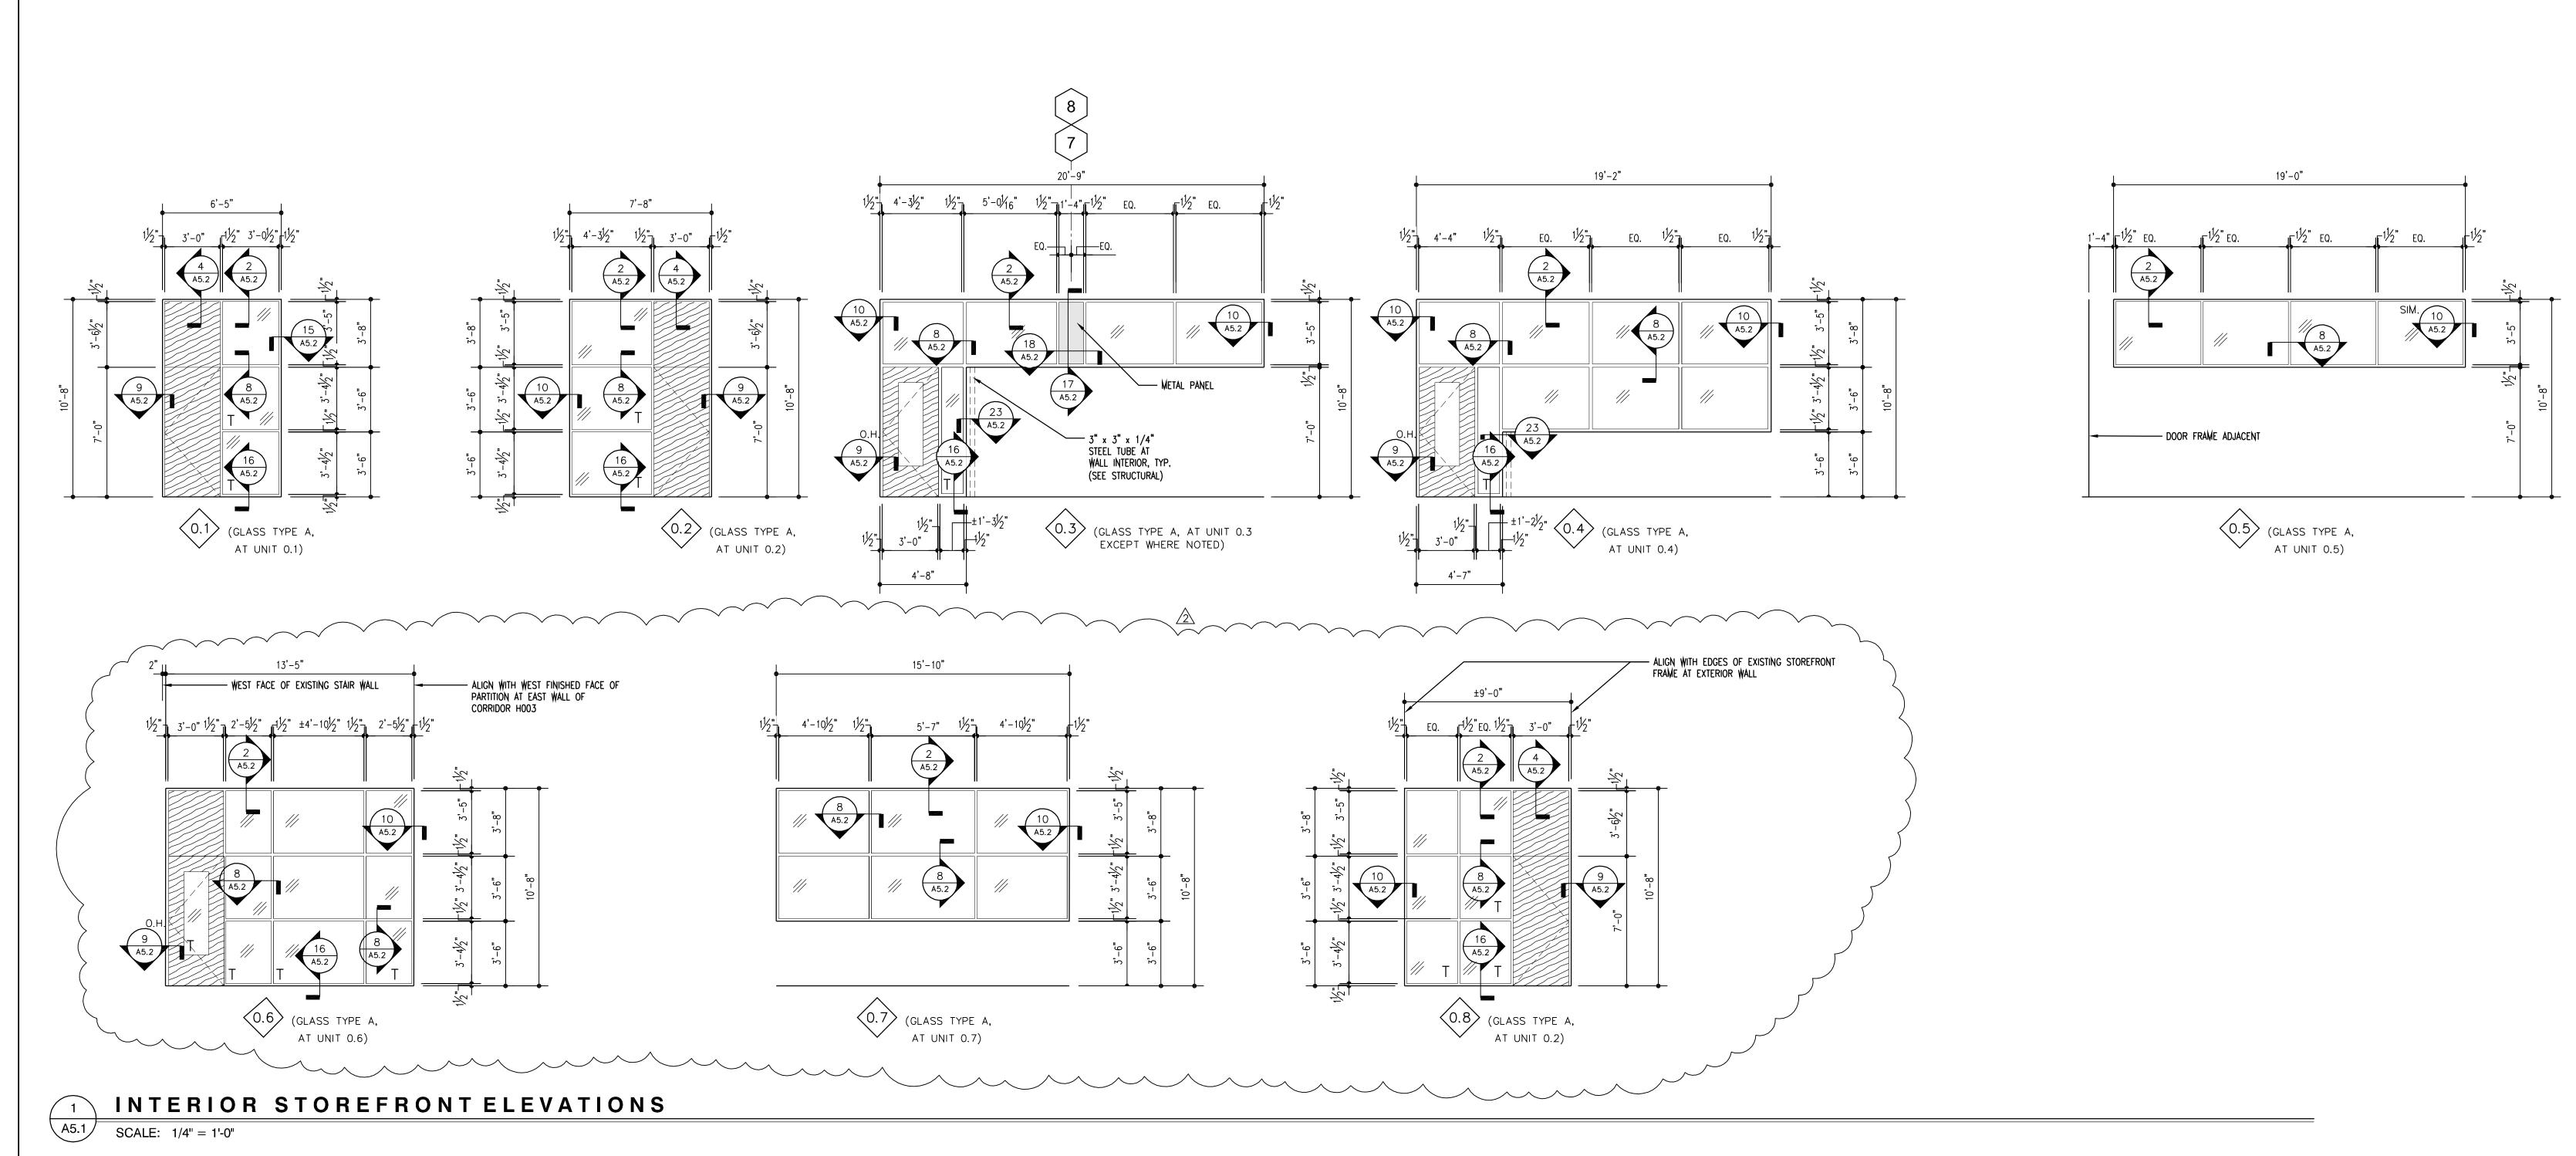



STATE PROJECT NO.: H27-6081-AC

HORIZON I GROUND & FOURTH FLOORS UPFIT

University of South Carolina 541 Main Street Columbia, South Carolina

REV. DATE DESCRIPTION

7/25/13 Addendum #2

GLASS SCHEDULE:

 \triangle 1/4" CLEAR (TEMPERED WHERE NOTED W/ "T")

GENERAL NOTES

- 1. FIELD VERIFY ALL OPENING DIMENSIONS.
- 2. SEE FLOOR PLANS FOR INTERIOR STOREFRONT SYMBOL: .
- 3. ALL UNITS THIS DRAWING TO BE GLASS TYPE
 "A" PROVIDE TEMPERED GLASS WHERE
 NOTED WITH "T" DESIGNATION AT ELEVATIONS.

WATSON TATE
SAVORY
ARCHITECTS, INC.
COLUMBIA, S.C.
C92011

WATSON TATE SAVORY

Ground Floor Interior Storefront Elevations

P.O. BOX 8444. COLUMBIA, SC 29202 1316 WASHINGTON STREET. COLUMBIA, SC 29201

A5.1

WTS NO.: 11700 JUNE 17, 2013

These drawings are the property of Watson Tate Savory Architects and may not be used in whole or in part without written consent of the architects and any infringement is subject to legal action.

BIDDING DOCUMENTS

INTERIOR STOREFRONT ELEVATIONS 7/24/2013 2:17:01 PI

MOOS	D00// \1///E	El 0.0D	DAGE		PLAN	WALLS	T	CEILING		DELLADAO
NO.	ROOM NAME	FLOOR	BASE	NORTH	EAST	SOUTH	WEST	MATL.	HGT.	REMARKS
T101	STAIR 1	EXIST. PRECAST		EXIST. STEEL/GLASS	EXIST. STEEL/GLASS	EXIST. STEEL/GLASS	EXIST. STEEL/GLASS			* TOUCH UP OR REPAINT AFTER CONSTRUCTION AS
T102	STAIR 2	EXIST. RUBBER	EXIST. RUBBER	EXIST. GWB	EXIST. GWB	EXIST. GWB	EXIST. GWB			* TOUCH UP OR REPAINT AFTER CONSTRUCTION AS
T103	STAIR 3	EXIST. RUBBER	EXIST. RUBBER	EXIST. PAINT * EXIST. GWB	EXIST. PAINT * EXIST. GWB	EXIST. PAINT * EXIST. GWB	EXIST. PAINT * EXIST. GWB			* TOUCH UP OR REPAINT AFTER CONSTRUCTION AS
				EXIST. PAINT *	EXIST. PAINT *	EXIST. PAINT *	EXIST. PAINT *			
		EXIST. PT	EXIST. WOOD	EXIST. GWB/WOOD/ALUM.	EXIST, GWB/WOOD/ALUM.	EXIST. GWB/WOOD/ALUM.	EXIST. GWB/WOOD/ALUM.	EXIST. GWB/WOOD	±58'-8" &	
1100	LOBBY	EXIST. PT	EXIST. STAIN *	EXIST, SP. PNT/STAIN/-* EXIST. GWB	EXIST. SP. PNT/STAIN/-*	EXIST. SP. PNT/STAIN/-*	EXIST. SP. PNT/STAIN/-*	EXIST. SP, PNT/STAIN*	±57'-8"	* TOUCH UP OR REPAINT AFTER CONSTRUCTION AS
H101	ELEVATOR LOBBY		EXIST. WOOD EXIST. STAIN *	EXIST. SP. PAINT *	EXIST. GWB EXIST. SP. PAINT *	EXIST. GWB EXIST. SP. PAINT *	EXIST. GWB EXIST. SP. PAINT *	EXIST. ACT/EXIST.G\(\psi\)B EXIST. 2X2/PAINT *	±13'-4" & ±12'-0"	* TOUCH UP OR REPAINT AFTER CONSTRUCTION AS
1102	CORRIDOR	PT-1 ——	WOOD STAIN	GWB SP PNT-9*	GWB SP PNT-11*	GWB SP PNT-12*	GWB SP PNT-12*	ACT-1 2X2	13'-4"	* SEE PAINT PLAN THIS DRAWING
1103	CORRIDOR	PT-1 ——	WOOD STAIN	GWB SP PNT-9*		GWB SP PNT-12*		ACT-1 2X2	13'-4"	* SEE PAINT PLAN THIS DRAWING
104	CORRIDOR	PT-1	WOOD STAIN	GWB SP PNT-13*	GWB SP PNT-10/SP PNT 9*	GWB SP PNT-11*	GWB SP PNT-13*	ACT-1 2X2	13'-4"	* SEE PAINT PLAN THIS DRAWING
105	CORRIDOR	CPT-1	RUBBER	GWB	GWB	G₩B	GWB	ACT-1	10'-8"	* SEE PAINT PLAN THIS DRAWING
106	CORRIDOR	CPT-1	RUBBER	SP PNT-11/SP PNT 14* GWB	SP PNT-11*	SP PNT-13*	SP PNT-13*	2X2 ACT-1	10'-8"	* SEE PAINT PLAN THIS DRAWING
106		CPT-1		SP PNT-11*		SP PNT-13*		2X2 ACT-1		* SEE PAINT PLAN THIS DRAWING
07	CORRIDOR			SP PNT-11*	SP PNT-9*		SP PNT-10/SP PNT 11*	2X2	10'-8"	* SEE PAINT PLAN THIS DRAWING
108	CORRIDOR	<u>CPT-1</u>	RUBBER	GWB SP PNT-11*	GWB SP PNT-9*	GWB SP PNT-11*	GWB SP PNT-10*	ACT-1 2X2	10'-8"	* SEE PAINT PLAN THIS DRAWING
109	SERVICE CORRIDOR	CONCRETE SEAL	RUBBER	GWB PNT-6	GWB PNT-6	GWB PNT-6	GWB PNT-6	STRUCTURE	±18'-2"	* EXPOSED PIPES & CONDUITS TO REMAIN UNPAINT EXCEPT FOR FIRE SPRINKLER PIPING SPEC'D. AT I
10	SERVICE CORRIDOR	CONCRETE	RUBBER	GWB PNT-6	GWB PNT-6	G₩B	GWB	STRUCTURE	±18'-2"	* EXPOSED PIPES & CONDUITS TO REMAIN UNPAINT EXCEPT FOR FIRE SPRINKLER PIPING SPEC'D, AT I
11	SERVICE CORRIDOR	CONCRETE	RUBBER	GWB	GWB	PNT-6 GWB	PNT-6 GWB	STRUCTURE	±18'-2"	* EXPOSED PIPES & CONDUITS TO REMAIN UNPAINT
		SEAL		PNT-6	PNT-6	PNT-6	PNT-6			EXCEPT FOR FIRE SPRINKLER PIPING SPEC'D, AT
		CPT-1	WOOD	GWB	GWB	GWB	GWB	ACT-1		
01	VESTIBULE		STAIN	SP PNT 12	SP PNT 12	SP PNT 12	SP PNT 12	2X2	9'-4"	* TOUCH UP OR REPAINT AFTER CONSTRUCTION AS
02	ELEVATOR VESTIBULE	VCT-1	RUBBER ———	GWB SP PNT 11	GWB SP PNT 11	GWB SP PNT 11	GWB SP PNT 11	ACT-1 2X2	10'-8"	
				2						
D1	ELEVATOR 01	EXISTING ELEVATOR	SHAFT AND CAB							
 02	FUTURE ELEVATOR 02	EXISTING SHAFT FOR	FUTURE ELEVATOR (:AB						
	FLEWATOR OZ	EVICTING FLEWATOR	CHAFT A. CAD							
D3	ELEVATOR 03	EXISTING ELEVATOR								
		77.4		2	Tues of s		Towar alla			
)1	DISPLAY	PT-1 ——	RUBBER ———	EXIST. GWB EXIST. PNT *	EXIST. GWB EXIST. PNT *	EXIST. GWB EXIST. PNT *	EXIST. GWB EXIST. PNT *	GWB EXIST. PNT*	±10'-2"	* TOUCH UP OR REPAINT AFTER CONSTRUCTION AS
2	JANITOR	EXIST. CONCRETE	EXIST. RUBBER	EXIST. G\(\psi\)B EXIST. PNT *	EXIST. GWB EXIST. PNT *	EXIST. GWB EXIST. PNT *	EXIST. GWB EXIST. PNT *	ACT-1**	±10'-8"	* TOUCH UP OR REPAINT AFTER CONSTRUCTION A ** REPLACE EXISTING CEILING TILES
3	CONFERENCE ROOM	CPT-3	WOOD STAIN	GWB	GWB	GWB	GWB	ACT-1/GWB 2X2 / PNT-7	13'-4"/ 14'-0"	
)4	IDEA DRY LAB	VCT-1/VCT-2	RUBBER	PNT-1 GWB	PNT-3 GWB	PNT-4 GWB	PNT-3 GWB	ACT-2	13'-4"	
		VCT-1/VCT-2	RUBBER	PNT-1 GWB	PNT-2 GWB	PNT-4 GWB	PNT-2 GWB	2X2 / 1X2 ACT-2	13'-4"	
5	IDEA DRY LAB			PNT-1 GWB	PNT-2 GWB	PNT-4 GWB	PNT-2 GWB	2X2 / 1X2 ACT-2	-	
6	IDEA DRY LAB	<u> </u>		PNT-1	PNT-2	PNT-4	PNT-2	2X2 / 1X2	13'-4"	
7	MEN	PT-2	PT	CT*		CT*	CT*	ACT-1/GWB 2X2 / PNT-7	9'-4"	* 8X8 CT TYPICAL: 2X2 AT SINK WALL (SEE SHEET A7.2 FOR ELEVATIONS)
8	WOMEN	PT-2	PT	CT*	CT*	CT*	CT*	ACT-1/GWB 2X2 / PNT-7	9'-4"	* 8X8 CT TYPICAL: 2X2 AT SINK WALL (SEE SHEET A7.2 FOR ELEVATIONS)
9	WORKROOM Z	CPT-1	WOOD	GWB	GWB	GWB	GWB	ACT-1	10'-8"	
	VENDING	PT-1	STAIN WOOD	PNT-2 GWB	PNT-2 GWB	PNT-3 GWB	PNT-2 GWB	2X2 ACT-1	10'-0"	4
0			STAIN RUBBER	SP PNT 10 GWB	SP PNT 10 GWB	SP PNT 10 GWB	SP PNT 10 GWB	2X2 ACT-1		V
A	OFFICE			PNT-1	PNT-3	PNT-1	PNT-1	2X2	10'-8"	
В	IDEA LAB	EXIST. CONCRETE SEAL	RUBBER*	GWB PNT-2	GWB PNT-5	GWB PNT-2	GWB PNT-3	ACT-2 2X2 / 1X2	10'-8"	* PROVIDE RUBBER BASE AT FIXED LAB CASEWORK AREA
?A	OFFICE	CPT-2	RUBBER	GWB PNT-1	GWB PNT-3	GWB PNT-1	GWB PNT-1	ACT-1 2X2	10'-8"	
?B	IDEA LAB	EXIST. CONCRETE	RUBBER*	GWB	GWB	GWB	GWB	ACT-2 2X2 / 1X2	10'-8"	* PROVIDE RUBBER BASE AT FIXED LAB CASEWORK AREA
5A	OFFICE	SEAL CPT-2	RUBBER	PNT-2 GWB	PNT-5 GWB	PNT-2 GWB	PNT-3 GWB	ACT-1	10'-8"	
		EXIST. CONCRETE	RUBBER*	PNT-1 GWB	PNT-3 GWB	PNT-1 GWB	PNT-1 GWB	2X2 ACT-2		* PROVIDE RUBBER BASE AT FIXED LAB CASEWORK
3B	IDEA LAB	SEAL CPT-2		PNT-2 GWB	PNT-5 GWB	PNT-2 GWB	PNT-3 GWB	2X2 / 1X2 ACT-1	10'-8"	AREA
A	OFFICE *			PNT-1	PNT-3	PNT-1	PNT-1	2X2	10'-8"	* BASE BID 2: DELETE CARPET, BASE, ACT & FINI PROVIDE PRIME COAT ONLY AT WALLS.
ŀΒ	IDEA LAB *	EXIST. CONCRETE SEAL	RUBBER**	GWB PNT-2	GWB PNT-5	GWB PNT-2	GWB PNT-3	ACT-2 2X2 / 1X2	10'-8"	* BASE BID 2: DELETE CARPET, BASE, ACT & FINISH PAIN PROVIDE PRIME COAT ONLY AT WALLS. ** PROVIDE RUBBER BASE AT FIXED LAB CASEWORK TOE /
δA	OFFICE *	CPT-2	RUBBER	GWB PNT-1	GWB PNT-3	GWB PNT-1	GWB PNT-1	ACT-1 2X2	10'-8"	* BASE BID 2: DELETE CARPET, BASE, ACT & FINIS PROVIDE PRIME COAT ONLY AT WALLS.
БВ	IDEA LAB *	EXIST. CONCRETE	RUBBER**	GWB	GWB	G₩B	GWB	ACT-2	10'-8"	* BASE BID 2: DELETE CARPET, BASE, ACT & FINISH PAIN PROVIDE PRIME COAT ONLY AT WALLS.
	OFFICE *	SEAL CPT-2	RUBBER	PNT-2 GWB	PNT-5 GWB	PNT-2 GWB	PNT-3 GWB	2X2 / 1X2 ACT-1	10'-8"	** PROVIDE RUBBER BASE AT FIXED LAB CASEWORK TOE A * BASE BID 2: DELETE CARPET, BASE, ACT & FINIT
		EXIST, CONCRETE		PNT-1 GWB	PNT-3 GWB	PNT-1 GWB	PNT-1 GWB	2X2 ACT-2		PROVIDE PRIME COAT ONLY AT WALLS. * BASE BID 2: DELETE CARPET, BASE, ACT & FINISH PAIN
SB	IDEA LAB *	SEAL		PNT-2	PNT-5	PNT-2	PNT-3	2X2 / 1X2	10'-8"	PROVIDE PRIME COAT ONLY AT WALLS. ** PROVIDE RUBBER BASE AT FIXED LAB CASEWORK TOE A
7A	OFFICE *	CPT-2	RUBBER	GWB PNT-1	GWB PNT-3	GWB PNT-1	GWB PNT-1	ACT-1 2X2	10'-8"	* BASE BID 2; DELETE CARPET, BASE, ACT & FINI PROVIDE PRIME COAT ONLY AT WALLS.
7B	IDEA LAB *	EXIST. CONCRETE SEAL	RUBBER**	GWB PNT-2	GWB PNT-5	GWB PNT-2	GWB PNT-3	ACT-2 2X2 / 1X2	10'-8"	* BASE BID 2: DELETE CARPET, BASE, ACT & FINISH PAIN PROVIDE PRIME COAT ONLY AT WALLS. ** PROVIDE RUBBER BASE AT FIXED LAB CASEWORK TOE
BA	OFFICE	CPT-2	RUBBER	GWB	GWB		GWB	ACT-1	10'-8"	I NOTIDE NODDEN DASE AT TIXED LAD CASEMURK THE
 BB	CHEMISTRY LAB *	EXIST, CONCRETE	RUBBER**	PNT-1 GWB	PNT-3 GWB	GWB	PNT-1 GWB	2X2 / 1X2 ACT-2	10'-8"	* BASE BID 2: DELETE CARPET, BASE, ACT & FINISH PAIN PROVIDE PRIME COAT ONLY AT WALLS,
		SEAL CPT-2		PNT-2	PNT-5 GWB	PNT-2	PNT-3 GWB	2X2 ACT-1		PROVIDE PRIME COAT ONLY AT WALLS, ** PROVIDE RUBBER BASE AT FIXED LAB CASEWORK TOE A
	OFFICE		וויייין		PNT-3		PNT-1	2X2	10'-8"	
)A	OTTIOL	EXIST, CONCRETE	RUBBER**	GWB	GWB	GWB	GWB	ACT-2		* BASE BID 2: DELETE CARPET, BASE, ACT & FINISH PAIN

ROOM					PLAN	WALLS		CEILIN	G	
NO.	ROOM NAME	FLOOR	BASE	NORTH	EAST	SOUTH	WEST	MATL.	HGT.	REMARKS
120A	OFFICE	CPT-2	RUBBER		GWB PNT-3	GWB PNT-1	GWB PNT-1	ACT-1 2X2	10'-8"	
120B	PM-IRAS	EXIST. CONCRETE	RUBBER*	GWB	GWB	GWB	GWB	ACT-2	10'-8"	* PROVIDE RUBBER BASE AT FIXED LAB CASEWOR
1200		SEAL		PNT-2	PNT-5	PNT-2	PNT-3	2X2 / 1X2	10-8	AREA
121	BREAKOUT 3	(vcŤ	WOOD STAIN	G WB SP PNT-13*	GWB SP PNT-11*	GWB SP PNT-11*	GWB SP PNT-13 & SP PNT-14*	ACT-1 2X2	10'-8"	* SEE PAINT PLAN
		EXIST. CONCRETE	EXIST. RUBBER	EXIST. GWB	EXIST. GWB	EXIST. GWB	EXIST. GWB	STRUCTURE		
122	ELECTRICAL			EXIST. PNT*	EXIST. PNT*	EXIST. PNT*	EXIST. PNT*		±18'-2"	
123	CHASE	EXIST. CONCRETE		EXIST. GWB*	EXIST. G\\B*	EXIST. GWB*	EXIST. G\(\psi\)B*			* TOUCH UP OR REPAINT AFTER CONSTRUCTION
		EXIST. CONCRETE		EXIST. GWB*	EXIST. GWB*	EXIST. G\(\bar{W}\)B*	EXIST. GWB*			
123A	CHASE	———		EXIST. GγγΒ*	EXIST. GYVB*		——————————————————————————————————————			* TOUCH UP OR REPAINT AFTER CONSTRUCTION
104	CTODAGE	EXIST. CONCRETE	RUBBER	GWB	G₩B	EXIST. GWB	EXIST. GWB	ACT	40' 0"	
124	STORAGE	SEAL		PNT-6	PNT-6	PNT-6	PNT-6	2X2	10'-8"	
125	CHASE	EXIST. CONCRETE		EXIST. GWB*	EXIST. G\\B*	EXIST. GWB*	EXIST. G\(\psi\)B*			* TOUCH UP OR REPAINT AFTER CONSTRUCTION
		EVICT COMODETE		EVICT CIMD+	EVICT OUD+	EVICT OUD+	EVICT OWD*			
125A	CHASE	EXIST. CONCRETE		EXIST. GWB*	EXIST. GWB*	EXIST. G\(\psi\)B*	EXIST. G\(\psi\)B*			* TOUCH UP OR REPAINT AFTER CONSTRUCTION
100	IDEA LAD	EXIST. CONCRETE	RUBBER*	GWB	GWB	G₩B	GWB	ACT-2	40' 0"	* PROVIDE RUBBER BASE AT FIXED LAB CASEWO
126	IDEA LAB	SEAL		PNT-2	PNT-3	PNT-2	PNT-5	2X2 / 1X2	10'-8"	AREA
127	IDEA LAB	EXIST. CONCRETE	RUBBER*	GWB	GWB	GWB	GWB	ACT-2	10'-8"	* PROVIDE RUBBER BASE AT FIXED LAB CASEWO
		SEAL FYIST CONCRETE	DURRED*	PNT-2	PNT-3	PNT-2 GWB	PNT-5 GWB	2X2 / 1X2 ACT-2		AREA
128	IDEA LAB	EXIST. CONCRETE SEAL	RUBBER*	GWB PNT-2	GWB PNT-3	PNT-2	PNT-5	2X2 / 1X2	10'-8"	* PROVIDE RUBBER BASE AT FIXED LAB CASEWO AREA
100	CHADACTEDIZATION : 15	EXIST. CONCRETE	RUBBER*	GWB	GWB	GWB	GWB	ACT-2	10' 0"	* PROVIDE RUBBER BASE AT FIXED LAB CASEWO
129	CHARACTERIZATION LAB	SEAL		PNT-2	PNT-3	PNT-2	PNT-5	2X2 / 1X2	10'-8"	AREA
130	WET CHEMISTRY LAB	EXIST. CONCRETE	RUBBER*	G₩B	GWB	GWB	GWB	ACT-2	10'-8"	* PROVIDE RUBBER BASE AT FIXED LAB CASEWO
		SEAL EVIST CONCRETE	DI IDDED*	PNT-2	PNT-3	PNT-2	PNT-5	2X2 / 1X2		AREA
131	HT LAB	EXIST. CONCRETE SEAL	RUBBER*	GWB PNT-2	GWB PNT-3	G₩B PNT-2	GWB PNT-5	ACT-2 2X2 / 1X2	10'-8"	* PROVIDE RUBBER BASE AT FIXED LAB CASEWO AREA
170	CHACE	EXIST. CONCRETE		EXIST. GWB*	EXIST. GWB*	EXIST. GWB*	EXIST. G\(\psi\)B*			+ TOUGH UP OF PERMIT AFTER CONCERNOS.
132	CHASE									* TOUCH UP OR REPAINT AFTER CONSTRUCTION
133	CONFERENCE	CPT-3	RUBBER	GWB	GWB	GWB	GWB	ACT-1/GWB	10'-8"	
		EXIST. CONCRETE	EXIST. RUBBER	PNT-3 EXIST. GWB	PNT-1 EXIST. GWB	PNT-1 EXIST. GWB	PNT-1 EXIST. GWB	2X2/PAINT STRUCTURE		
134	DATA	EXIST. CONCRETE		EXIST. GWB EXIST. PNT*	EXIST. GWB EXIST. PNT*	EXIST. PNT*	EXIST. GYYB		±18'-2"	* TOUCH UP OR REPAINT AFTER CONSTRUCTION
175	DIDECTOR'S OFFICE	CPT-2	RUBBER	G₩B	GWB	G₩B	GWB	ACT-1	10'-8"	
135	DIRECTOR'S OFFICE		<u>/2</u> —	PNT-1	PNT-3	PNT-1	PNT-1	2X2	10 -8	
136	OFFICE	CPT-2	RUBBER	GWB	GWB	GWB	GWB	ACT-1	10'-8"	
		——————————————————————————————————————	RUBBER	PNT-1 GWB	PNT-3 GWB	PNT-1 GWB	PNT-1 GWB	2X2 ACT-1		
137	OFFICE	——————————————————————————————————————		PNT-1	PNT-3	PNT-1	PNT-1	2X2	10'-8"	
170	OFFICE	CPT-2	RUBBER	GWB	GMB	G₩B	GWB	ACT-1	10'-8"	
138	OFFICE			PNT-1	PNT-3	PNT-1	PNT-1	2X2	10 -0	
139	OFFICE	CPT-2	RUBBER	GWB	GWB	GWB	GWB	ACT-1	10'-8"	
		——————————————————————————————————————	RUBBER	PNT-1 GWB	PNT-3 GWB	PNT-1 GWB	PNT-1 GWB	2X2 ACT-1		
140	OFFICE	———		PNT-1	PNT-3	PNT-1	PNT-1	2X2	10'-8"	
141	OFFICE	CPT-2	RUBBER	GWB	G₩B	G₩B	GWB	ACT-1	10'-8"	
171	J. T. T. C.			PNT-1	PNT-3	PNT-1	PNT-1	2X2	10 -0	
142	OFFICE	CPT-2	RUBBER	GWB	GWB	GWB	GWB	ACT-1	10'-8"	
		——————————————————————————————————————	RUBBER	PNT-1 GWB	PNT-3 GWB	PNT-1 GWB	PNT-1 GWB	2X2 ACT-1		
143	OFFICE	———		PNT-1	PNT-3	PNT-1	PNT-1	2X2	10'-8"	
144	OFFICE	CPT-2	RUBBER	GWB	GWB	G₩B	GWB	ACT-1	10'-8"	
144	ULLION			PNT-1	PNT-3	PNT-1	PNT-1	2X2	10 -0	
145	OFFICE	CPT-2	RUBBER	GWB	GWB	GWB	GWB	ACT-1	10'-8"	
		——————————————————————————————————————	RUBBER	PNT-1 GWB	PNT-3 GWB	PNT-1 GWB	PNT-1 GWB	2X2 ACT-1	1	
146	OFFICE	O 1-Z	NODDEN	PNT-1	PNT-3	PNT-1	PNT-1	2X2	10'-8"	



STATE PROJECT NO.: H27-6071-LC

Beta Reseach
Facility Construction

HORIZON I
IDEA & SEAEPC
LAB UPFIT
(First Floor)

Columbia, South Carolina

REV.	DATE	DESCRIPTION
$\overline{\mathbf{U}}$	10,06,10	ADDENDUM NO. 03
2	04,26,11	CONSTRUCTION BULLETIN NO. 01
<u>3</u>	09,16,11	CONSTRUCTION BULLETIN NO. 11
4	03,19,12	CONTRACTOR AS-BUILT NOTES

ABBREVIATIONS

ACT-1 ACOUSTICAL CEILING TILE
ACT-2 ACOUSTICAL CEILING TILE W/
MYLAR FACE
CONC CONCRETE
CPT CARPET
CT CERAMIC TILE
EXIST. EXISTING
GWB GYPSUM WALLBOARD
PNT PAINT
PT PORCELAIN TILE
SP PNT SPECIALTY PAINT SYSTEM
VCT VINYL COMPOSITION TILE
VINYL VINYL WALL COVERING

PAINTING NOTES

 PROVIDE LEVEL 5 FINISH AT GYPSUM WALLBOARD SURFACES SCHEDULED TO RECEIVE SPECIALTY PAINT FINISH

RECORD DRAWINGS:

THESE "RECORD DRAWINGS" HAVE BEEN PREPARED BY THE ARCHITECT/ENGINEER USING ORIGINAL CONSTRUCTION DOCUMENTS AND INCORPORATING THE FIELD CHANGES AS SUPPLIED BY THE CONTRACTOR AS WELL AS OTHER REVISIONS MADE DURING THE CONSTRUCTION PHASE.

WATSON TATE SAVORY

Finish Schedule

FOR INFORMATION ONLY

I 1.3

WTS NO.: 1003

These drawings are the property of Watson Tate Savory Architects and may not be used in whole or in part without written consent of the architects and any infringement is subject to legal action.

ingement is subject to legal action.

RECORD DRAWINGS

19 MARCH 2012

	ISH SCHED	ULE - NA	ANOPOL	YMER LA	ABS SEC	OND FLO	OR			
00M	ROOM NAME	FLOOR	BASE			WALLS		CEILING		REMARKS
1 0.	TOOM TOOM	T LOOK	BNOC	NORTH	EAST	SOUTH	WEST	MATL.	HGT.	TALIAN MANAGEMENT OF THE PROPERTY OF THE PROPE
201	STAIR 1	EXIST, PRECAST		EXIST.	EXIST.	EXIST.	EXIST.			
		EXIST. RUBBER	EXIST. RUBBER	EXIST. GWB	EXIST, GWB	EXIST. GWB	EXIST. GWB			
Г02	STAIR 2			EXIST. PAINT *	EXIST. PAINT *	EXIST. PAINT *	EXIST. PAINT *			* TOUCH UP OR REPAINT AFTER CONSTRUCTION AS REQ
гоз	STAIR 3	EXIST. RUBBER	EXIST. RUBBER	EXIST. GWB	EXIST. GWB	EXIST. GWB	EXIST. GWB			* TOUCH UP OR REPAINT AFTER CONSTRUCTION AS REQ
				EXIST. PAINT *	EXIST. PAINT *	EXIST. PAINT *	EXIST, PAINT *			
		EXIST, PT	EXIST. WOOD	exist. GWB	exist. GWB	EXIST. GWB	EXIST. GWB	EXIST.ACT/EXIST.G\(\psi\)B	10'-8/	
201	ELEVATOR LOBBY		EXIST. STAIN *	EXIST. SP. PAINT *	EXIST. SP. PAINT *	EXIST, SP. PAINT *	EXIST. SP. PAINT *	EXIST. 2X2/PAINT *	10'-8/ 12'-0"	* TOUCH UP OR REPAINT AFTER CONSTRUCTION AS REC
202	CORRIDOR	СРТ	WOOD STAIN	G₩B Sp. paint *	EXIST. GWB SP. PAINT *	GWB SP. PAINT *	GWB SP. PAINT *	ACT-1/GWB	10'-8"	* SPECIALTY PAINT
		CPT	RUBBER	GWB	GWB	GWB	GWB	ACT-1/GWB	40' 0"	A CDECIAL TV. DANIT
203	CORRIDOR			SP. PAINT *	SP. PAINT *	SP. PAINT *	SP. PAINT *	2X2 / PAINT	10'-8"	* SPECIALTY PAINT
204	CORRIDOR	CPT/VCT **	RUBBER	Exist. G\(\psi\)B Sp. paint *	GWB SP. PAINT *	GWB SP. PAINT *	GWB SP. PAINT *	ACT-1/GWB 2X2 / PAINT	10'-8"	* SPECIALTY PAINT ** VCT AT ELEVATOR ENTRANCE
1205	CORRIDOR	СРТ	RUBBER *	EXIST. GWB	G₩B	G₩B	G₩B	ACT-1/GWB	10'-8"	* SPECIALTY PAINT
1203	COMMEDIA	CONCRETE	RUBBER	SP. PAINT *	SP. PAINT * GWB	SP. PAINT *	SP. PAINT * GWB	2X2 / PAINT STRUCTURE		5. E3E1. 1(1
1206	SERVICE CORRIDOR	SEAL		PAINT	PAINT	PAINT	PAINT			
207	SERVICE CORRIDOR	CONCRETE	RUBBER	G₩B	G₩B	G₩B	G₩B	STRUCTURE		
		SEAL		PAINT	PAINT	PAINT	PAINT			
		СРТ	WOOD	G₩B	G₩B	GWB	G₩B	ACT-1	Ι	1
/201	VESTIBULE		STAIN	SP. PAINT *	SP. PAINT *	SP. PAINT *	SP. PAINT *	2X2	9'-4"	* SPECIALTY PAINT
y01	ELEVATOR 01	EXISTING ELEVATOR	R SHAFT AND CAR							
.,01	LECTATOR OF	CVISHING EFENATOR	. SOME AND CAD							
V02	FUTURE ELEVATOR 2	EXISTING SHAFT FO	OR FUTURE ELEVATOR (CAB						
V03	ELEVATOR 03	EXISTING ELEVATOR	R SHAFT & CAB							
	<u> </u>	1								<u> </u>
	Г	1	T .			T	<u> </u>	T	Γ	T
201	CONFERENCE 1	СРТ	₩OOD	G₩B	G₩B	G₩B	OPERABLE PARTITION	ACT-1/GWB	10'-8"/ 12'-0"	
			STAIN	PAINT	PAINT	PAINT	WOOD	2X2 / PAINT	12 -0	
202	CONFERENCE 2	СРТ	₩OOD	OPERABLE PARTITION	G₩B	G₩B	G₩B	ACT-1/GWB	10'-8"/ 12'-0"	
			STAIN	₩00D	PAINT	PAINT	PAINT	2X2 / PAINT		
203	BREAKROOM		RUBBER	G₩B PAINT	GWB PAINT	G\(\bar{B}\) PAINT	G\(\bar{B}\) PAINT	ACT-1/G\(\frac{1}{2}\)B	10'-8"	
204	Men	PT	СТ	CT *	CT *	CT *	CT *	ACT-1/GWB	9'-4"	* 8x8 CT TYPICAL; 2x2 AT SINK WALL
		 PT						2X2 / PAINT ACT-1/GWB		(SEE SHEET A7,2 FOR ELEVATIONS)
205	WOMEN							2X2 / PAINT	9'-4"	* 8x8 CT TYPICAL; 2x2 AT SINK WALL (SEE SHEET A7.2 FOR ELEVATIONS)
206	OFFICE	СРТ	RUBBER	G₩B	GWB	GWB	GWB	ACT-1	10'-8"	
		CPT	RUBBER	PAINT GWB	PAINT GWB	PAINT GWB	PAINT GWB	2X2 ACT-1		
207	OFFICE			PAINT	PAINT	PAINT	PAINT	2X2	10'-8"	
208	OFFICE	СРТ	RUBBER	G₩B PAINT	G\\B PAINT	G\\B PAINT	G\\B PAINT	ACT-1 2X2	10'-8"	
	0	CPT	RUBBER	G\\B	GWB	GWB	GWB	ACT-1	40' 0"	
209	OFFICE			PAINT	PAINT	PAINT	PAINT	2X2	10'-8"	
210	OFFICE		RUBBER ———	G₩B PAINT	G\\B PAINT	G\(\bar{B}\) PAINT	G\\B PAINT	ACT-1 2X2	10'-8"	
211	OFFICE	СРТ	RUBBER	G₩B	G₩B	GWB	GWB	ACT-1	10'-8"	
	OTTIGE			PAINT G\\B	PAINT GWB	PAINT GWB	PAINT GWB	2X2 ACT-1	10 0	
212	OFFICE		RUBBER ———	PAINT	PAINT	PAINT	PAINT	2X2	10'-8"	
213	OFFICE	СРТ	RUBBER	G₩B	с₩в	EXIST. GWB	G₩B	ACT-1	10'-8"	
		EXIST. CONCRETE	RUBBER	PAINT EXIST. G\(\rightarrow\right	PAINT EXIST. GWB	PAINT EXIST. GWB	PAINT EXIST, GWB	2X2 EXIST. STRUCTURE		
214	ELECTRICAL			EXIST. PAINT *	EXIST. PAINT *	EXIST. GWB EXIST. PAINT *	EXIST. GWB EXIST. PAINT *	EXIST. STRUCTURE		* TOUCH UP OR REPAINT AFTER CONSTRUCTION AS REC
215	RAFT SYNTHESIS LAB	EXIST. CONCRETE	RUBBER	G₩B	GWB	GWB	GWB	ACT-2	9'-4"	
		SEAL EXIST. CONCRETE	RUBBER	PAINT GWB	PAINT GWB	PAINT GWB	PAINT GWB	2X2 / 1X2 ACT-2		
216	SYNTHESIS LAB	SEAL		PAINT	PAINT	PAINT	PAINT	2X2 / 1X2	9'-4"	
217	FUEL CELL SYNTHESIS LAB	EXIST. CONCRETE SEAL	RUBBER	G\\\B PAINT	G₩B PAINT	G\\B PAINT	G₩B PAINT	ACT-2	9'-4"	
	FUEL CELL	SEAL EXIST. CONCRETE	RUBBER	PAINT GWB	PAINT G\(\rightarrow\r	GWB	GWB	2X2 / 1X2 ACT-2	01 18	
218	CHARACTERIZATION LAB	SEAL		PAINT	PAINT	PAINT	PAINT	2X2 / 1X2	9'-4"	
219	FUEL CELL LAB	EXIST. CONCRETE SEAL	RUBBER ———	G₩B PAINT	G\\B PAINT	GWB PAINT	G\(\bar{W}\)B	ACT-2 2X2 / 1X2	9'-4"	
220	UPS AREA	EXIST. CONCRETE	RUBBER	EXIST. GWB	EXIST. GWB	EXIST. GWB		EXIST. STRUCTURE		
		SEAL EXIST. CONCRETE	EXIST. RUBBER	PAINT EXIST. GWB	PAINT EXIST. GWB	PAINT EXIST. GWB	EXIST. GWB	EXIST. ACT		
221	JANITOR	EXIST. CONCRETE	——————————————————————————————————————	EXIST. PAINT *	EXIST. PAINT *	EXIST. PAINT *	EXIST. PAINT *	2X2	10'-8"	* TOUCH UP OR REPAINT AFTER CONSTRUCTION AS REC
222	LABORATORY	EXIST. CONCRETE	RUBBER	EXIST. G\(\psi\)B	G₩B PAINT	GWB	G₩B PAINT	ACT-2	9'-4"	
		SEAL EXIST. CONCRETE	RUBBER	PAINT GWB	PAINT GWB	PAINT G\(\right)B	PAINT GWB	2X2 / 1X2 ACT-2	A1 .#	
23	CHARACTERIZATION LAB 1	SEAL		PAINT	PAINT	PAINT	PAINT	2X2 / 1X2	9'-4"	
24	CHARACTERIZATION LAB 2	EXIST. CONCRETE SEAL	RUBBER	G₩B PAINT	G\\B PAINT	GWB PAINT	G\(\bar{B}\) PAINT	ACT-2 2X2 / 1X2	9'-4"	
25	SYNTHESIS I AD 1	EXIST. CONCRETE	RUBBER	GWB	GMB	GWB	GWB	ACT-2	9'-4"	
25	SYNTHESIS LAB 1	SEAL CONCRETE		PAINT	PÁINT CWB	PAINT	PAINT	2X2 / 1X2	3 ⁻⁴	
226	SYNTHESIS LAB 2	EXIST. CONCRETE SEAL	RUBBER ———	G₩B PAINT	G₩B PAINT	GWB PAINT	GWB PAINT	ACT-2 2X2 / 1X2	9'-4"	
227	RAFT NANOSTRUCTURE LAB	EXIST, CONCRETE	RUBBER	G₩B	GWB	с₩в	с₩В	ACT-2	9'-4"	
	I HANGOINGUINE LAD	SEAL CPT	RUBBER	PAINT G\\B	PAINT GWB	PAINT GWB	PAINT GWB	2X2 / 1X2 ACT-1		
28	OFFICE			GWR PAINT	PAINT	PAINT	PAINT	2X2	10'-8"	
229	OFFICE	СРТ	RUBBER	G₩B	G₩B	С₩В	GWB	ACT-1	10'-8"	
		EXIST. CONCRETE	EXIST. RUBBER	PAINT EXIST, GWB	PAINT EXIST, GWB	PAINT EXIST, GWB	PAINT Exist, GWB	2X2 EXIST. STRUCTURE		
	DATA	EMOT, CONCRETE		EXIST, GWB EXIST, PAINT *	EXIST, GWB EXIST, PAINT *	EXIST, GWB EXIST, PAINT *	EXIST, GWB EXIST, PAINT *	EXIST. STRUCTURE		* TOUCH UP OR REPAINT AFTER CONSTRUCTION AS REC
30					G₩B	GWB		ACT-1/GWB		

MOO	1414				PLAN	WALLS		CEILIN	IG	
NO.	ROOM NAME	FLOOR	BASE	NORTH	EAST	SOUTH	WEST	MATL.	HGT,	REMARKS
272	DIDECTOR'S OFFICE	СРТ	₩OOD	G₩B	G₩B	G₩B	GWB	ACT-1	10'-8"	
232	DIRECTOR'S OFFICE		STAIN	PAINT	PAINT	PAINT	PAINT	2X2	7 10 -8	
077	OFFICE	СРТ	RUBBER	G₩B	G₩B	G₩B	G₩B	ACT-1	10'-8"	
233	OFFICE			PAINT	PAINT	PAINT	PAINT	2X2	7 10 -0	
074	OFFICE	СРТ	RUBBER	G₩B	G₩B	G₩B	G₩B	ACT-1	10'-8"	
234	OFFICE			PAINT	PAINT	PAINT	PAINT	2X2	7 10 -6	
235	OFFICE	СРТ	RUBBER	G₩B	G₩B	G₩B	G₩B	ACT-1	10'-8"	
233	OFFICE			PAINT	PAINT	PAINT	PAINT	2X2		
236	OFFICE	СРТ	RUBBER	G₩B	G₩B	G₩B	G₩B	ACT-1	10'-8"	
230	OFFICE			PAINT	PAINT	PAINT	PAINT	2X2		
237	COPY/WORKROOM	СРТ	RUBBER	G₩B	G₩B	G₩B	G₩B	ACT-1	10'-8"	
237	COL 17 WOKKKOOM			PAINT	PAINT	PAINT	PAINT	2X2		
238	OFFICE	CPT	RUBBER	G₩B	G₩B	G₩B	G₩B	ACT-1	10'-8"	
230	OTTIOE			PAINT	PAINT	PAINT	PAINT	2X2		
239	OFFICE	CPT	RUBBER	G₩B	G₩B	G₩B	G₩B	ACT-1	10'-8"	
	0.1100			PAINT	PAINT	PAINT	PAINT	2X2		
240	OFFICE	СРТ	RUBBER	G₩B	G₩B	G₩B	G₩B	ACT-1	10'-8"	
240	OFFICE			PAINT	PAINT	PAINT	PAINT	2X2		
241	OFFICE	СРТ	RUBBER	G₩B	G₩B	G₩B	G₩B	ACT-1	10'-8"	
241	OFFICE			PAINT	PAINT	PAINT	PAINT	2X2		



STATE PROJECT NO.: H27-6022-LC-B

Beta Reseach **Facility Construction**

HORIZON I NANOPOLYMER LAB UPFIT

Columbia, South Carolina

REV. DATE DESCRIPTION

1 2.27.09 ISSUED FOR BIDDING 2 3.12.09 ADDENDUM 01

3 8.04.09 CONSTRUCTION BULLETIN 16

4 10.13.09 CONSTRUCTION BULLETIN 23

ABBREVIATIONS

ACT-1 ACOUSTICAL CEILING TILE
ACT-2 ACOUSTICAL CEILING TILE
W/ MYLAR FACE
CONC CONCRETE
CPT CARPET
CT CERAMIC TILE
EXIST. EXISTING
GWB GYPSUM WALLBOARD
PT PORCELAIN TILE
SP. PAINT SPECIALTY PAINT SYSTEM
VCT VINYL COMPOSITION TILE
VINYL WALL COVERING

GENERAL NOTES

PROVIDE SPECIALTY PAINT AS SPECIFIED AT SECTION 09941 AT GYPSUM WALLBOARD IN PUBLIC CORRIDORS. SEE FINISH SCHEDULE.

RECORD DRAWINGS:

THESE "RECORD DRAWINGS" HAVE BEEN PREPARED BY THE ARCHITECT/ENGINEER USING ORIGINAL CONSTRUCTION DOCUMENTS AND INCORPORATING THE FIELD CHANGES AS SUPPLIED BY THE CONTRACTOR AS WELL AS OTHER REVISIONS MADE DURING THE CONSTRUCTION PHASE.

WATSON TATE SAVORY

Finish Schedule

FOR INFORMATION ONLY

27 FEBRUARY 2009 WTS NO.: 0806 These drawings are the property of Watson Tate Savory Architects and may not be used in whole or in part without written consent of the architects and any infringement is subject to legal action.

CONSTRUCTION DOCUMENTS

ROOM	ROOM NAME	FLOOR	BASE	NODTU	· · · · · · · · · · · · · · · · · · ·	₩ALLS SQUTU	, we can	CEILING		REMARKS
NO,		EXIST, PRECAST	<u> </u>	NORTH EXIST, STEEL/GLASS	EAST EXIST, STEEL/GLASS	SOUTH EXIST, STEEL/GLASS	WEST EXIST, STEEL/GLASS	MATL.	HGT,	<u> </u>
ST301	STAIR 1				<u> </u>					
ST302	STAIR 2	EXIST. RUBBER ———	EXIST. RUBBER	EXIST. G\(\mathbb{B}\) EXIST. PAINT *	EXIST. G\(\rightarrow\	EXIST. G\(\psi\)B EXIST. PAINT *	EXIST. G\(\psi\)B EXIST. PAINT *	<u> </u>		* TOUCH UP OR REPAINT AFTER CONSTRUCTION AS REC
ST303	STAIR 3	EXIST, RUBBER	EXIST, RUBBER	EXIST. GWB EXIST. PAINT *	EXIST. GWB EXIST. PAINT *	EXIST. GWB EXIST. PAINT *	EXIST. GWB EXIST. PAINT *			* TOUCH UP OR REPAINT AFTER CONSTRUCTION AS RE
н301	ELEVATOR LOBBY	EXIST. PT	EXIST, WOOD	EXIST, GWB	EXIST, GWB	EXIST, GWB	EXIST, GWB	EXIST, ACT/EXIST, G\(\psi\)B EXIST, 2X2/PAINT *	10'-8/ 12'-0"	* TOUCH UP OR REPAINT AFTER CONSTRUCTION AS RE
Н302	CORRIDOR	СРТ	EXIST, STAIN * WOOD	EXIST, SP, PAINT * GWB	EXIST, SP, PAINT * EXIST, GWB	EXIST, SP, PAINT * GWB	EXIST, SP, PAINT * GWB	ACT-1/GWB		
			STAIN	SP. PÁINT	SP. PAINT	SP. PAINT	SP. PÁINT	2X2	10'-8"	
Н303	CORRIDOR	СРТ	RUBBER	G₩B	C₩B	GWB	GWB	ACT-1/GWB	10'-8"	
			RUBBER	SP. PAINT EXIST. GWB	SP. PAINT GWB	SP. PAINT GWB	SP. PAINT GWB	2X2 / PAINT ACT-1/GWB		+ VOT AT ELEVATOR ENTRANCE
H304	CORRIDOR			SP. PAINT	SP. PAINT	SP. PAINT	SP. PAINT	2X2 / PAINT	10'-8"	* YCT AT ELEVATOR ENTRANCE
н305	CORRIDOR	СРТ	RUBBER *	EXIST, G\(\mathbb{B}\)	G₩B	GWB	GWB	ACT−1/G₩B	10'-8"	
n303	CORRIDOR	CONCRETE	RUBBER	SP, PAINT GWB	SP, PAINT GWB	SP, PAINT GWB	SP, PAINT GWB	2X2 / PAINT STRUCTURE		
H306	SERVICE CORRIDOR	SEAL		PAINT	PAINT	PAINT	PAINT			
Н307	SERVICE CORRIDOR	CONCRETE SEAL	RUBBER ———	G₩B PAIŊT	G ∜ B PAINT	G₩B PAINT	GWB PAINT	STRUCTURE		
V301	VESTIBULE	СРТ	WOOD	G₩B	G₩B	G₩B	G₩B	ACT-1	9'-4"	
γ301	AF2 LIROTE		STAIN	SP, PAINT	SP, PAINT	SP, PAINT	SP, PÁINT	2X2		
EV01	ELEVATOR 01	EXISTING ELEVATOR	R SHAFT AND CAB							
E V 02	FUTURE ELEVATOR 2	EXISTING SHAFT FO	OR FUTURE ELEVATOR	CAB						
EV03	ELEVATOR 03	EXISTING ELEVATOR	R SHAFT & CAB							
301	CONFERENCE 1	СРТ	WOOD	G₩B	G₩B	G₩B	OPERABLE PARTITION	ACT-1/GWB	10'-8"/ 12'-0"	
			STAIN WOOD	SP, PAINT OPERABLE PARTITION	SP, PAINT G\B	SP. PAINT GWB	GWB (WOOD	2X2 / PAINT ACT-1/GWB		
302	CONFERENCE 2		STAIN	WOOD	SP. PAINT	SP. PAINT	SP. PAINT	2X2 / PAINT	10'-8"/ 12'-0"	
303	BREAKROOM	VCT	RUBBER	G₩B PAINT	G₩B PAINT	G₩B PAINT	GWB PAINT	ACT-1/GWB	10'-8"	
304	MEN	PT	PT	CT*	CT*	CT*	CT*	2X2 / PAINT ACT-1/GWB	9'-4"	* 8X8 CT TYPICAL: 2X2 AT SINK WALL
		——— РТ	<u>——</u> РТ					2X2 / PAINT ACT-1/GWB	9'-4"	(SEE SHEET A7.2 FOR ELEVATIONS) * 8X8 CT TYPICAL; 2X2 AT SINK WALL
305	WOMEN		RUBBER					2X2 / PAINT ACT-1		(SEE SHEET A7,2 FOR ELEVATIONS)
306	COMPUTING & ANALYSIS			PAINT	PAINT	PAINT	PAINT	2X2	10'-8"	
307	OFFICE		RUBBER	G₩B PAINT	G∦B PAINT	G\(\bar{B}\) PAI\\T	G\\\B PAI\\T	ACT-1 2X2	10'-8"	
308	OFFICE		RUBBER	G\\B PAINT	G∜B PAINT	G₩B PAINT	GWB PAINT	ACT-1 2X2	10'-8"	
309	OFFICE	CPT	RUBBER	G₩B PAINT	G ∜ B PAINT	G₩B PAINT	GWB PAINT	ACT-1 2X2	10'-8"	
310	OFFICE	СРТ	RUBBER	G₩B	G₩B	GŴB	GWB	ACT-1	10'-8"	
		CPT	RUBBER	PAINT GWB	PAINT G\\B	PAINT GWB	PAINT GWB	2X2 ACT-1		
311	OFFICE		 RUBBER	PAINT G\(\right\)B	PAINT G\\rightarrowB	PAINT GWB	PAINT GWB	2X2 ACT-1	10'-8"	
312	OFFICE			PAINT	PAINT	PAINT	PAINT	2X2	10'-8"	
313	ELECTRICAL	EXIST, CONCRETE SEAL	RUBBER	EXIST, G\(\psi\)B EXIST, PAI\(\psi\)T *	EXIST, G\(\psi\)B EXIST, PAI\(\psi\)T *	EXIST, GWB EXIST, PAINT *	EXIST, GWB EXIST, PAINT *	STRUCTURE		* TOUCH UP OR REPAINT AFTER CONSTRUCTION AS R
314	POWDER PROCESSING LAB	EXIST, CONCRETE SEAL	RUBBER	G₩B PAINT	G ∜ B PAINT	EXIST, G\(\psi\)B PAINT	G\(\psi\)B PAINT	ACT-2 2X2 / 1X2	9'-4"	
315	MATERIAL AND CELL FABRICATION LAB	EXIST. CONCRETE	RUBBER	C₩B	с∦в	GWB	GWB	ACT-2	9'-4"	
316	SINTERING FURNACE LAB.	SEAL EXIST. CONCRETE	RUBBER	PAINT GWB	PAINT G\\B	PAINT G\(\right\)B	PAINT GWB	2X2 / 1X2 ACT-2	9'-4"	
	CURLING AND TREATING	SEAL EXIST. CONCRETE	RUBBER	PAINT GWB	PAINT G\\B	PAINT GWB	PAINT G\\B	2X2 / 1X2 ACT-2		
317	COATINGS LAB *	SEAL EXIST. CONCRETE		PAINT GWB	PAINT GWB	PAINT GWB	PAINT GWB	2X2 / 1X2 ACT-2	9'-4"	
318	CATALYSIS AND REFORMING LAB *	SEAL		PAINT	PAINT	PAINT	PAINT	2X2 / 1X2	9'-4"	
319	HIGH TEMPERATURE ELECTROLYSIS LAB *	EXIST. CONCRETE SEAL	RUBBER	EXIST. GWB PAINT	EXIST. GWB PAINT	EXIST. G\(\psi\)B PAI\(\psi\)T	<u> </u>	EXIST. STRUCTURE		
320	MECHANICAL AND ELECTRICAL	EXIST. CONCRETE SEAL	RUBBER	GWB PAINT	G\\B PAINT	G₩B PAINT	G₩B PAINT	EXIST. STRUCTURE	10'-8"	
321	STORAGE	EXIST. CONCRETE	RUBBER	EXIST. GWB	EXIST. GWB	EXIST. GWB	G₩B	ACT-1	10'-8"	
322	JANITOR	SEAL EXIST. CONCRETE	EXIST. RUBBER	PAINT EXIST. GWB PAINT	PAINT EXIST. G\(\psi\)B PAINT	PAINT EXIST. GWB PAINT	PAINT EXIST. GWB PAINT	2X2 EXIST. ACT	10'-8"	* TOUCH UP OR REPAINT AFTER CONSTRUCTION AS R
323	MECHANICAL BEHAVIOR LAB *	EXIST. CONCRETE SEAL	RUBBER	EXIST. GWB PAINT	GWB PAINT	GWB PAINT	GWB PAINT	ACT-2 2X2 / 1X2	9'-4"	
324	PHYSICAL PROPERTY LAB *	EXIST. CONCRETE SEAL	RUBBER	G₩B PAINT	G₩B PAINT	GWB PAINT	GWB PAINT	ACT-2 2X2 / 1X2	9'-4"	
325	SYSTEMS ASSEMBLY & TEST LAB	EXIST. CONCRETE SEAL	RUBBER ———	G₩B PAINT	G ₩ B PAINT	G₩B PAINT	GWB PAINT	ACT-2 2X2 / 1X2	9'-4"	
326A	SPECIMEN IMAGING LAB	EXIST. CONCRETE	RUBBER	G₩B	G₩B	G₩B	G₩B	ACT-2	9'-4"	
326B	SPECIMEN ANALYSIS	SEAL EXIST. CONCRETE	Rubber	PAINT GWB	PAINT GWB	PAINT GWB	PAINT GWB	2X2 / 1X2 ACT-2	9'-4"	
		SEAL EXIST. CONCRETE	 Rubber	PAINT GWB	PAINT GWB	PAINT GWB	PAINT GWB	2X2 / 1X2 ACT-2		
327	STACK AND EIS TEST LAB	SEAL		PAINT	PAINT	PAINT	PAINT	2X2 / 1X2	9'-4"	
328	SOFC TEST LAB	EXIST. CONCRETE SEAL	RUBBER	G₩B PAINT	G₩B PAINT	GWB PAINT	EXIST. G\(\psi\)B PAI\\\T	ACT-2 2X2 / 1X2	9'-4"	
329	OFFICE	CPT	RUBBER	EXIST. G\(\psi\)B PAI\(\psi\)T	GWB PAINT	G₩B PAINT	G₩B PAINT	ACT-1 2X2	9'-4"	
330	COPIER/WORK ROOM	СРТ	RUBBER	EXIST. GWB	EXIST. GWB	G₩B	G₩B	ACT-1	10'-8"	
		EXIST. CONCRETE	EXIST. RUBBER	PAINT EXIST. GWB	PAINT EXIST. GWB	PAINT EXIST. GWB	PAINT EXIST. GWB	2X2 EXIST. STRUCTURE		

ROOM	A. () () ()				PLAN	₩ALLS		CEILING		
NO.	ROOM NAME	FL00R	BASE	NORTH	EAST	SOUTH	WEST	MATL.	HGT,	REMARKS
770	BREAKOUT	СРТ	₩00D	G₩B	GWB	G₩B	G₩B	ACT-1/GWB	10'-8"	
332	BREAKOUT			SP, PÅINT	SP, PAINT	SP, PÁINT	SP, PAINT	2X2 / PAINT	10-8	
777	OFFICE	СРТ	RUBBER	G₩B	G₩B	G₩B	G₩B	ACT	10'-8"	
333	OFFICE			PAINT	PAINT	PAINT	PAINT	2X2	1 10 -0	
334	OFFICE	СРТ	RUBBER	G₩B	G₩B	G₩B	G₩B	ACT	10'-8"	
JJ4	OFFICE			PAINT	PAINT	PAINT	PAINT	2X2	1 10 -0	
335	OFFICE	СРТ	RUBBER	G₩B	G₩B	G₩B	G₩B	ACT	10'-8"	
333	OFFICE			PAINT	PAINT	PAINT	PAINT	2X2	1 10 -0	
336	OFFICE	СРТ	RUBBER	G₩B	G₩B	G₩B	G₩B	ACT	10'-8"	
JJ0	OFFICE			PAINT	PAINT	PAINT	PAINT	2X2] '0-0	
337	OFFICE	СРТ	RUBBER	G₩B	G₩B	G₩B	G₩B	ACT	10'-8"	
337	OFFICE			PAINT	PAINT	PAINT	PAINT	2X2] '0-0	
338	OFFICE	CPT	RUBBER	G₩B	G₩B	G₩B	G₩B	ACT	10'-8"	
JJ0	OFFICE			PAINT	PAINT	PAINT	PAINT	2X2] '0-0	
339	OFFICE	СРТ	RUBBER	G₩B	G₩B	G₩B	G₩B	ACT	10'-8"	
JJ3	OTTIOL			PAINT	PAINT	PAINT	PAINT	2X2] '0-0	
740	OFFICE	СРТ	RUBBER	G₩B	G₩B	G₩B	G₩B	ACT	10'-8"	
340	OFFICE			PAINT	PAINT	PAINT	PAINT	2X2] '0-8	
744	OFFICE .	СРТ	RUBBER	G₩B	G₩B	G₩B	G₩B	ACT	10'-8"	
341	OFFICE			PAINT	PAINT	PAINT	PAINT	2X2	1 10-0	



STATE PROJECT NO.: H27-6022-LC-C

Beta Research Facility Construction

SOLID OXIDE FUEL CELL LAB UPFIT

Columbia, South Carolina

REV.	DATE	DESCRIPTION
1	10.13.09	CONSTRUCTION BULLETIN 12

ABBREVIATIONS

ACOUSTICAL CEILING TILE
ACOUSTICAL CEILING TILE
W/ MYLAR FACE
CONCRETE
CARPET
CERAMIC TILE
EXISTING
GYPSUM WALLBOARD
PORCELAIN TILE
SPECIALTY PAINT SYSTEM
VINYL COMPOSITION TILE
VINYL WALL COVERING

GENERAL NOTES

1. PROVIDE SPECIALTY PAINT AS SPECIFIED AT SECTION 09941 AT GYPSUM WALLBOARD IN PUBLIC CORRIDORS AND CONFERENCE ROOMS. SEE FINISH SCHEDULE FOR LOCATIONS.

RECORD DRAWINGS:

THESE "RECORD DRAWINGS" HAVE BEEN PREPARED BY THE ARCHITECT/ENGINEER USING ORIGINAL CONSTRUCTION
DOCUMENTS AND INCORPORATING THE FIELD
CHANGES AS SUPPLIED BY THE CONTRACTOR
AS WELL AS OTHER REVISIONS MADE DURING
THE CONSTRUCTION PHASE.

WATSON TATE SAVORY

Finish Schedule

FOR INFORMATION ONLY

WTS NO: 0828 06 MAY 2009 These drawings are the property of Watson Tate Savory Architects and may not be used in whole or in part without written consent of the architects and any infringement is subject to legal action.

CONSTRUCTION DOCUMENTS

USC, Ground & 4th Floors Upfit

ADDENDUM 2

7/25/2013

SST revisions to the Bid Documents and responses to questions & RFIs:

REVISIONS TO THE PROJECT MANUAL:

- SECTION 11600 LABORATORY EQUIPMENT GENERAL REQUIREMENTS
 - A. Revise Equipment Schedule Sorted by Number, Equipment Number FH-021A, to delete reference "For Hydrofluoric Acid" from the Special Considerations column.
 - B. Revise Equipment Schedule Sorted by Number, Equipment Number FH-021B, to delete reference "For Hydrofluoric Acid" from the Special Considerations column.
 - C. Revise Equipment Schedule Sorted by Number, Equipment Number EQ-080, Installation column to read: "C/C".
 - D. Revise Equipment Schedule Sorted by Space, Room 026, Equipment Number EQ-001, Quantity column to read: "5".
- 2. SECTION 12309 LABORATORY SERVICE FIXTURES
 - A. Revise paragraph 2.04.A.1 to add the following: "Wall-Mounted Fixtures with removable serrated hose ends, Single Outlet Turret, Model No. L4200-158WSA".
- 3. SECTION 12340 LABORATORY CASEWORK GENERAL REQUIREMENTS
 - A. Revise paragraph 1.08 MOCK-UP to add the following:
 - "E. Mock-up scope shall include one lab, prep room or portion of a lab, and shall incorporate the basic elements of a lab including, but not limited, to a sink and associated counter area, base cabinets with drawers and doors, knee space, wall mounted cabinet, wall mounted shelf, flammable and acid cabinets and fume hood with all necessary surface fixtures and service connection components to make the lab function. Mock-up shall include one cabinet in each color finish selected and approved via sample process.
 - F. Mock-up location shall be either in a conditioned trailer remaining on site throughout the project (provided by the contractor) or in a conditioned room within the new facility agreed upon by the Owner, Architect, Contractor and Lab Casework & Equipment Provider / Installer. Mock-up shall remain in place the duration of the project and if all components are acceptable, is permitted to become a part of the completed work. If the mock-up is located within a trailer, the components, if approved, may be relocated in the facility at a time approved by the Architect".
 - B. Revise paragraph 2.03.E.5.A, to replace reference "5-disc" with "pin".
- 4. SECTION 12346 WOOD LABORATORY CASEWORK
 - A. Prior Approval: CiF Lab Solutions is an acceptable manufacturer as provided. They meet all specifications. Refer to specification section 11600.2.1.A that states: "The Naming of manufacturer(s) and designation of product is for the purpose of identifying and

describing required product and not to limit competition. Other manufacturers capable of producing the same appearance and having the same quality, durability, and performance may be proposed for use on this project subject to Architect's approval, unless noted otherwise. Other approved manufacturers are responsible for all adjustments required to fit their products to the work at no additional cost.

- B. Revise paragraph 2.03.A.3 to add:
 - "A. Tables with electrical outlets and data outlet at the apron shall be pre-wired and provided with 8 ft. cord and plug for easy relocation. Electrical fixtures shall be 1/60/115V. All outlets on the table apron shall be complete with enclosure boxes, receptacle and cover plates. Cover plates shall be stainless steel. Tables shall be provided with cleats so that the 8' cords can be wrapped up when not in use. Electrical and data outlet boxes shall be concealed and protected to prevent accidental contact of User's knees with electrical connections".
- C. Revise paragraph 2.03.C.1 to read: "12" Island Structural Modules shall be made from cold-rolled steel with a corrosion and chemical resistant finish as specified in 12340".

REVISIONS TO THE PROJECT DRAWINGS:

1. Replace drawings in the original bid document set with revised drawings that are attached to this addendum:

Drawing Q0.1	Casework Types	1 Sheet
Drawing Q2.0a	Enlarged Lab Plan (Ground Floor)	1 Sheet
Drawing Q4.2	Metal Casework Details and Mounting Heights	1 Sheet

RESPONSES TO THE BIDDER QUESTIONS & RFIs:

1. Campbell Rhea RFI, dated 7/18/2013:

1. Who is responsible for the overhead service carriers? The items are not covered in any specifications that I can find. OHSC are not detailed either for configuration, etc. The floor plan and elevations are showing units dashed in. Is the mechanical contractors providing these items?

OHSC details are indicated in sheet A6.5 and S1.0.

2. Section 12345 – Item FH-019 - AirClean Systems notes AC8030TE is not available with scrubber as noted by specification, equipment list, and drawings. Will it be acceptable to provide the unit without the scrubber?

NOT ACCEPTABLE without scrubber. The fume hood cut sheets and manufacturer website indicate "Mistline Scrubbers can usually be incorporated if any water-soluble Acid/Alkali are being used". Provide fume hood with scrubber as specified.

3. Section 12345 – FH-019 – Floor plan notes R04 & R03 base units but elevation noting (2) R08 units. AirClean is noting that the unit would be provided with (1) 8' long base unit. Is this acceptable?

Elevation drawing is correct. Will revise plans to indicate (2) R08 units. It is acceptable to provide (1) 8 ft long base unit.

4. Room 032 floor plan – Indicates 4' x 5' performing tables with locking casters (NIC) but elevations and floor plan still show (2) T05W as though the items are still required. Are (2) T05W tables @ 48"x60" to be provided for this room?

Tables are required. Provide (2) T05W tables @ 48" x 60". Will revise plan to remove (NIC).

5. Equipment list – Sorted by Space – EQ-004 is noting a Grainger 9MDJ5 unit but this unit does not seem to meet specifications. Is this a correct part that can be provided?

Provide per specifications. Other manufacturers capable of producing the same appearance and having the same quality and performance specified may propose for use on this project.

6. Will the plumber be responsible for the stainless steel sinks? (Ref. S11 – S14). The 12340 section does not cover stainless steel sinks except for the sink strainer & tailpiece which is noted by division 15.

Sink type S11 is by MEP (See MEP drawings & specs). Sink types S12 & S13 are by the casework contractor. Sink type S14 is not used.

7. What finish is required for the ColorTech fixtures in section 12309? None is indicated. Spec notes only "polyester powder coat".

Provide polyester powder coat in any of manufacturer's standard colors.

8. Section 12309 Lab Service Fixtures – the specifications cover deck mounted fixtures, female quick disconnects for ADA cart, fume hood fixtures, safety showers, and deck mounted eyewashes. Will the plumber be responsible for the wall mounted service fixtures?

Wall mounted specialty gas fixtures are by the specialty gas contractor. Cold water, hose bib, and chilled water supply & return fixtures are by the plumber. Compressed Air is by casework contractor.

9. Equipment List – Sorted by Space – Rm #026, EQ-001 Snorkel, Quantity noted as (4). Sheet Q2.0a floor plan for the room shows (5). Please advise how many are required. (2-Above T05 tables, (1) each in 3 corners of room)

5 are required. Will revise equipment list to indicate correct quantity.

2. Hogan Construction Group:

1. In doing a takeoff for the casework I noticed that Q2.4b seems to be missing... I also did not see it in the Addendum 1 drawings... please clarify?

Q2.4b lab casework sheet does not exist. It was never issued during the entire design phase of the project. There are 2 lab casework sheets for the Ground Floor: Q2.0a & Q2.0b. There is 1 lab casework sheet for the Fourth Floor: Q2.4a.

2. I noticed on the equipment schedule that a jib crane is to be provided and installed by the owner, but there is a specification that seems to indicate it is to be supplied and installed by the GC in spec section 05500- Metal Fabrications in Part 2.1C. Could you clarify what we will be responsible for please?

It is by GC. Will edit the equipment schedule accordingly.

3. NyCom RFI:

 12340 1.08 Mock up requires a laboratory furniture mock up; however, no mock is identified in the drawings or noted in Division 1. Please confirm that no mock up is required on this project.

Lab mock-up is required. Mock-up scope shall include one lab, prep room or portion of a lab, and shall incorporate the basic elements of a lab including, but not limited, to a sink and associated counter area, base cabinets with drawers and doors, knee space, wall mounted cabinet, wall mounted shelf, flammable and acid cabinets and fume hood with all necessary surface fixtures and service connection components to make the lab function. Mock-up shall include one cabinet in each color finish selected and approved via sample process. Mock-up location shall be either in a conditioned trailer remaining on site throughout the project (provided by the contractor) or in a conditioned room within the new facility agreed upon by the Owner, Architect, Contractor and Lab Casework & Equipment Provider / Installer. Mock-up shall remain in place the duration of the project and if all components are acceptable, is permitted to become a part of the completed work. If the mock-up is located within a trailer, the components, if approved, may be relocated in the facility at a time approved by the Architect.

2. **12346 C Island Bench Structural Modules** specifies a 6" island structure extending below the worksurface and bolted to the floor. Island detail H/Q4.2 sections a 12" island structure to the floor. Please confirm that 12" island cores to the floor are required as detailed.

12" island cores are required as detailed.

3. 12346 3.01 C.2 requires cabinets to have integral leveling devices in the cabinet's bottom corners. Please approve traditional wood shims under the cabinet as an acceptable leveling device.

Traditional wood shims under wood cabinets are approved.

4. 12345 2.05 B.5 requires 6 horizontal sliding sashes on both sides with sashes on opposing faces to be interlocked so that only one side can be opened at a time. There are too many variations of sash arrangement to effectively interlock these horizontal sashes. Please confirm that horizontal sashes on do not need an interlock.

It is our understanding that interlock is required on opposite horizontal sashes so that the hood can only be operated with one side open at a time for proper containment.

5. **11600 Equipment List** states FH-021A and FH-021B Pass Through Walk-in Chemical Hoods for "hydrofluoric acid"; however, specification 12345 2.05 Pass-through walk-in chemical fume hoods does not list this requirement. Note, the 8' polypropylene hood FH-019

with scrubber notes "hydrofluoric acid". Please confirm the pass-through walk-in hoods do not require provisions for hydrofluoric acid.

FH-019, Polypropylene hood with scrubber requires revisions for Hydrofluoric Acid as specified. FH-021A & FH-021B, Pass-through walk-in chemical hoods DO NOT require revisions for Hydrofluoric Acid.

4. China Construction RFI:

Item 3: Spec section 12345 lists a solvent storage cabinet. I don't see any on the drawings. Is this cabinet the R03 cabinet tagged "Flammable Cabinet" on plan page Q0.1? If not, what is the spec for the R03 cabinet and are there any solvent storage cabinets required?

R03 is Flammable Cabinet as indicated on sheet Q0.1. There are many R03 cabinets in the project on both floors and their locations are clearly indicated on plan sheets Q2.0A, Q2.0B, & Q2.4A and on their related elevation sheets. Provide R03 cabinets as specified.

Item 4: Spec section 12345, section 2.05, paragraph 1 lists an Airclean polypropylene hood AC8030TE with scrubber. They do not make the AC8030TE with a scrubber. Is the standard AC8030TE without a scrubber acceptable?

NOT ACCEPTABLE without scrubber. The fume hood cut sheets and manufacturer website indicate "Mistline Scrubbers can usually be incorporated if any water-soluble Acid/Alkali are being used". Manufacturer considers the scrubber as an option that can be added to any fume hood if required. Provide fume hood with scrubber as specified.

5. Campbell Rhea RFI, dated 7/24/2013:

 Sheet Q4.2 – Left hand corner of sheet noting "Steel Casework Systems – Stainless Steel Floor-Mounted Base Cabinets". Please confirm all casework is to be wood veneer as noted by specifications 12346 or painted metal per specifications 12345. Details are also showing inset type of casework.

All casework is to be wood veneer as noted in specification 12346, or painted metal as noted in specification 12345. Will revise sheet noting on left hand corner to read: "Metal Casework System – Metal Floor-Mounted Base Cabinets".

2. Section 12346 – 2.03 A #1 – Style is described as "Casework shall be maple, square edge style construction as specified herein. Casework shall be full overlay construction where the door and drawers are routed to overlap the cabinet face frame with a square edge." Is a front face frame required? Campbellrhea casework is not routed to overlap the cabinet face (as detailed on Q4.1) but rest on the cabinet front in a flush overlay style. Only the doors are routed for hinges to achieve a consistent flush overlay.

Front face frame is NOT required. Routing is NOT required. Campbell Rhea casework description is acceptable.

3. Section 12346 – 2.03 D#1 noting wood shelves for Wall Mounted shelving systems. Detail 8/Q4.2 noting "stainless steel shelves". Detail 9/Q4.2 noting "adjustable metal shelves".

Please confirm W04 wall shelving requires veneer plywood shelving as specified & detailed per 15/Q4.1. If not the case, please indicate locations where details 8 & 9/Q4.2 may apply.

Shelving unit type W04 requires wood veneer plywood shelves as specified and detailed per 15/Q4.1. Will revise detail 8/Q4.2 and delete detail 9/Q4.2.

4. Sheet Q0.1 – W04 – This unit would seem to be similar to detail 15/Q4.1 when viewing front but elevation side views show detail similar to 9/Q4.2. Please confirm shelving configuration required. Will bookend brackets similar to detail 9/Q4.2 be acceptable for the W04? Note: Shelves are screwed to the brackets and do not require a lip on the brackets as specified or shown for detail 15/Q4.1.

Shelving unit type W04 requires wood veneer plywood shelves as specified and detailed per 15/Q4.1. Lips on brackets are required as shown on the detail. Bookend brackets are not acceptable for W04. Bookend brackets are only acceptable for reagent shelf unit type R01.

5. Section 12340 – 2.03 E5 c #3 indicates locks to be "grand master keys for lock". 5-disc tumbler locks can only be Master Keyed, not Grand master keyed. If grand master keying is required, locks need to be changed to 5-pin type.

Provide Pin type locks to be Grand Master keyed. Will revise spec section to indicate pin type.

6. Who is responsible for providing the Overhead service carriers? Service fixtures on OHSC? They are not specified in any of the Division 12 specifications.

OHSC details are indicated in sheet A6.5 and S1.0.

7. Who is responsible for panel mounted service fixtures on walls? Section 12309 Laboratory Service Fixtures specifications do not cover this type of service fixture neither by description nor model number. Will these be provided by Plumbing contractor or specialty gas subcontractor?

Wall mounted specialty gas fixtures are by the specialty gas contractor. Cold water, hose bib, and chilled water supply & return fixtures are by the plumbing contractor. Compressed Air is by casework contractor.

8. Section 12309 pg 4 Section 2.05 – Notes: All electrical outlets to be provided under Division 16-Electrical, unless noted otherwise. T07 table notes (2) electrical & (1) data box service. Is the lab casework responsible for the electrical/data receptacles in this unit?


Yes. Casework contractor shall provide table type T07 as pre-wired table. Electrical outlets and data outlet at the apron shall be pre-wired and provided with 8 ft. cord and plug for easy relocation. Electrical fixtures shall be 1/60/115V. All outlets on the table apron shall be complete with enclosure boxes, receptacle and cover plates. Cover plates shall be stainless steel. Table shall be provided with cleats so that the 8' cords can be wrapped up when not in use. Electrical and data outlet boxes shall be concealed and protected to prevent accidental contact of User's knees with electrical connections. Power extension cord is to be plugged into the power raceway above the table for power access. Data extension cord is to be plugged into the data outlet at wall above table.

9. Who is responsible for stainless steel sinks (Ref. S11-S13)? SS sinks are not covered under section 12340. Please confirm that section 12309 is still responsible for the fixtures at these sinks.

Sink type S11 is by MEP (See MEP drawings & specs). Sink types S12 & S13 are by the casework contractor.

10. Per Addendum #1 – AirMaster Systems is approved as a manufacturer for the hoods. Upon my conversation this morning with AMS, they are unable to provide the adjustable baffle that is noted as required. Thus, AMS will not be able to meet specifications.

Fume hoods shall be provided as specified with adjustable baffles.

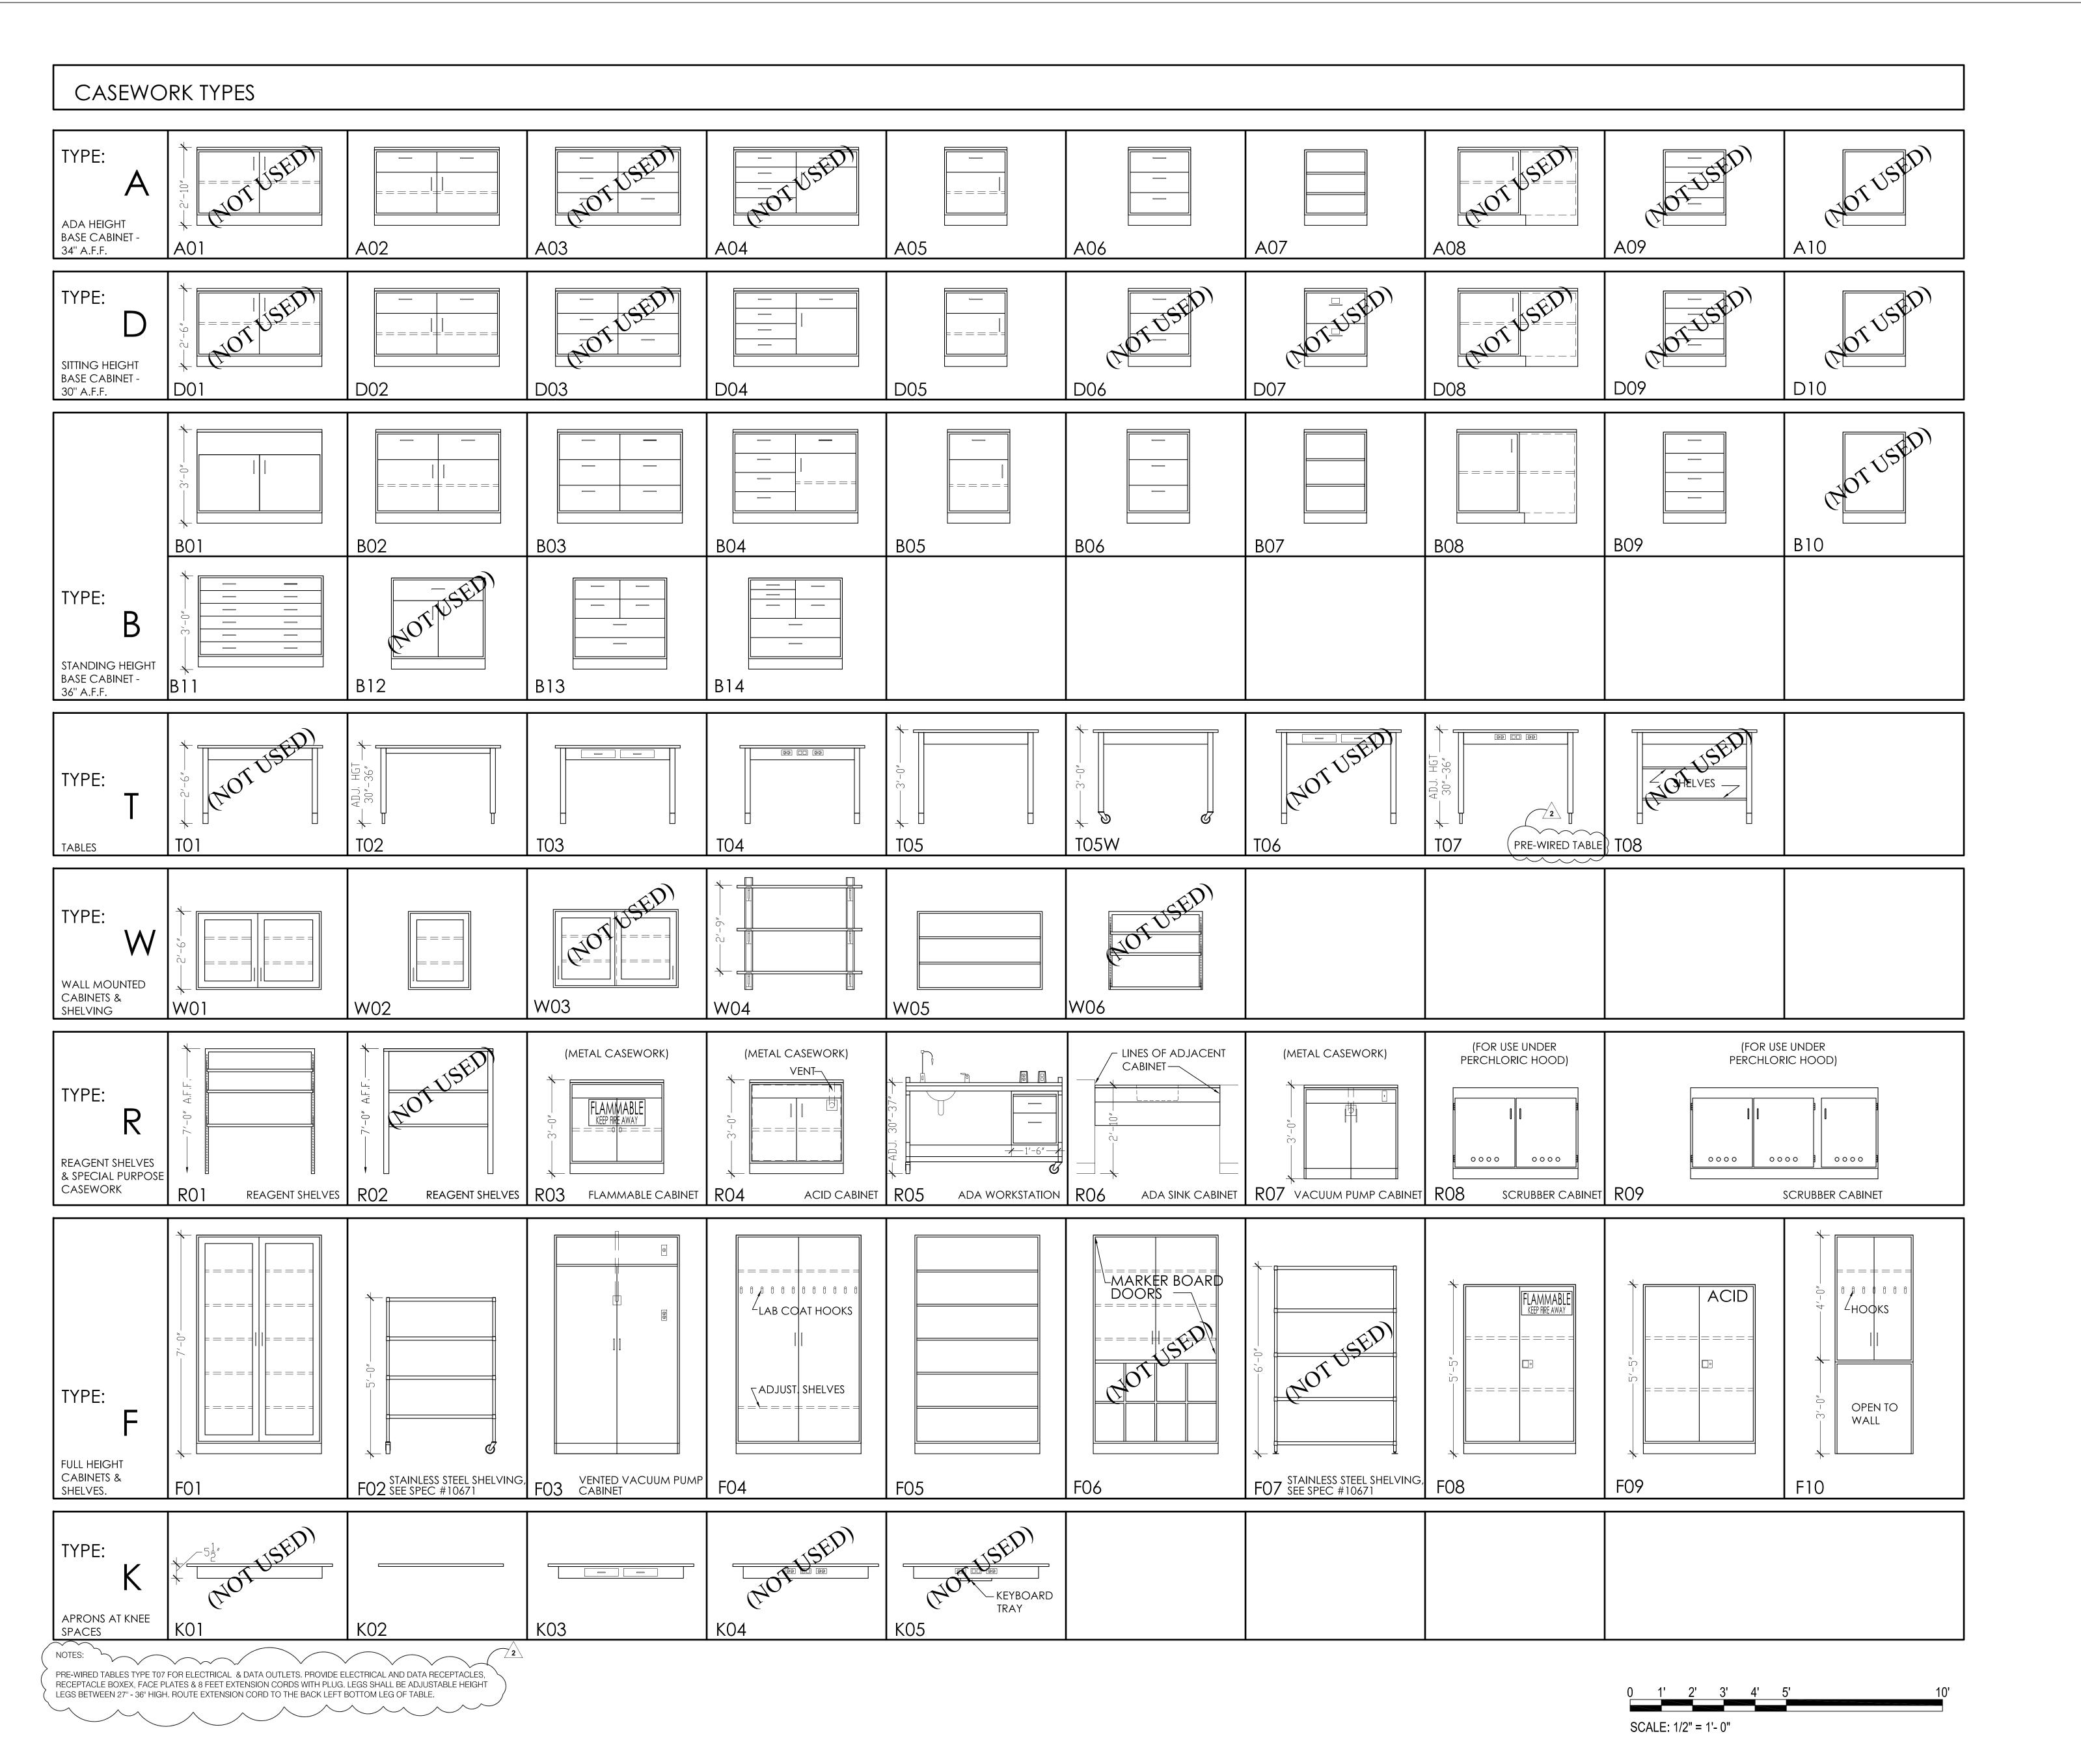



STATE PROJECT NO.: H27-6081-AC

HORIZON I GROUND & FOURTH FLOORS UPFIT

University of South Carolina 541 Main Street Columbia, South Carolina

REV. DATE DESCRIPTION

2 7/25/13 ADDENDUM #2



WATSON TATE SAVORY

Casework Types


P.O. BOX 8444. COLUMBIA, SC 29202 1316 WASHINGTON STREET. COLUMBIA, SC 29201


JUNE 17, 2013

These drawings are the property of Watson Tate Savory Architects and may not be used in whole or in part without written consent of the architects and any infringement is subject to legal action.

WTS NO.: 11700

BIDDING DOCUMENTS

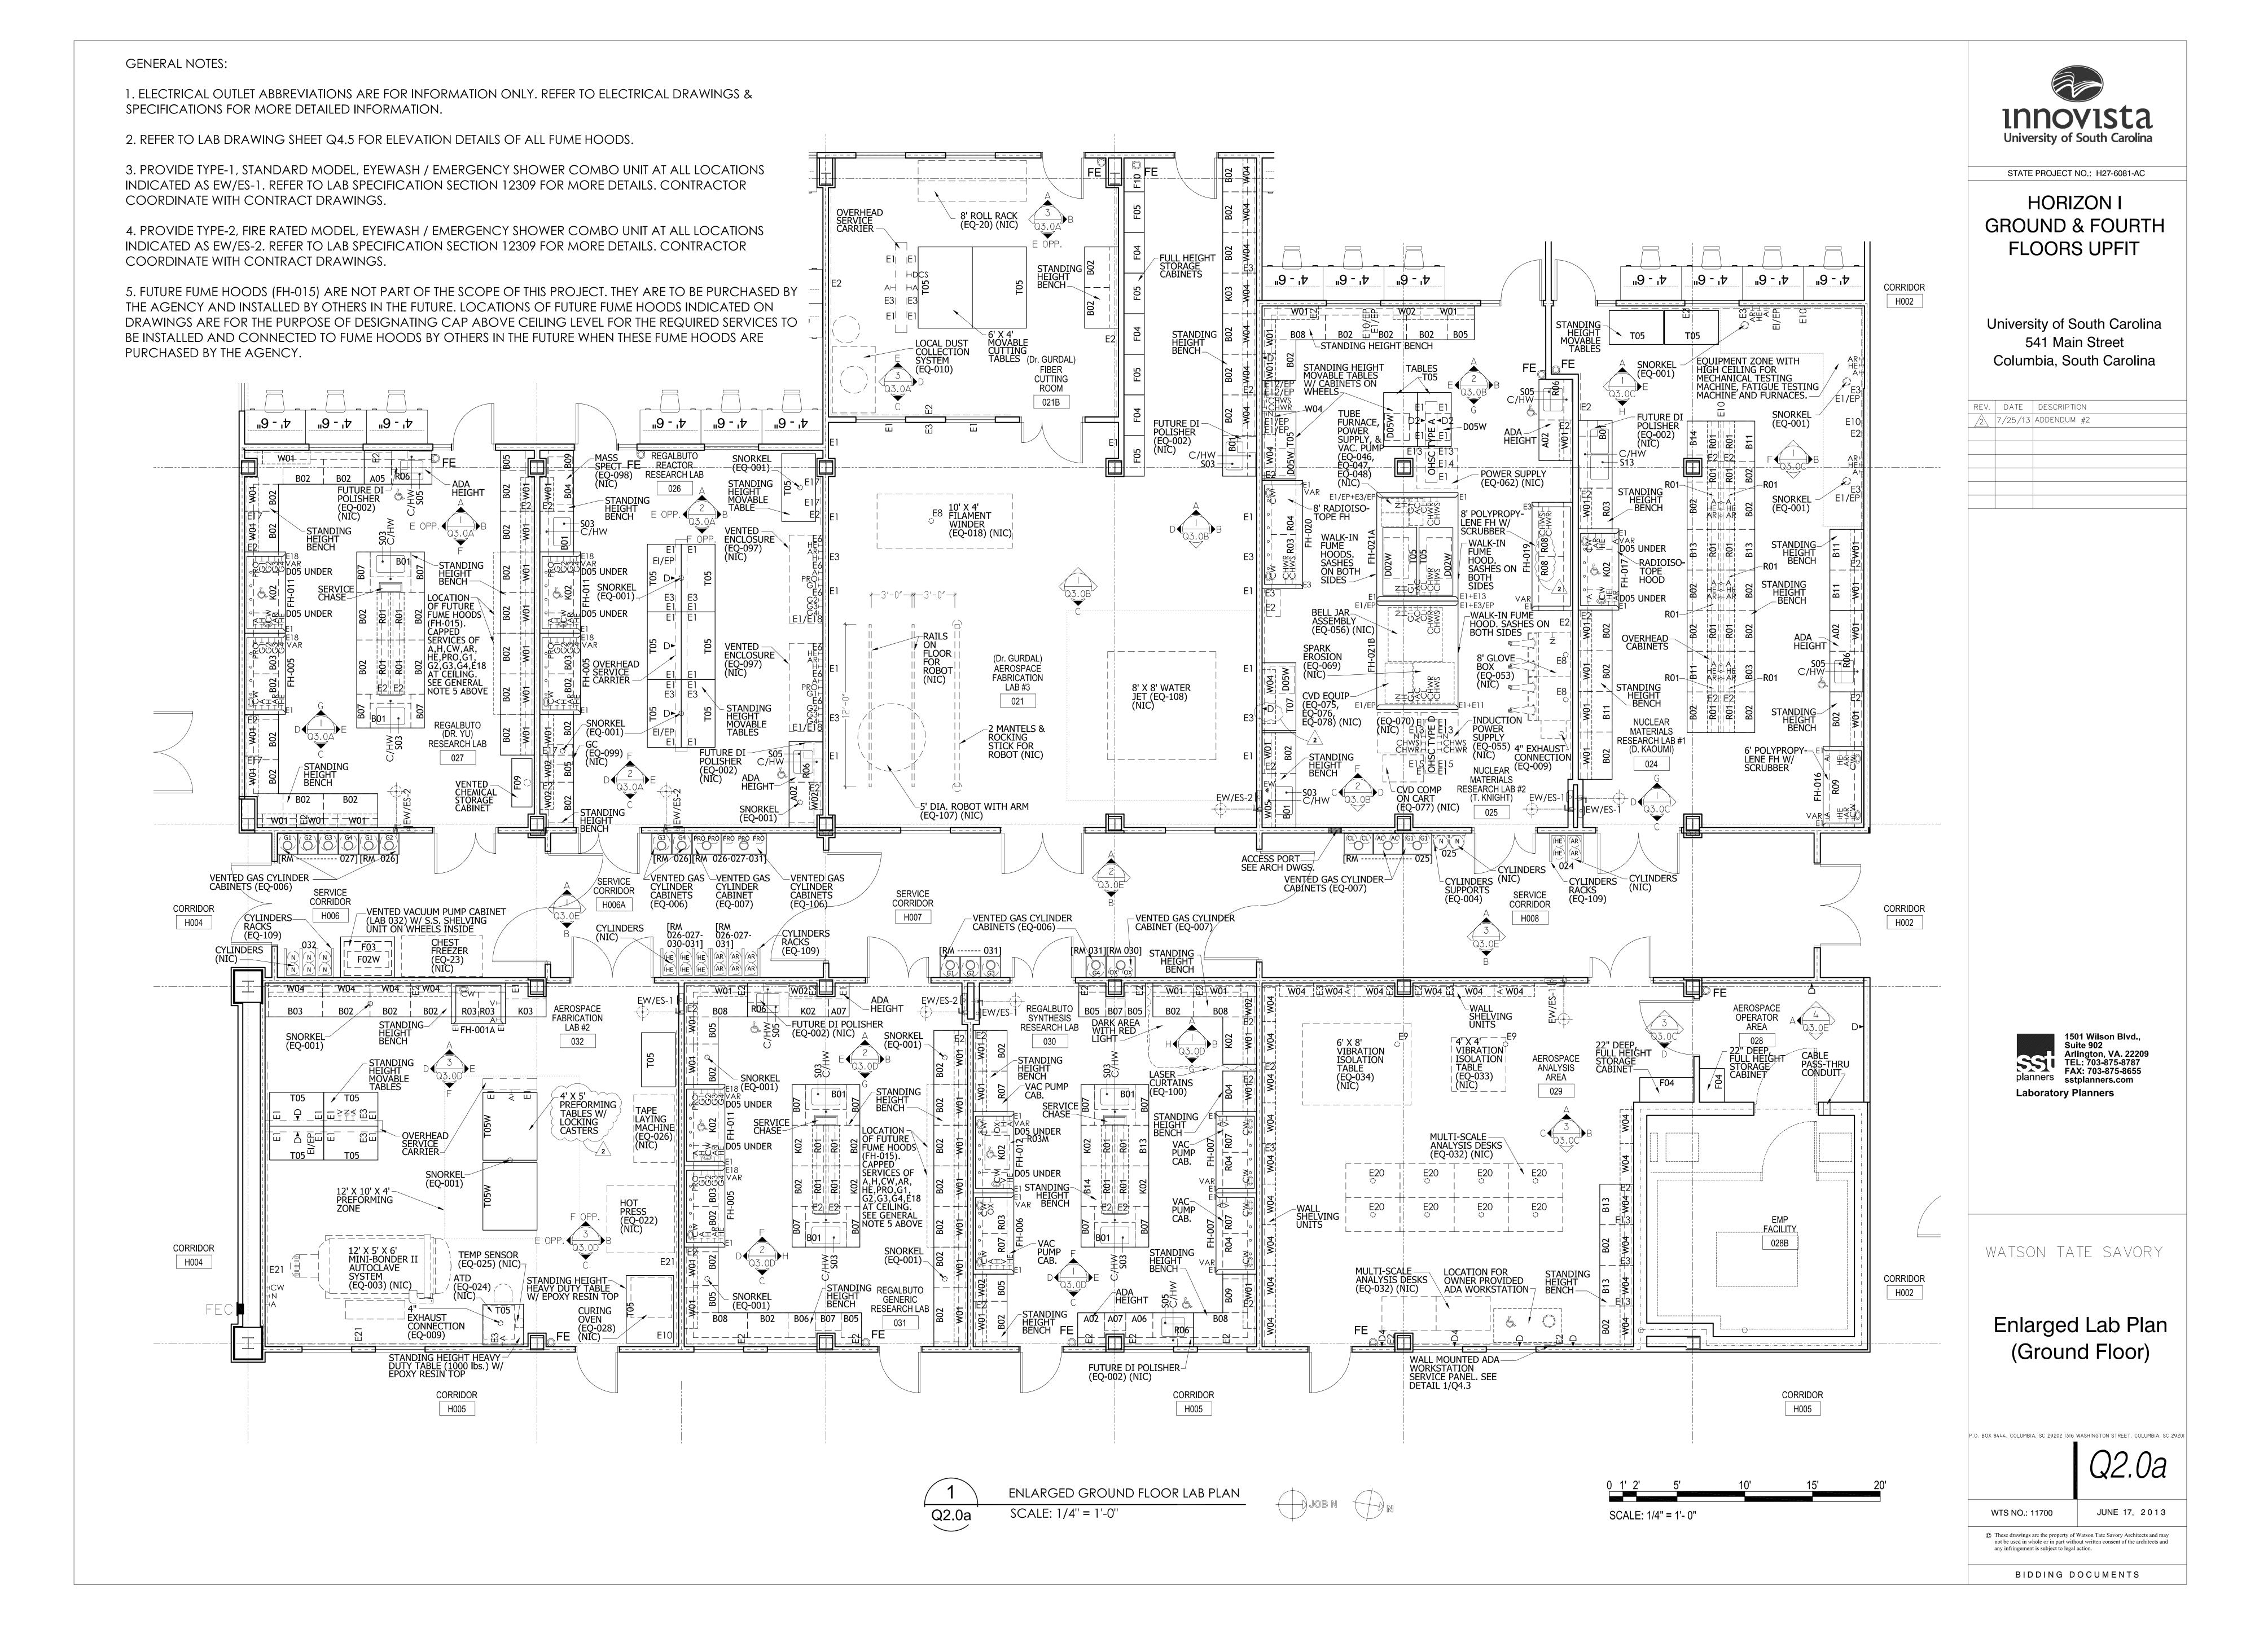

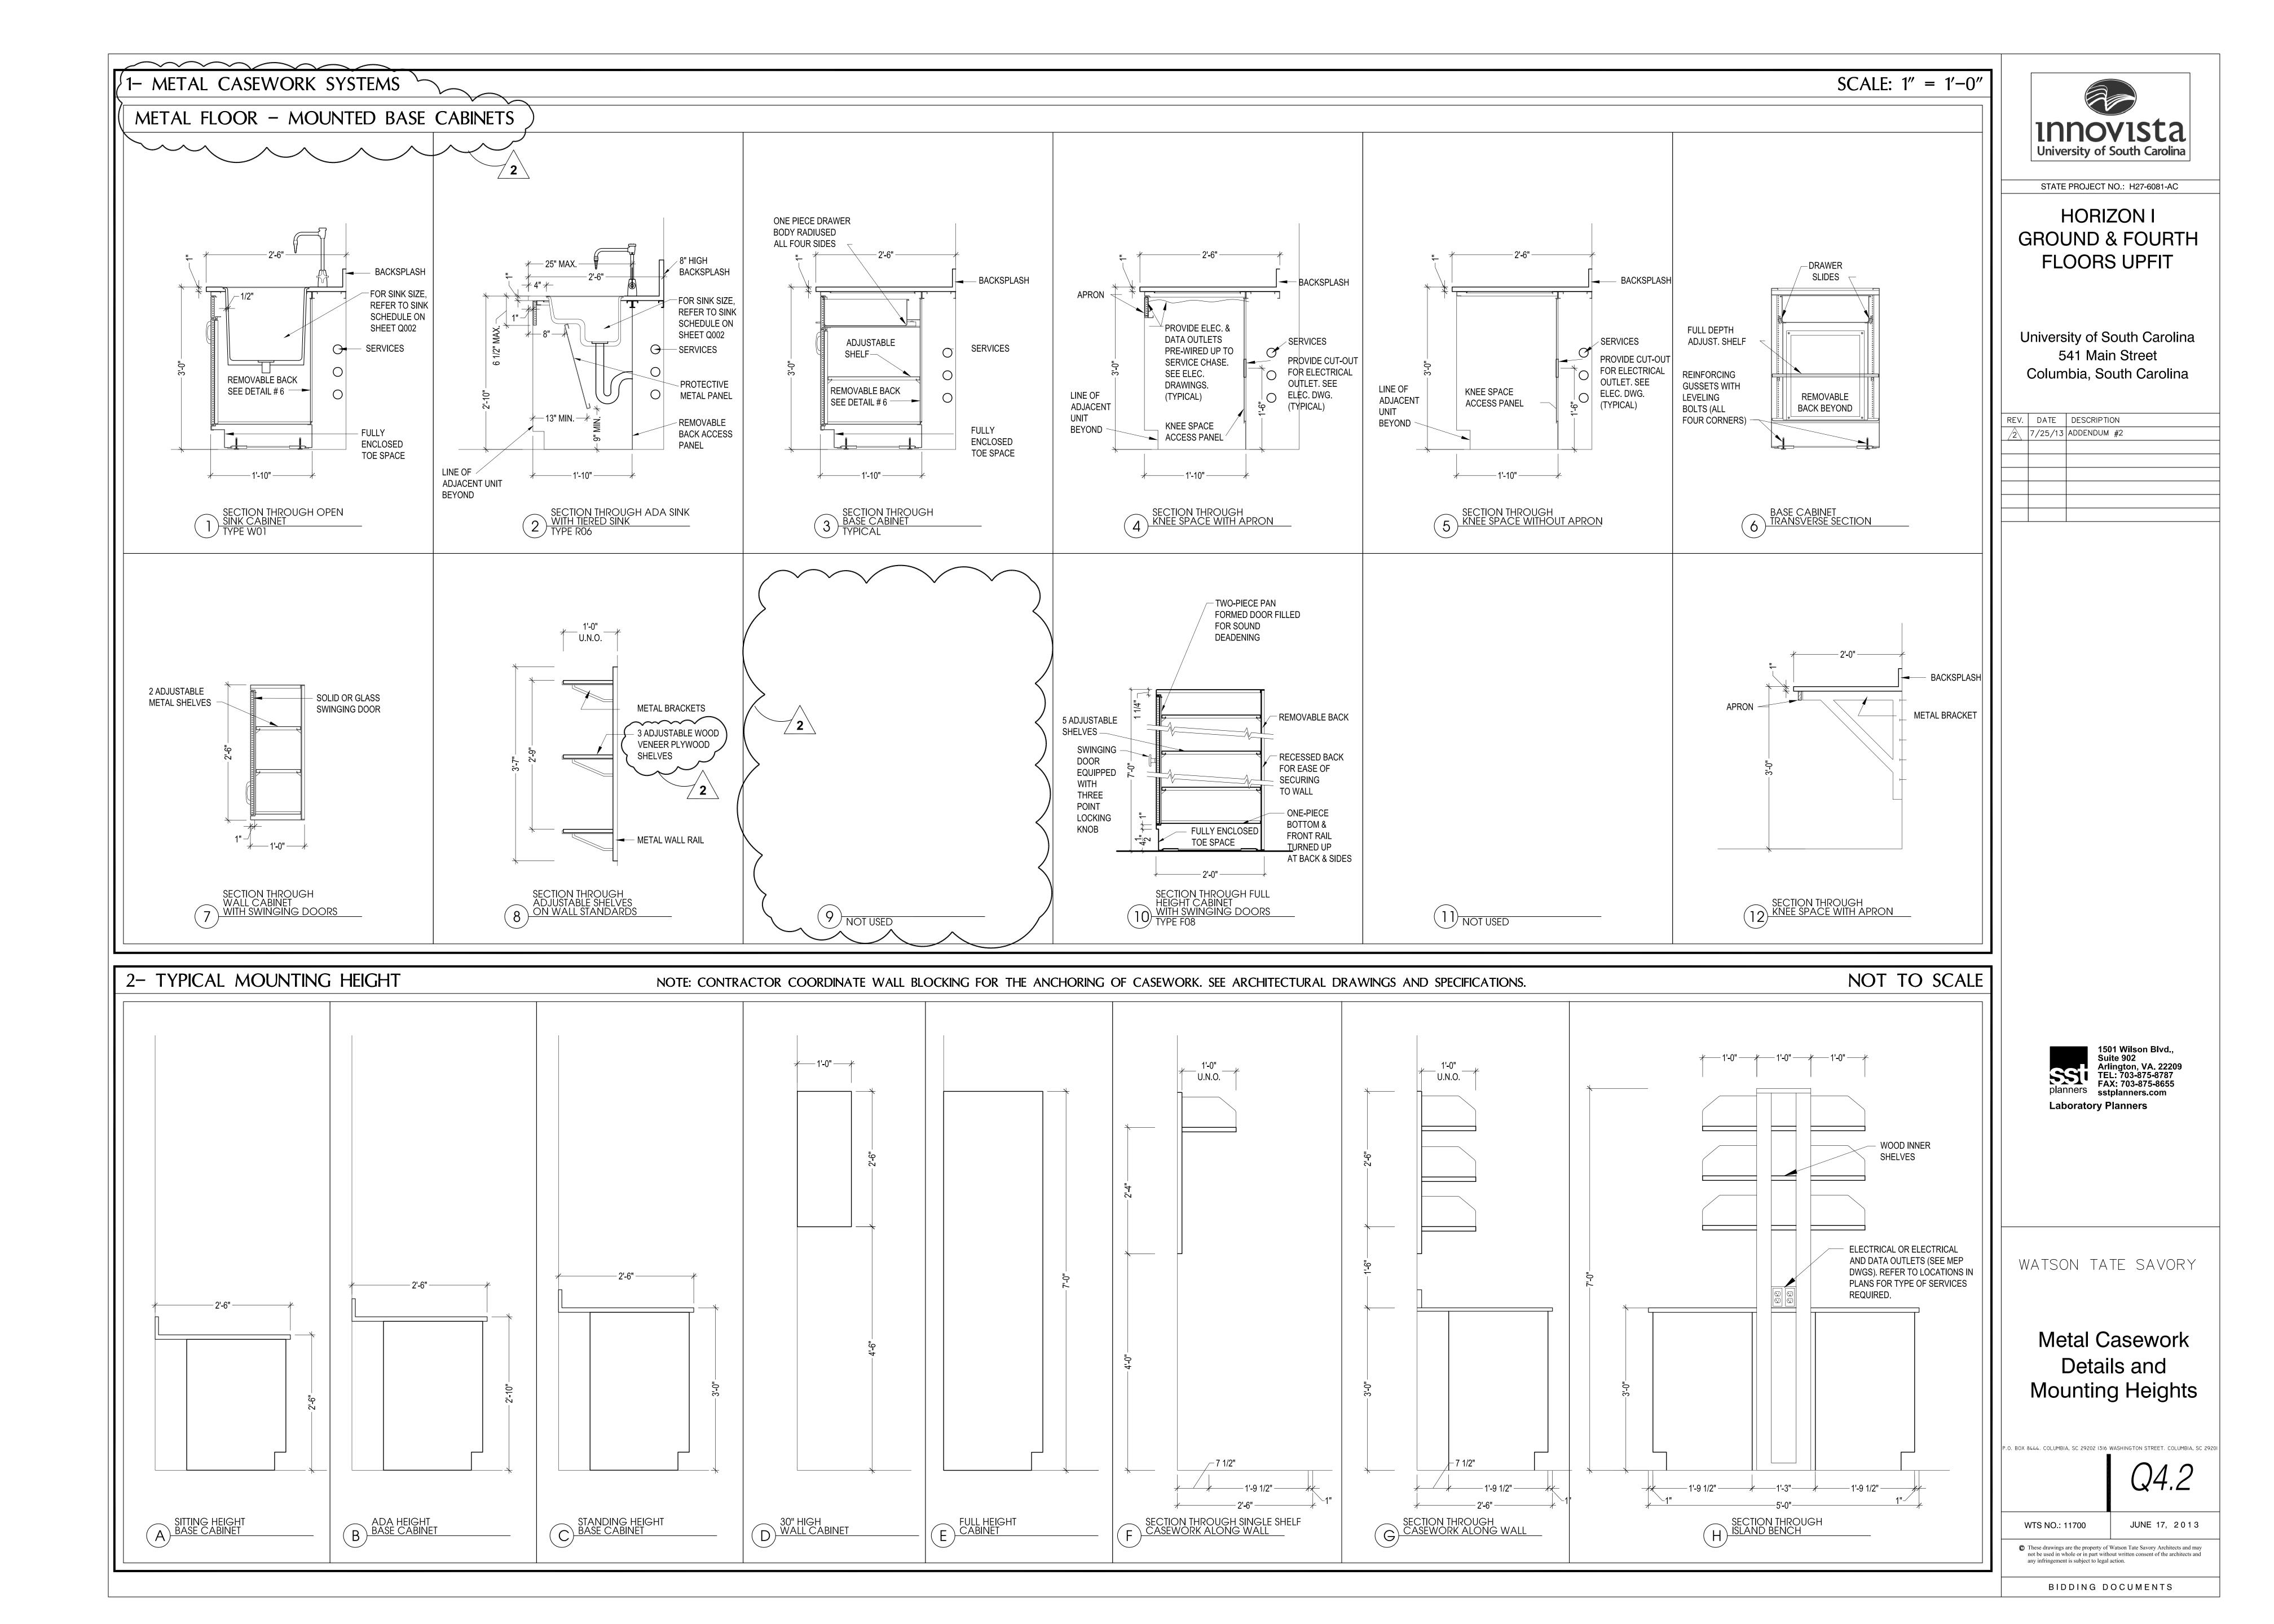

Date: July 25, 2013

RE: Watson Tate Savory Architects, Inc.

USC Horizon I Ground and Fourth Floors Upfit

To: Bidders: This addendum forms a part of the contract documents and modifies the

original Bidding Documents dated June 17, 2013. Acknowledge receipt of this

addendum in the space provided on the bid form.

From: SSOE Group

2520 Meridian Parkway, Suite 450

Durham, NC 27707 Phone: (919) 361-9606 Fax: (919) 484-8627

CLARIFICATIONS

Mechanical

Section 15410 - PLUMBING FIXTURES

1. Add Zurn as an acceptable manufacturer for Water Closets, Electric Water Cooler, Lavatories and Sinks.

Section 15725 - MODULAR INDOOR AIR-HANDLING UNITS

- 1. Add Temtrol as an acceptable manufacturer in paragraph 2.1.A.
- 2. Add paragraph 2.2.B to read as follows: "Unit shall be disassembled to fit through penthouse double doors (approximately 8' wide and 6' tall) and shall be field reassembled in the penthouse".

Section 15815 – METAL DUCTS

1. Add Turn Key Duct Systems as an acceptable manufacturer in paragraph 2.2.B.

Section 15820 – DUCT ACCESSORIES

1. Add Pottorff as an acceptable manufacturer in paragraphs 2.4.A and 2.7.A.

Section 15840 - AIR TERMINAL UNITS

1. Add Price and Critical Room Control as acceptable manufacturers in paragraph 2.2.A.

Section 15850 - FANS

- 1. Add MK Plastics and Twin City as an acceptable manufacturer in paragraph 2.2.A.
- 2. Revise paragraph 2.2.R to read as follows: "Fans EF-1C and EF-2C shall be mounted on existing Strobic Air Exhaust Plenum on the equipment platform on the roof".

Drawing M6.52

1. Revise Air Handling Unit Schedule as follows: revise chilled water entering temperature to 45 °F, revise cooling coil leaving air temperature to 52 DB °F and 51.9 WB °F, add Remark: cooling coil to be 8 row, 10 fpi coil.

Drawing MP1.01

1. Replace this drawing with drawing MP1.01 issued with this addendum.

Drawing MP1.41

1. Replace this drawing with drawing MP1.41 issued with this addendum.

Drawing P1.41

1. Replace this drawing with drawing P1.41 issued with this addendum.

Drawing P7.00

1. Replace this drawing with drawing P7.00 issued with this addendum.

Drawing P7.40

1. Replace this drawing with drawing P7.40 issued with this addendum.

Addendum Clarifications:

- 1. Who is responsible for the overhead service carriers? The items are not covered in any specifications that I can find. OHSC are not detailed either for configuration, etc. The floor plan and elevations are showing units dashed in. Is the mechanical contractor providing these items? Response: Overhead service carriers shall be as shown on A6.5 and S1.0.
- 2. Will the plumber be responsible for the stainless steel sinks? (Ref. S11 S14). The 12340 section does not cover stainless steel sinks except for the sink strainer & tailpiece which is noted by division 15. **Response: No. Division 15 contractor will provide S-11 sink as specified on P0.01, all other sinks are by lab casework supplier.**
- 3. Section 12309 Lab Service Fixtures the specifications cover deck mounted fixtures, female quick disconnects for ADA cart, fume hood fixtures, safety showers, and deck mounted eyewashes. Will the plumber be responsible for the wall mounted service fixtures? Response: No, plumber will provide as indicated on P drawings and al others are by lab casework supplier.
- 4. Confirm that existing sprinkler heads are standard coverage, <u>NOT</u> extended coverage. Response: Existing heads are standard coverage heads.
- 5. Confirm that existing sprinkler system in all areas of work are Ordinary Hazard I or greater (as applicable), <u>NOT</u> Light Hazard. Response: All heads are ordinary hazard or greater.
- 6. Are there any specific durations / hours by the Owner for draining down the system, placing in test mode, performing work, and placing back in service each day? Response: No, work shall be coordinated with owner and shall not limit use of existing floors.
- 7. Are we to assume that work called out on the fire pump is to be performed during after hours when the building is not occupied? **Response: That is correct, work will need to be scheduled and coordinated with the owner.**
- 8. Will we need to account for a new fire pump start up/acceptance test with a field manufacturer rep after adjusting the psig's on the fire pump and jockey pump as required per the Fire Sprinkler Specification Sheet issued within Specification Section 15500?

 Response: Yes, to confirm work has been performed.

- 9. Will there be an elevator accessible for construction use? If so, what is the size? Response: Yes, elevator #3 (freight elevator) is available for contractor use. See Addendum 1, Pre-bid minutes item C-2...contractors have had a chance to visit the site and verify elevator #3 is 6' wide by 9'-5" deep.
- 10. Will the as-builts and hydraulic calculations of existing system be available in CAD format to the awarded FP Subcontractor to utilize in design? **Response: Hard copies are available, CAD drawings are NOT available.**
- 11. I do not see a detail of the air handler showing what sections/etc are required. The plan view drawing shows Mixing Box/ Filter/ Hot Water Coil/ Access/ Chilled Water Coil/Access/ Supply Fan/? Response: Unit components should be mixing section, prefilters/ final filters, hot water preheat coil, access section, chilled water cooling coil, supply fan, discharge plenum.
- 12. The lab exhaust fans tagged EF-1C and EF-2C are scheduled 60,000CFM- Strobic Model TS4L600C12. Please confirm that the fan model#/ CFM is correct and/or advise dimensions of this fan. Response: EF-1C/2C are scheduled for 40,000 cfm. Existing fans EF-1A/1B, EF-2A/2B are Strobic Air TS4L400A12 and existing plenums have space for 1 additional fan be added.
- 13. Could you please clarify where the Hammer Arrestors are to be placed on the above-mentioned project is it at every fixture or just the fast closing valves (like water closets, flush valves, etc.)? **Response: Only at fast closing valves.**

Electrical

Section 16231- PACKAGED ENGINE GENERATOR

1. Generator Set Start Module is not required. Delete section 2.3 (L)(6).

Drawing EP1.01

1. Add junction and circuit in service corridor for Gas Detection Panel. Add note 15. Replace this drawing with drawing EP1.01 in this addendum.

Drawing EP1.41

1. Add junction and circuit in service corridor for Gas Detection Panel. Add note 10. Replace this drawing with drawing EP1.01 in this addendum.

Drawing E6.01

- 1. Panel RP-0E2 Delete hatching to clarify as new circuits.
- 2. Panel RP-0C9 Revise GFCI breaker triangle location.
- Panel URP-0C7 Add Gas Detection Panel circuit.

Drawing E6.41

- 1. Panel RP-4E2
 - a. Delete hatching to clarify as new circuits.
 - b. Revise GFCI breaker triangle location.
- Panel URP-4C6.5 Add Gas Detection Panel circuit.

Drawing EP5.61

1. Add keynote 1 for panel ERP-0D2, ERP-1E2, ERP-2E2, ERP-3E2, and ERP-4E2. Replace this drawing with drawing EP5.61 in this addendum.

Drawing EP5.64

1. Clarify requirements for remote annunciator for manufacturer other than Caterpillar. Replace this drawing with drawing EP5.64 in this addendum.

Drawing ET1.01

1. Add data outlet to lab 025. Replace this drawing with drawing ET1.01 in this addendum.

Drawing ET3.01

1. Revise note G, General Contractor. to provide fire-stopping. Replace this drawing with drawing ET3.01 in this addendum.

Addendum Clarifications:

- 1. A1.01 indicates that the contractor is to relocate existing electrical and data as required to install new footings where the floor was previously cut and patched to install the electrical and data. There isn't any information on the plans that indicate what the electrical or data is for or where it is going/coming from.
 - a. For the electrical circuits that might be encountered, please indicate the circuit number and where it is feed from and going to so that the amount of new conduit and wire can be calculated.
 - b. For the data please indicate the same as above. Is the data to be included in this project as the data on the rest of the project is by others.


Response: The buried electrical is communication cabling for area of rescue twoway communication stations at stairwells. Contractor to coordinate with Owner for

nearest tie-in location where cables can be disconnected and conduits/cabling rerouted around new foundation slab indicated on sheet A1.01.

2. The electrical drawing indicate that the fire stopping is to be by the general contractor except on the addendum #1 sheet ET3.01 where it states it is by the electrical contractor. The mechanical drawings do not seem to indicate that the fire stopping is to be by the general contractor. The electrical contractor is the only one that can tell how many penetration that will be required for their work as the routing of the piping isn't indicated on their drawings and each different electrical contractor is subject to run their work in a different manner that effects the amount of penetrations. As it is normal for the trades to include fire stopping for there penetrations, please remove the note indicating that it is to be by the general contractor.

Response: Firestopping is required to be by General Contractor. See updated sheet ET3.01

END OF ADDENDUM

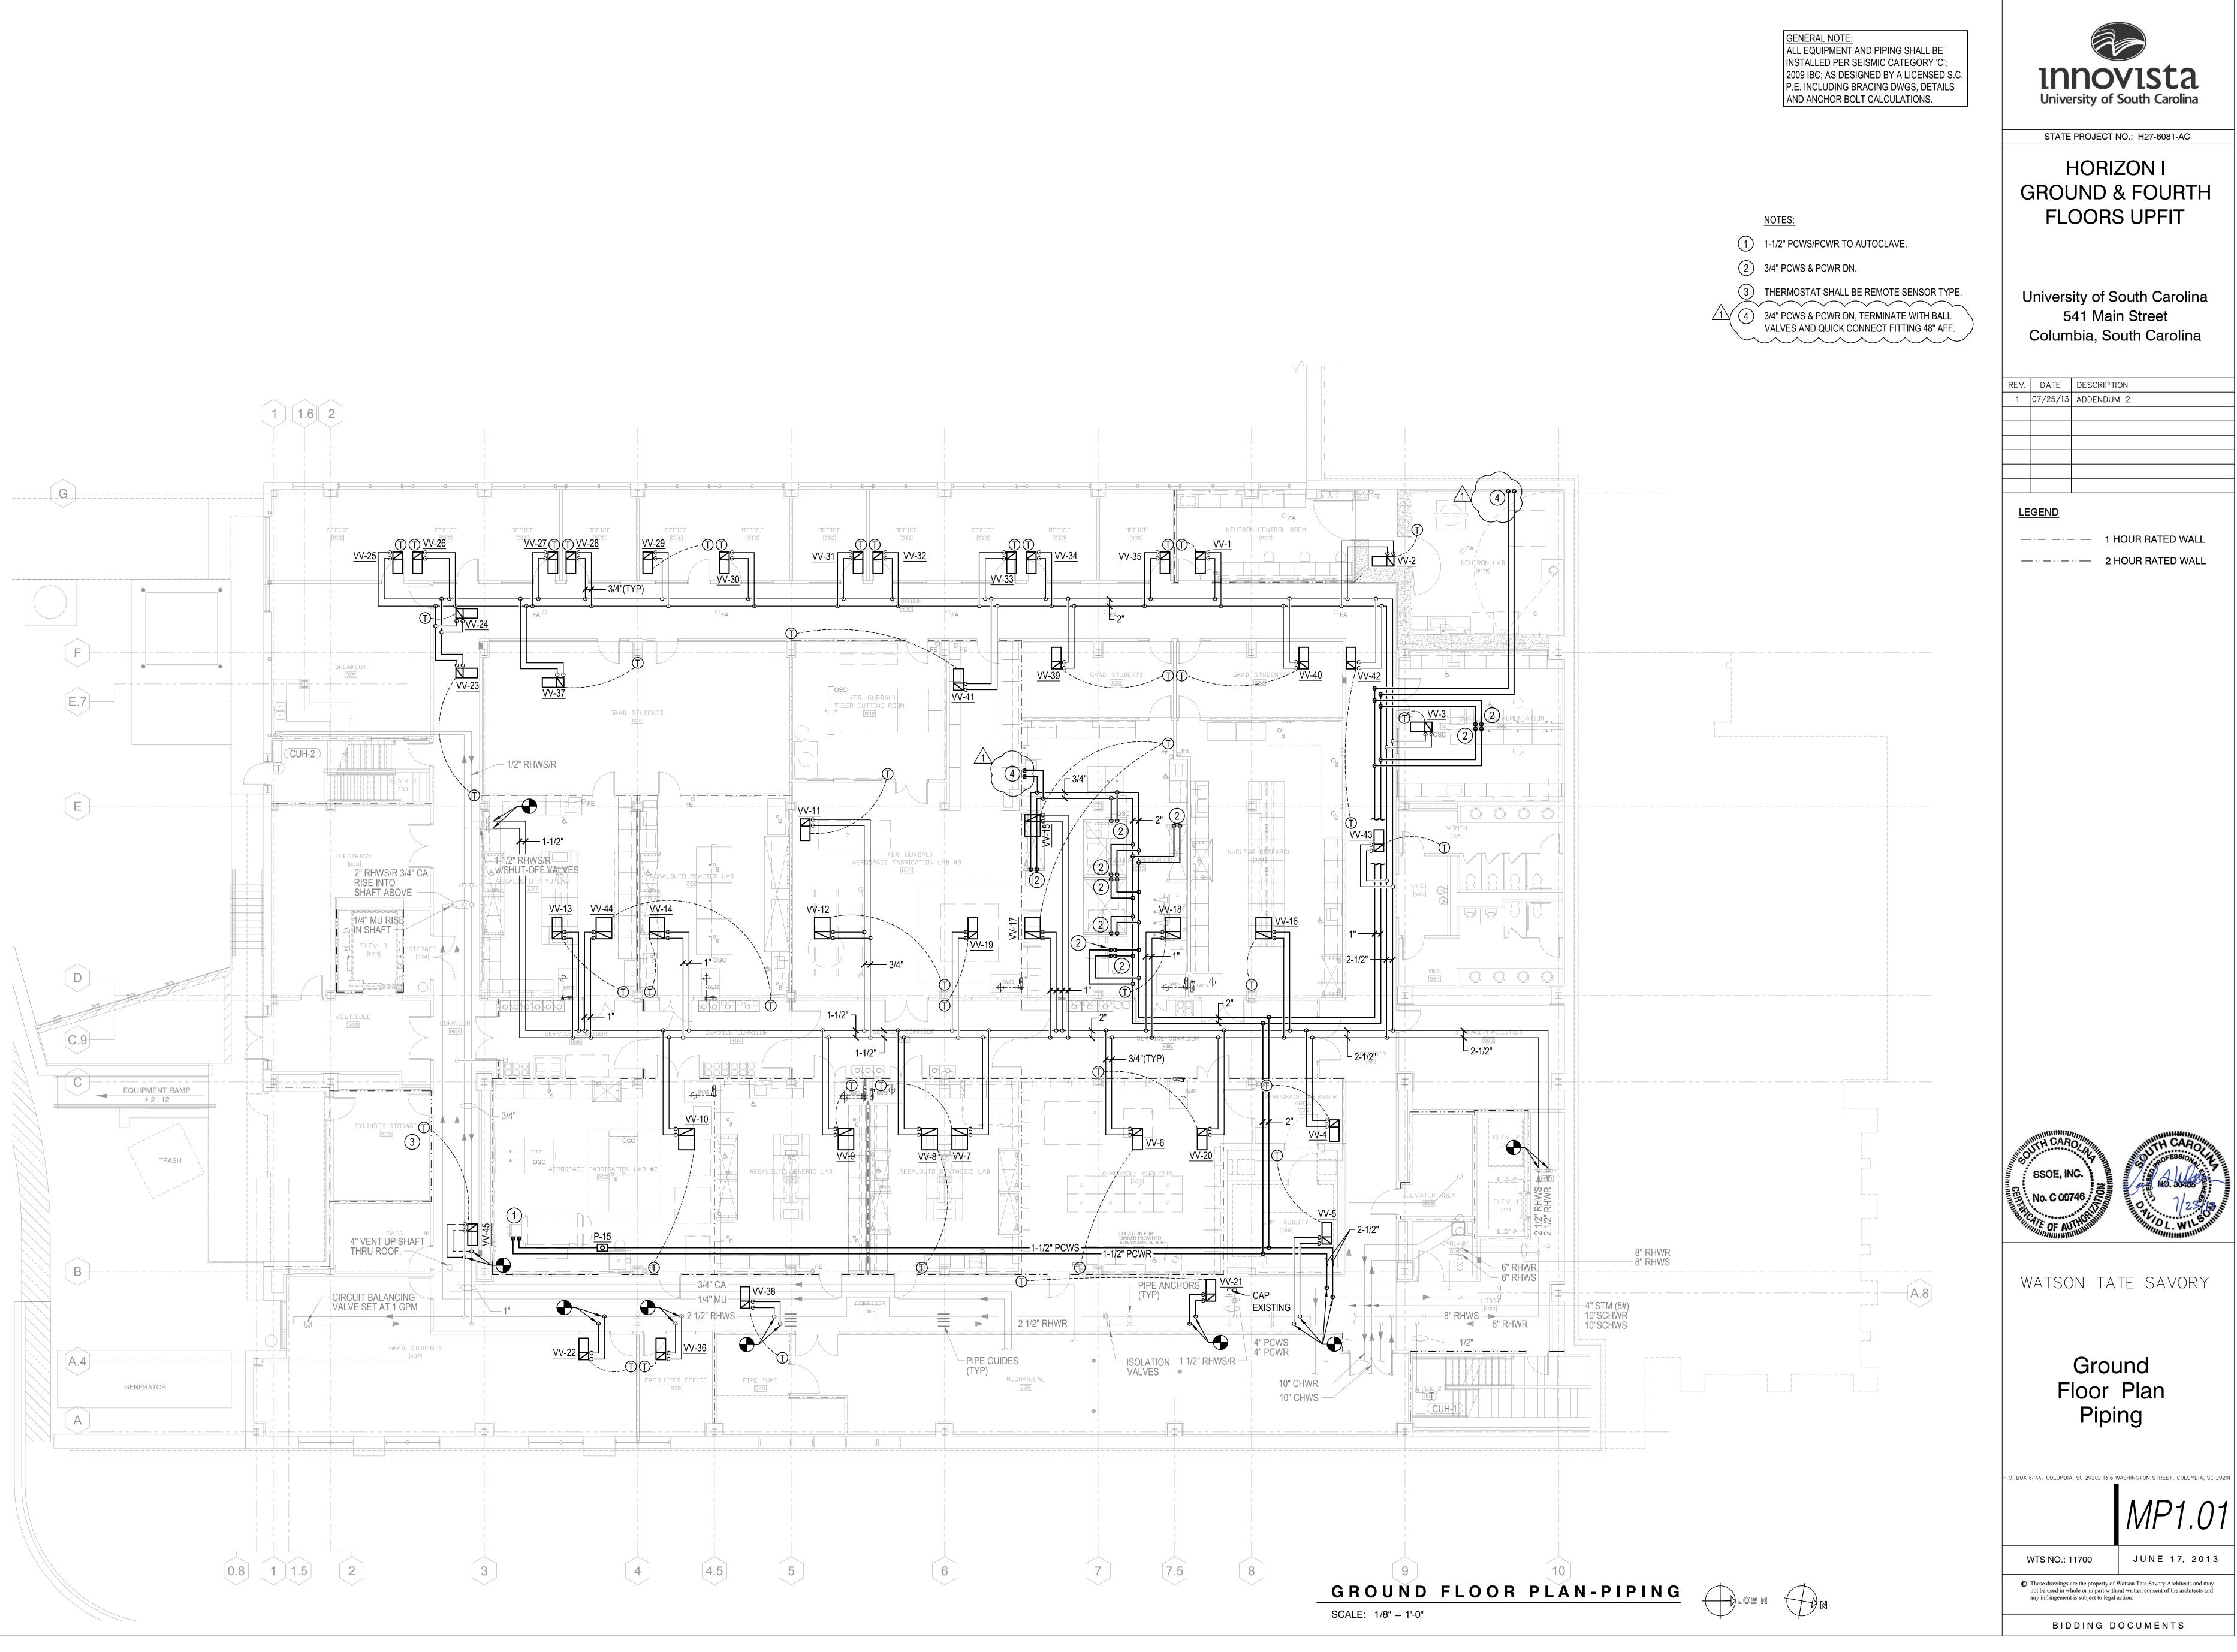




STATE PROJECT NO.: H27-6081-AC

HORIZON I **GROUND & FOURTH FLOORS UPFIT**

University of South Carolina 541 Main Street Columbia, South Carolina

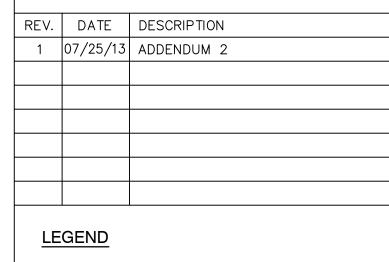

—····· 1 HOUR RATED WALL — ·· – ·· – ·· 2 HOUR RATED WALL





WATSON TATE SAVORY

Ground Floor Plan Piping

JUNE 17, 2013 © These drawings are the property of Watson Tate Savory Architects and may not be used in whole or in part without written consent of the architects and

BIDDING DOCUMENTS

GENERAL NOTE: ALL EQUIPMENT AND PIPING SHALL BE INSTALLED PER SEISMIC CATEGORY 'C'; 2009 IBC; AS DESIGNED BY A LICENSED S.C. P.E. INCLUDING BRACING DWGS, DETAILS AND ANCHOR BOLT CALCULATIONS.

NOTES:

(1) 3/4" PCWS & PCWR DN



STATE PROJECT NO.: H27-6081-AC

HORIZON I **GROUND & FOURTH**

University of South Carolina 541 Main Street Columbia, South Carolina

—·—·—·— 1 HOUR RATED WALL

— ·· – ·· – ·· 2 HOUR RATED WALL


REV. DATE DESCRIPTION 1 07/25/13 ADDENDUM 2

<u>LEGEND</u>

FLOORS UPFIT

2) 3/4" PCWS & PCWR DN, TERMINATE WITH BALL VALVES AND QUICK CONNECT FITTING 48" AFF. 1 1.6 2 E.7 D.8 C.9 7.5 FOURTH FLOOR PLAN-PIPING

SCALE: 1/8" = 1'-0"

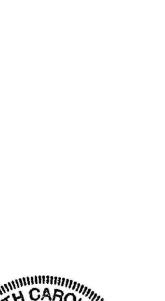



WATSON TATE SAVORY

Fourth Floor Plan Piping

P.O. BOX 8444. COLUMBIA, SC 29202 1316 WASHINGTON STREET. COLUMBIA, SC 29201



JUNE 17, 2013 WTS NO.: 11700

© These drawings are the property of Watson Tate Savory Architects and may not be used in whole or in part without written consent of the architects and any infringement is subject to legal action.

BIDDING DOCUMENTS

PLAN NOTES: (THIS DRAWING ONLY) (15) ETR (2) 3/4" RELIEF VENTS UP (1) SEE DWG. P001 FOR LEGEND, GENERAL NOTES, AND FIXTURE SCHEDULE. 2) SLOPE PIPING AT 1/8" (1.0%) PER FOOT. (16) 1 1/4" DCW, 1 1/4" DHW DOWN - (2) 3/4" TO HEADERS SERVING LAVS (3) SLOPE PIPING AT 1/4" (2.0%) PER FOOT. (17) 1 1/4" DCW, 1 1/4" DHW DOWN - (2) 3/4" TO HEADERS SERVING LAVS; 1/2" TO ETP TRAP PRIMER & FD $\overline{(4)}$ SLOPE PIPING AT 1/2" (4.0%) PER FOOT. (18) ETR 3" SAN, 2" V STACK, 3/4" DCW & 3/4" DHW DOWN (5) CTE 1 1/2" VALVED AND CAPPED CA CONNECTION WITH NEW 1 1/2" CA. (19) PROVIDE 1/2" DCW SUPPLY WITH 1/4" O.D. COMPRESSION OUTLET FOR (6) PIPING ABOVE CEILING. COUNTER-MOUNTED COFFEE MAKER FROM SINK DCW SUPPLY. PROVIDE (7) HATCHED AREA NOT IN CONTRACT. REFER TO LEGEND ON DRAWING P0.01. 1/2" DCW SUPPLY FOR ICE MAKER CONNECTION AT REFRIGERATOR. PROVIDE GUY GRAY ICE MAKER BOX MODEL NO. BIM875 WITH 1/4" O.D. (8) ETR 5) 1/2" DCW FROM ELECTRONIC TRAP PRIMER TO FLOOR DRAINS. COMPRESSION OUTLET AT 48" AFF BEHIND REFRIGERATOR. (9) 1/2" DHW, 1/2" DCW, 2" V (20) ETR 4" ST-UP TO EXISTING 4" RD-1 ABOVE (10) 2" DHW (125°F) 21) ETR 4" STODP-UP TO EXISTING 4" RD-2 ABOVE 3" DCW UP (1) ETR 3/4" DCW UP TO HB-1 & TRAP PRIMER. (22) NEW 1-1/2" CA RISER - UP & DN (12) SLEEVE AND SEAL ALL PIPES THROUGH WALLS. (23) ETR 3" ST-UP TO EXISTING 3" RD-1 ABOVE (13) BALANCE VALVE WITH MEMORY STOP; SHUTOFF: SET AT 6.0 GPM 24) ETR 3" STODP-UP TO EXISTING 3" RD-2 ABOVE B&G MODEL – CB – 3/4" S (25) INSTALL 3" DCW DOWN TO 3RD FLOOR WITH 2" DCW HEADER SERVING (14) PIPING SHALL BE INSTALLED ABOVE OTHER PIPES, DUCTS, ETC. WATER CLOSETS & URINALS ON FOURTH FLOOR (26) ALL EQUIPMENT AND PIPING SHALL BE INSTALLED PER SEISMIC CATEGORY 'C'; 2006 IBC. (27) PLUG EXISTING FLOOR DRAIN E.7 ETR 4"--/ └─ETR 4" ∕7.40A [`] P7.40 GRAD. STUDENTS E.3 411 2" SAN STACK 1 1/2" V STACK


GENERAL NOTE: ALL EQUIPMENT AND PIPING SHALL BE INSTALLED PER SEISMIC CATEGORY 'C'; 2009 IBC; AS DESIGNED BY A LICENSED S.C. P.E. INCLUDING BRACING DWGS, DETAILS AND ANCHOR BOLT CALCULATIONS.




STATE PROJECT NO.: H27-6081-AC

HORIZON I **GROUND & FOURTH FLOORS UPFIT**

University of South Carolina 541 Main Street Columbia, South Carolina

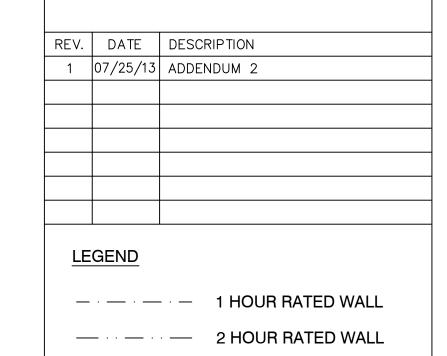



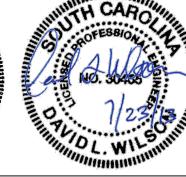

WATSON TATE SAVORY

Plumbing


P.O. BOX 8444. COLUMBIA, SC 29202 1316 WASHINGTON STREET. COLUMBIA, SC 29201

JUNE 17, 2013 WTS NO.: 11700

© These drawings are the property of Watson Tate Savory Architects and may not be used in whole or in part without written consent of the architects and any infringement is subject to legal action.

BIDDING DOCUMENTS

FOURTH FLOOR PLAN-PLUMBING FFE 166.00' (319.00') SCALE: 1/8" = 1'-0"

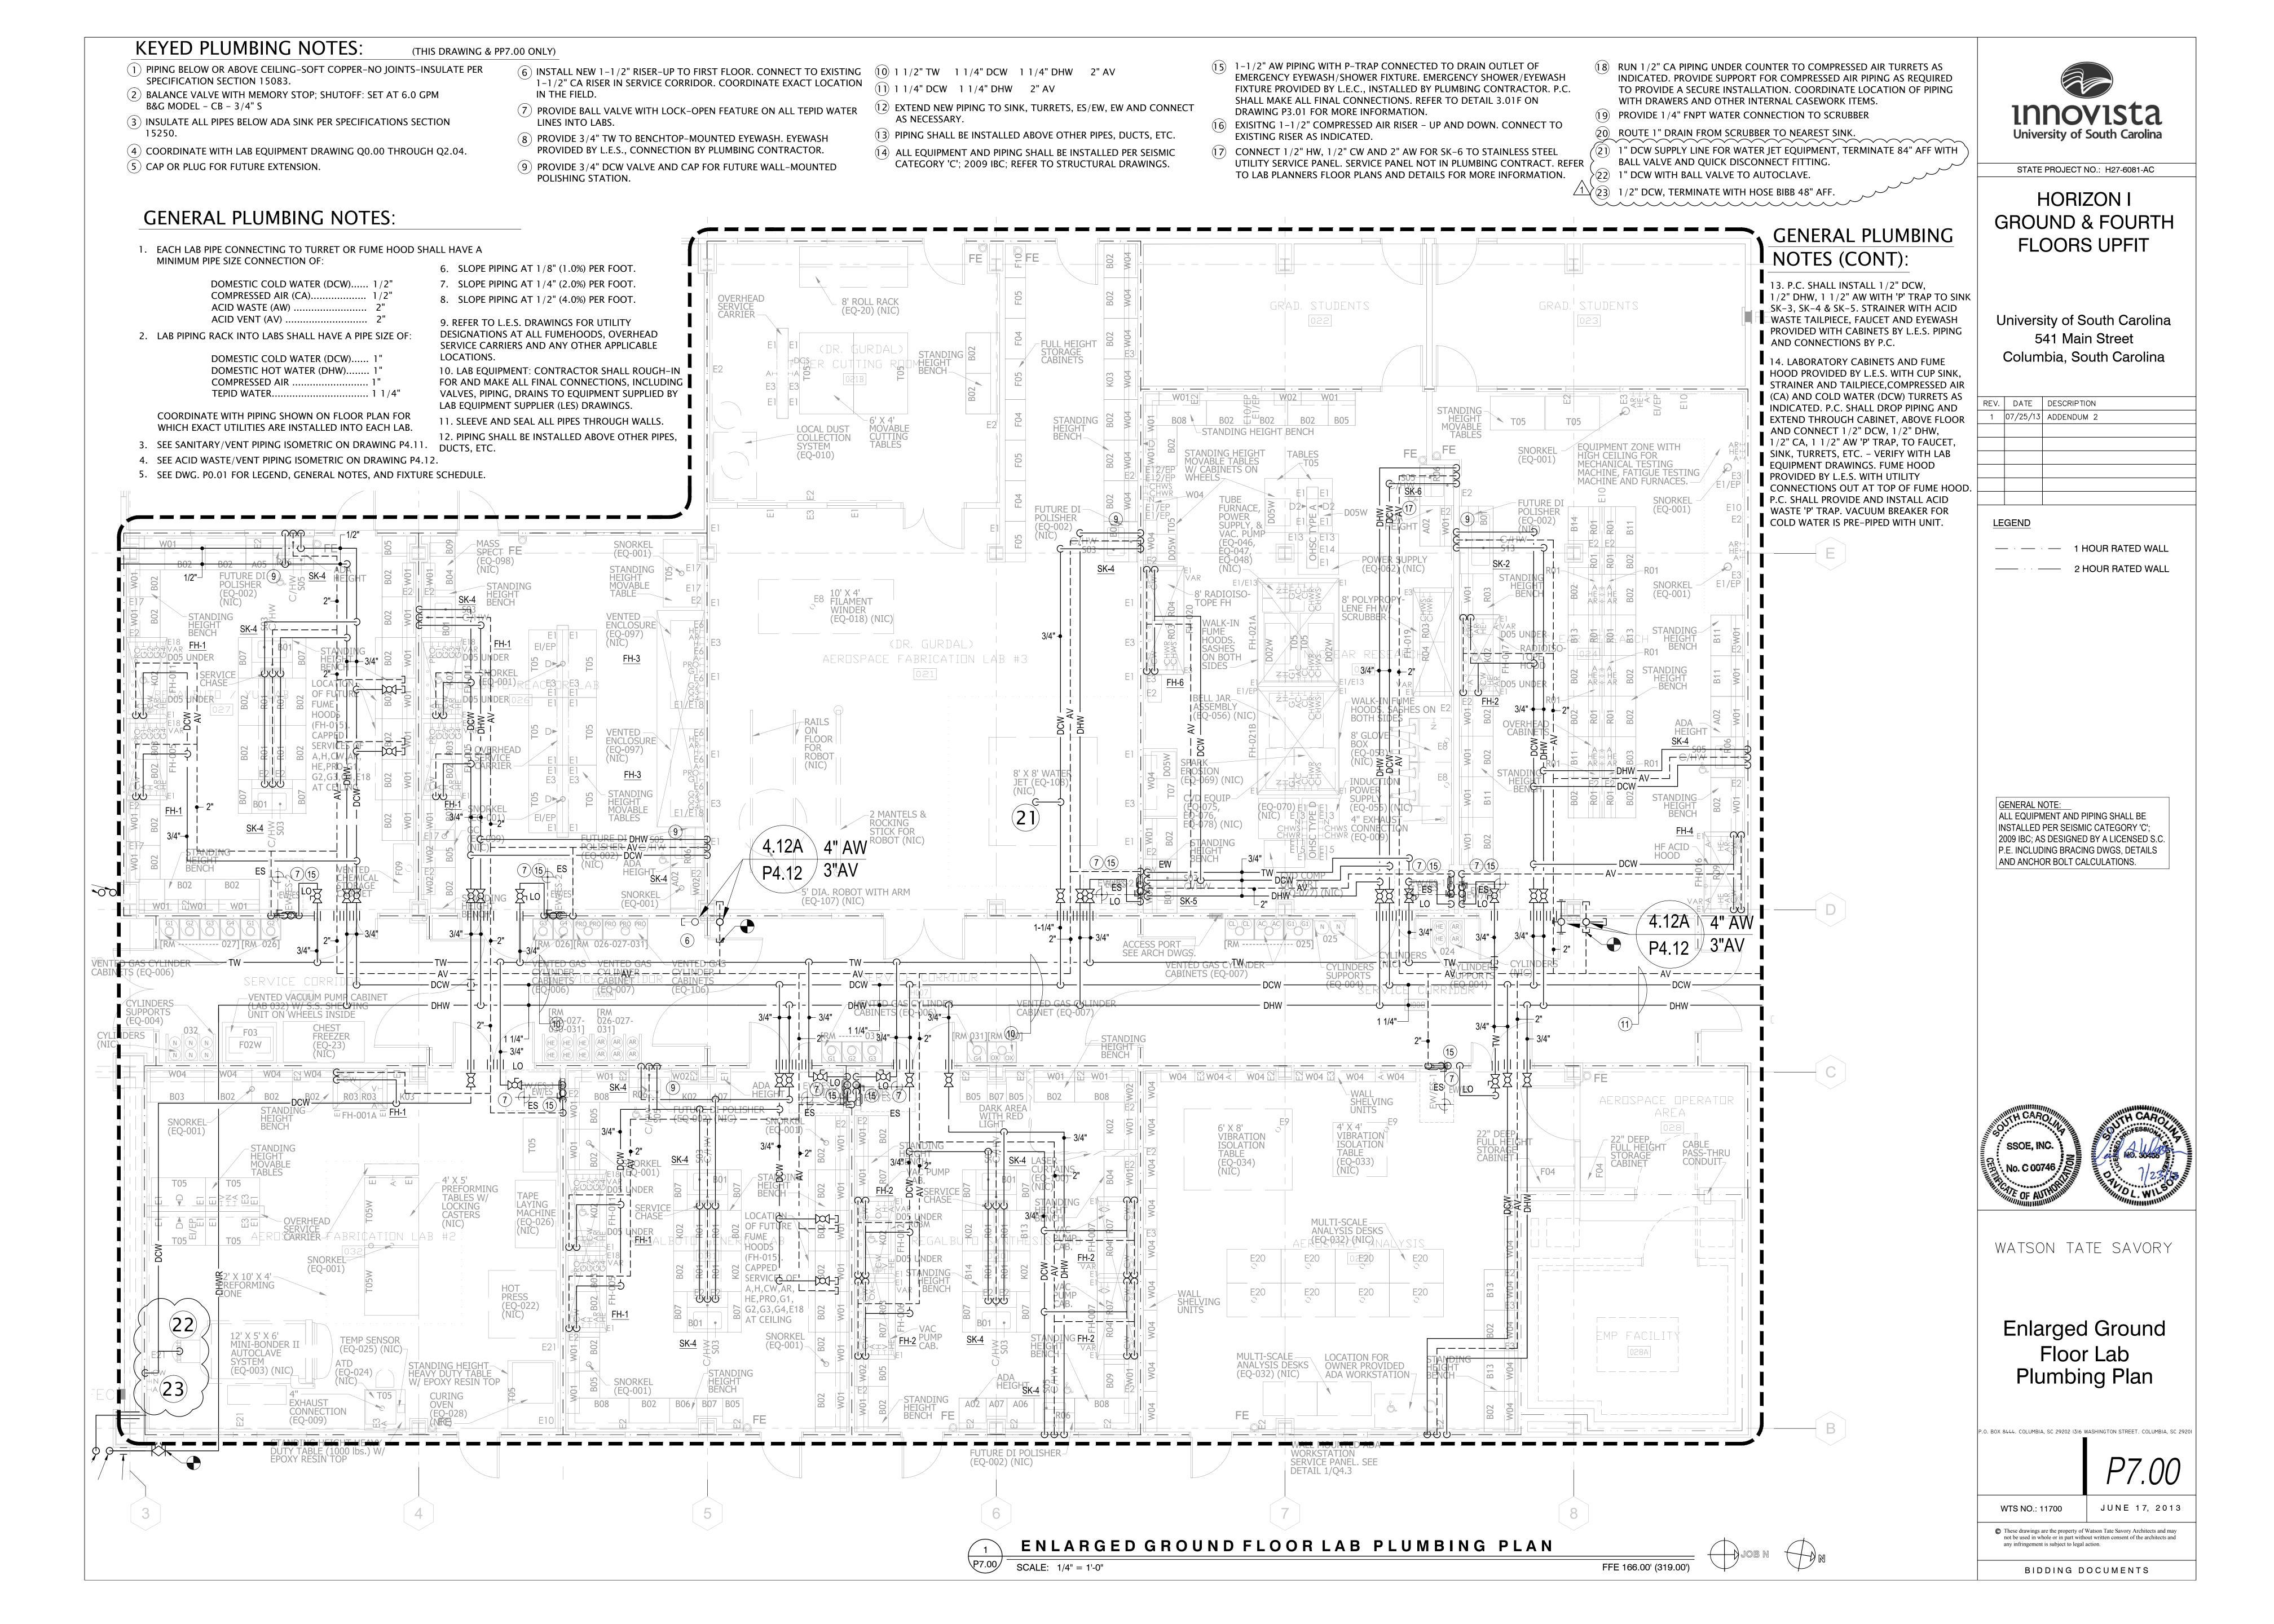

1) ROLL DOWN AT 45° AND CONNECT.

B&G MODEL – CB – 3/4" S

(12) SLEEVE AND SEAL ALL PIPES THROUGH WALLS.

3) BALANCE VALVE WITH MEMORY STOP; SHUTOFF: SET AT 6.0 GPM

5) P.C. SHALL INSTALL 1/2" DCW, 1/2" DHW, 1 1/2" AW WITH 'P' TRAP TO SINK SK-3, SK-4 & SK+5. STRAINER WITH ACID WASTE TAILPIECE, FAUCET AND EYEWASH PROVIDED WITH CABINETS BY L.E.S. PIPING AND CONNECTIONS BY

MOVABLE

DN ID.

(14) PIPING SHALL BE INSTALLED ABOVE OTHER PIPES, DUCTS, ETC.

<u>FH-4</u>

F/-- F/2-1

- (16) LABORATORY CABINETS AND FUME HOOD PROVIDED BY L.E.S. WITH CUP SINK, STRAINER AND TAILPIECE, NITROGEN (N), COMPRESSED AIR (CA) AND OTHER UTILITY TURRETS AS INDICATED. P.C. SHALL DROP PIPING AND EXTEND THROUGH CABINET, ABOVE FLOOR AND CONNECT 1/2" DCW, 1/2" DHW, 1/2" N, 1/2" CA, 1 1/2" AW 'P' TRAP, TO FAUCET, SINK, TURRETS, ETC. - VERIFY WITH LAB EQUIPMENT DRAWINGS. FUME HOOD PROVIDED BY L.E.S. WITH UTILITY CONNECTIONS OUT AT TOP OF FUME HOOD. P.C. SHALL PROVIDE AND INSTALL ACID WASTE 'P' TRAP. VACUUM BREAKER FOR COLD WATER IS PRE-PIPED WITH UNIT.
- (17) SEE SANITARY/VENT PIPING ISOMETRIC ON DRAWING P4.11.
- (18) SEE ACID WASTE/VENT PIPING ISOMETRIC ON DRAWING P4.12. (19) INSULATE ALL PIPES BELOW ADA SINK PER SPECIFICATIONS SECTION
- (20) EACH LAB PIPE CONNECT TO TURRET SHALL HAVE A MINIMUM PIPE SIZE **CONNECTION OF:**

DOMESTIC COLD WATER (DCW).....1/2" COMPRESSED AIR (CA – HOUSE).....1/2"

- (21) COORDINATE WITH LAB EQUIPMENT DRAWING Q0.00 THROUGH Q2.04.
- (22) 2" V OFFSET AT 45°, RISE AT FACE OF PENTHOUSE WALL ABOVE.

METERING

& MIXING

STAND

2' X 2' VARTM

5' X 6' VARTM

(23) NEW 1-1/2" CA RISER - UP TO PENTHOUSE. REFER TO DRAWING P1.51 FOR CONTINUATION.

- (24) INSTALL AND CONNECT 1/2" DCW, VALVED FROM SINK TO ICE MAKER IN (33) 1 1/2" TW 1 1/4" DCW 1 1/4" DHW 4" AV REFRIGERATOR (NIC).
- (25) INSTALL 1/2" CA PIPING TO TURRETS MOUNTED ON OVERHEAD SERVICE CARRIER. COORDINATE EXACT LOCATION WITH OTHER UTILITIES.
- 26) CONNECT TO EXISTING 4" SAN WITH NEW 4" SAN. HORIZONTAL 4" SAN PIPING SHALL BE INSTALLED AT 1/8" PER FOOT SLOPE.
- (27) PROVIDE BALL VALVE WITH LOCK-OPEN FEATURE ON ALL TEPID WATER LINES INTO LABS.
- 28 NOT USED
- 29) PROVIDE 3/4" DCW VALVE AND CAP FOR FUTURE WALL-MOUNTED POLISHING STATION.
- 30 NOT USED

CANOPY HO

ABOVE VAR

5' X 6' EXHAUST CANOPY HOOD

ABOVE VARTM

- (31) NOT USED
- 32) LAB PIPING RACK INTO LABS SHALL HAVE A PIPE SIZE OF:

DOMESTIC COLD WATER (DCW)..... 1" DOMESTIC HOT WATER (DHW)...... 1" TEPID WATER...... 1 1/4"

COORDINATE WITH PIPING SHOWN ON FLOOR PLAN FOR WHICH EXACT UTILITIES ARE INSTALLED INTO EACH LAB.

- (34) PIPING ABOVE CEILING.
- (35) NOT USED
- (36) NOT USED
- PIPING SHALL BE INSTALLED ABOVE OTHER PIPES, DUCTS, ETC.

FIXTURE PROVIDED BY L.E.C., INSTALLED BY PLUMBING CONTRACTOR. P.C.

H = HFH-002 - - -

SHALL MAKE ALL FINAL CONNECTIONS. REFER TO DETAIL 3.01F ON

- (38) NOT USED
- 39 ALL EQUIPMENT AND PIPING SHALL BE INSTALLED PER SEISMIC CATEGORY 'C'; 2009 IBC; REFER TO STRUCTURAL DRAWINGS. 40 NOT USED
- (41) NOT USED
- 42 NOT USED

LOCAL DUST COLLECTION

- 43 NOT USED
- (44) 1-1/2" AW PIPING WITH P-TRAP CONNECTED TO DRAIN OUTLET OF EMERGENCY EYEWASH/SHOWER FIXTURE. EMERGENCY SHOWER/EYEWASH
- DRAWING P3.01 FOR MORE INFORMATION. 45) EXISITNG 1-1/2" COMPRESSED AIR RISER - UP AND DOWN. CONNECT TO

EXISTING RISER AS INDICATED.

46 NOT USED

FILTER, FLOW

DRAIN SYSTEM

CONTROL, &

(47) RUN 1/2" CA PIPING UNDER COUNTER TO COMPRESSED AIR TURRETS AS INDICATED. PROVIDE SUPPORT FOR COMPRESSED AIR PIPING AS REQUIRED TO PROVIDE A SECURE INSTALLATION. COORDINATE LOCATION OF PIPING WITH DRAWERS AND OTHER INTERNAL CASEWORK ITEMS.

48) PLUG EXISTING FLOOR DRAIN.

University of South Carolina

HORIZON I **GROUND & FOURTH FLOORS UPFIT**

ınnovista

STATE PROJECT NO.: H27-6081-AC


University of South Carolina 541 Main Street Columbia, South Carolina

REV.	DATE	DESCRIPTION
1	07/25/13	ADDENDUM 2
	_	

LEGEND

— 1 HOUR RATED WALL —— · · — 2 HOUR RATED WALL

AND ANCHOR BOLT CALCULATIONS.

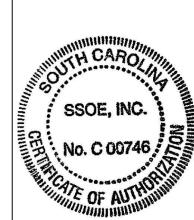




Enlarged Fourth Floor Lab Plumbing Plan

P.O. BOX 8444. COLUMBIA, SC 29202 1316 WASHINGTON STREET. COLUMBIA, SC 29201

JUNE 17, 2013 WTS NO.: 11700

© These drawings are the property of Watson Tate Savory Architects and may not be used in whole or in part without written consent of the architects and any infringement is subject to legal action.

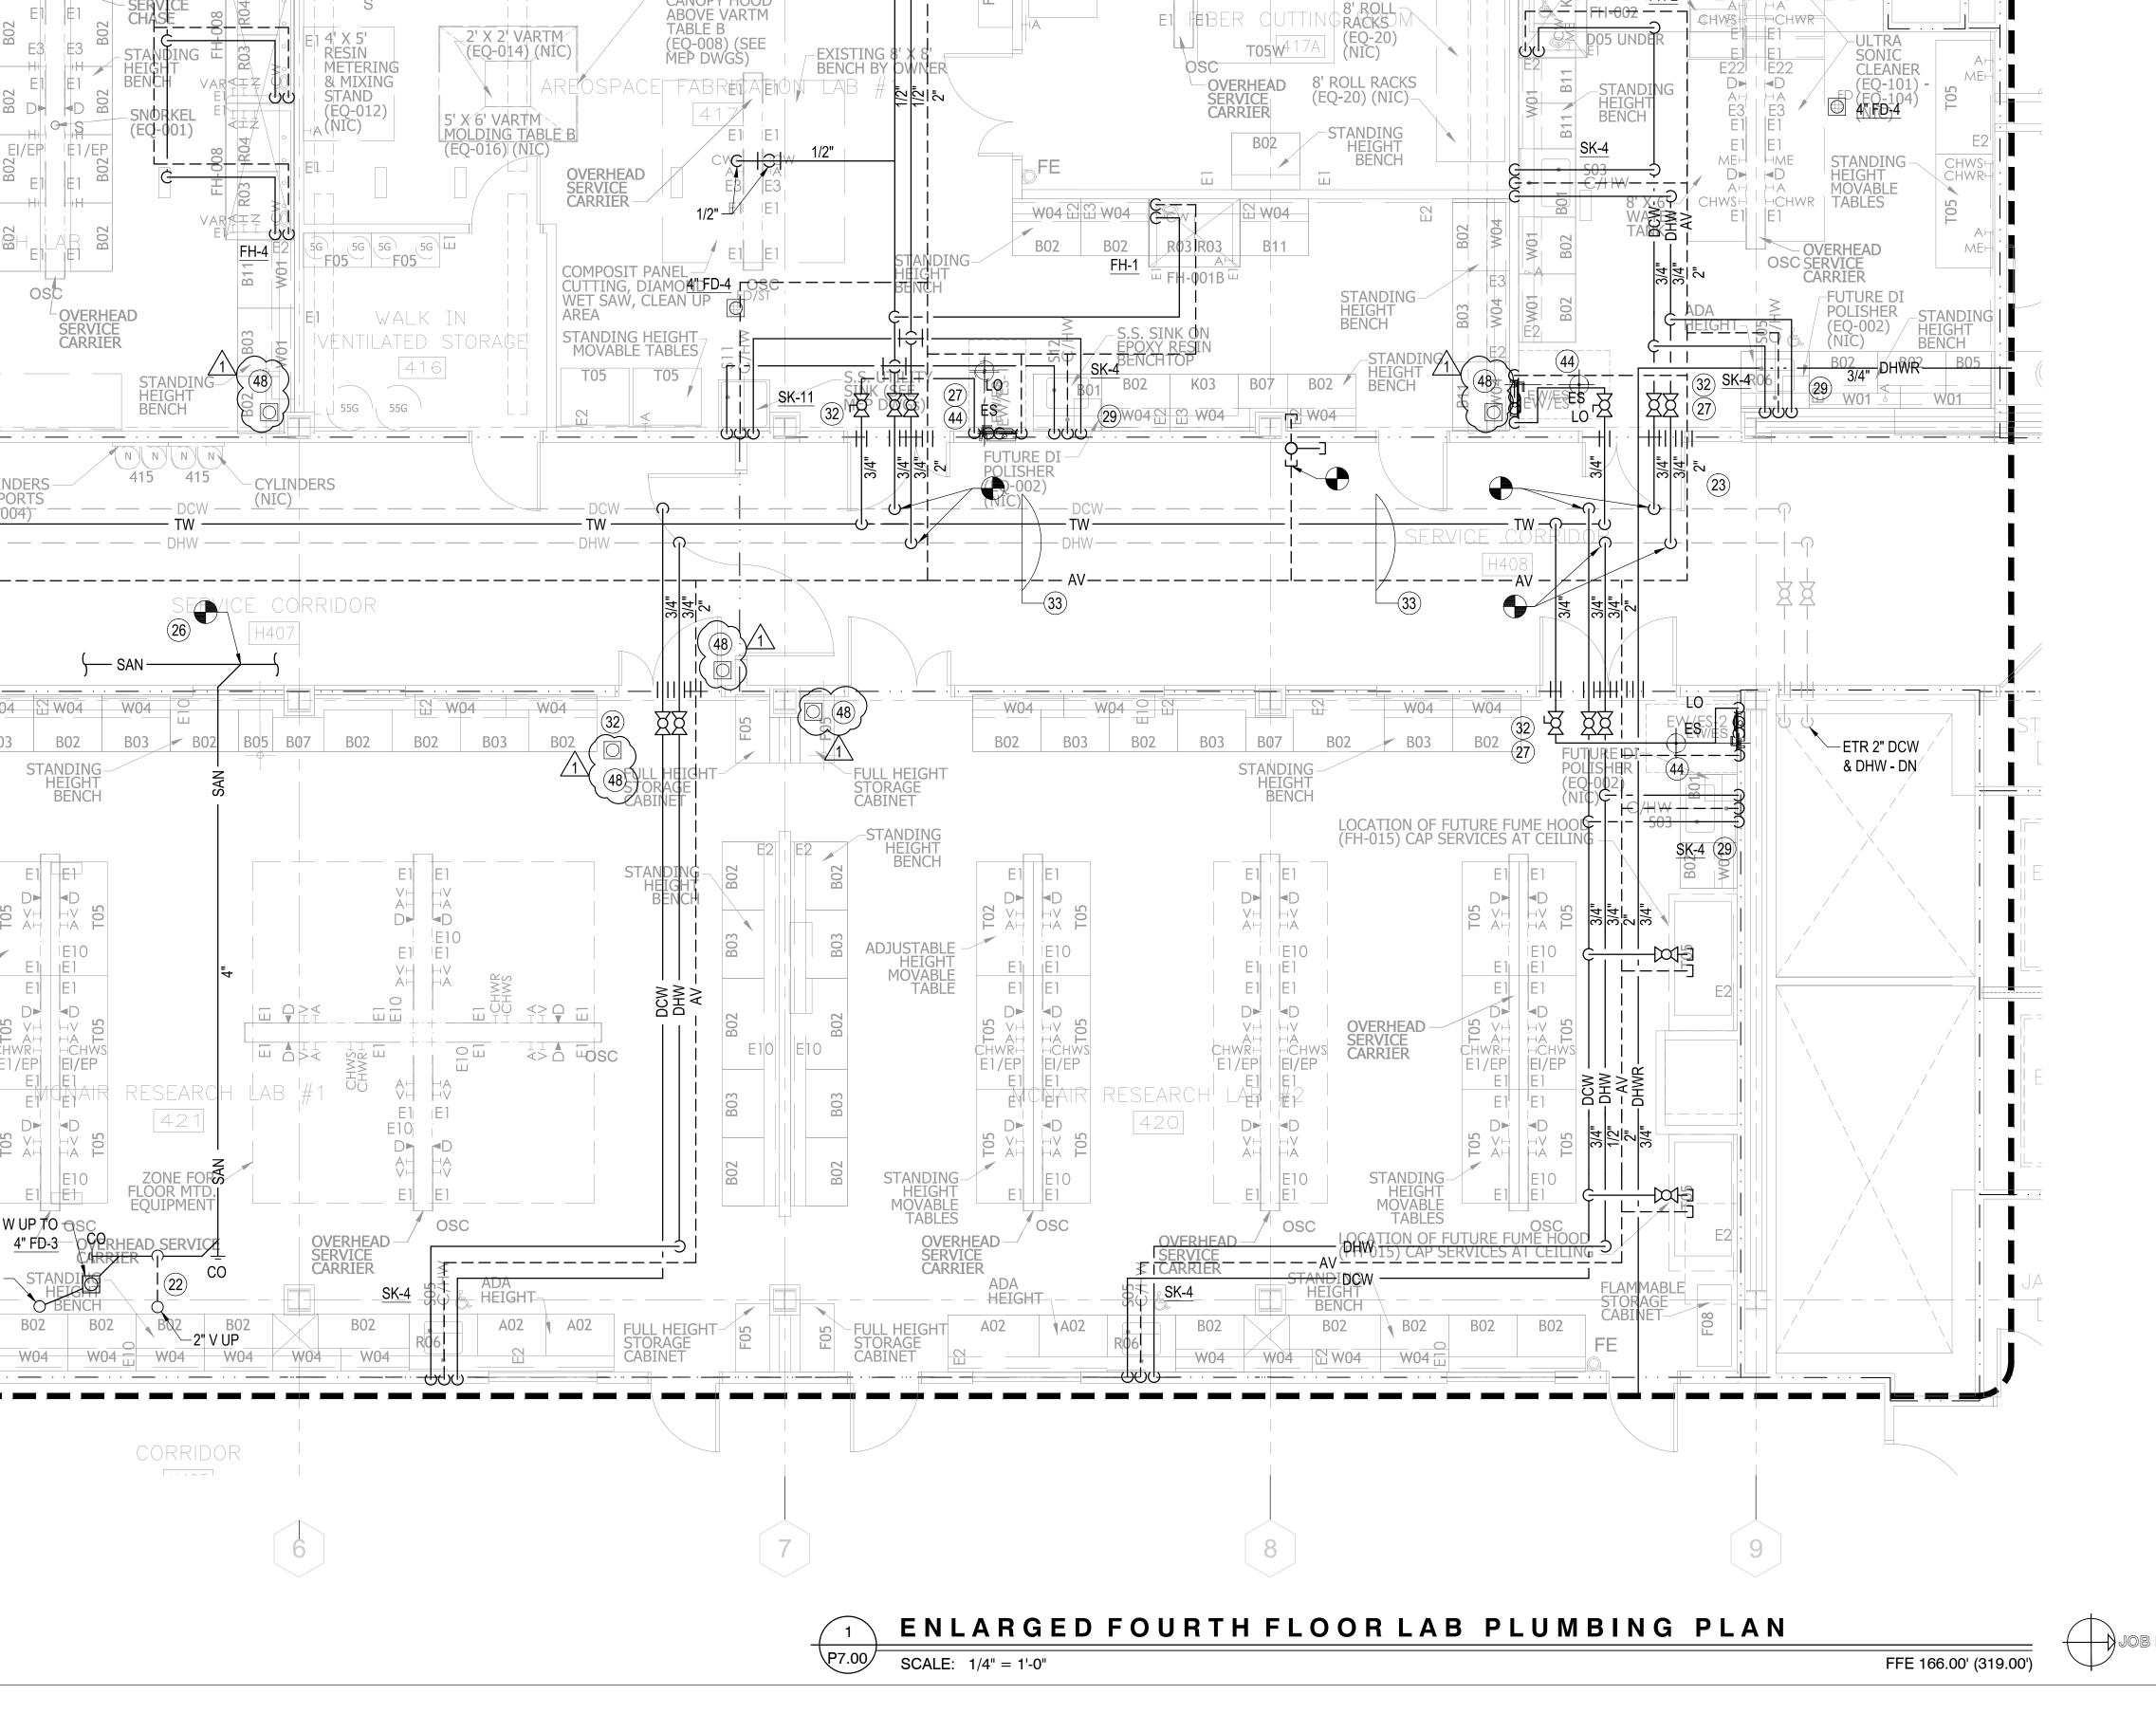



22.7

63.0

21 CONNECTED kVA=

DEMAND Amps = 58.0 | CONNECTED Amps=

DEMAND kVA=

TOTAL 7.9 9.0 5.8

GRAD 020, CORR. H04, H03 2#12,#12G-3/4"C

20-1 RECEPTACLES (5)

16 CONNECTED kVA=

DEMAND Amps = 45.5 CONNECTED Amps=

42c

| \frac{\sqrt{38a} \ \sqrt{30-3} \ \tag{Ty\sqrt{5}} \ \delta \delta \ \delta \delta \ \delta \delta \ \delta \d

58.3

TOTAL 8 6 7



Wire Size AWG

2#10,#10G-3/4"

2#10,#10G-3/4°C

2#10,#10G-3/4°C

4#10,#10G-3/4°C

4#10,#10G-3/4°C

3#10,#10G-3/4"C

3#6,#10G-1"C

2#12,#12G-3/4"(

2#12,#12G-3/4°C

2#12,#12G-3/4°C

2#12,#12G-3/4°C

3#12,#12G-3/4°C

2#12,#12G-3/4°C

2#10,#10G-3/4°C

2#12,#12G-3/4°C

2#12,#12G-3/4°C

2#12,#12G-3/4"C

2#12,#12G-3/4"(

3#6,#10G-1"C

2#12,#12G-3/4°C

2#12,#12G-3/4°C

2#10,#10G-3/4°C

2#10,#10G-3/4°C

2#10,#10G-3/4"C

2#10,#10G-3/4°C

2#10,#10G-3/4°C

3#10,#10G-3/4°C

3#10,#10G-3/4°C

4#12,#12G-3/4°C

2#12,#X29-3/4"X

DATE

TOP

60 CIRCUIT PANEL

TVSS

LAB 026

LAB 024

LAB 024

LAB 024

LAB 024

LAB 025

LAB 025

LAB 025

LAB 025

LAB 030 LAB 030

LAB 030

LAB 006

LAB 032

LAB 029

LAB 029

LAB 025

2.0 LAB 029

2.0 LAB 029

0.3 LAB 025

1.3 LAB 007B

3.8 LAB 025

0.8 LAB 025

0.8 LAB 025

2.0 LAB 025

0.6 LAB 030

0.2 LAB 024

a b c

0.4

2.7

2.7

1.8

1.5

1.9

1.0

0.6

3.8

2.0

2.0

2.7

1.8

0.4

2.7

2.7

0.8

0.6

0.6

0.2

1.8

CONNECTED Amps/

- 1. ALL BRANCH CIRCUIT BREAKERS ARE 20A, 1P UNLESS OTHERWISE NOTED.
- 2. TRIANGLE AROUND CIRCUIT NUMBER INDICATES CIRCUIT BREAKER WITH GROUND FAULT INTERRUPTER.
- 3. CIRCLE AROUND CIRCUIT NUMBER

INDICATES HANDLE LOCK DEVICE.

4. ROOM NUMBER ON THIS DRAWING SHOULD MATCH COMPANION PLAN DRAWINGS. THE ROOM NUMBERS ARE NOT FINAL USC ROOM NUMBERS. SUBMITTAL OF PANEL SCHEDULES SHALL REFLECT ROOM NUMBER PER A SERIES DRAWINGS AND CLOSE OUT DRAWINGS SHALL BE MARKED WITH FINAL ROOM NUMBERS.

LEGEND:

EQUIPMENT/DEVICES

INDICATES EXISTING



STATE PROJECT NO.: H27-6081-AC

HORIZON I **GROUND & FOURTH FLOORS UPFIT**

University of South Carolina 541 Main Street Columbia, South Carolina

REV.	DATE	DESCRIPTION
1	07/25/13	ADDENDUM 2



WATSON TATE SAVORY


Ground Floor Panelboard Schedules

P.O. BOX 8444. COLUMBIA, SC 29202 1316 WASHINGTON STREET. COLUMBIA, SC 29201

WTS NO.: 11700

JUNE 17, 2013

© These drawings are the property of Watson Tate Savory Architects and may not be used in whole or in part without written consent of the architects and any infringement is subject to legal action.

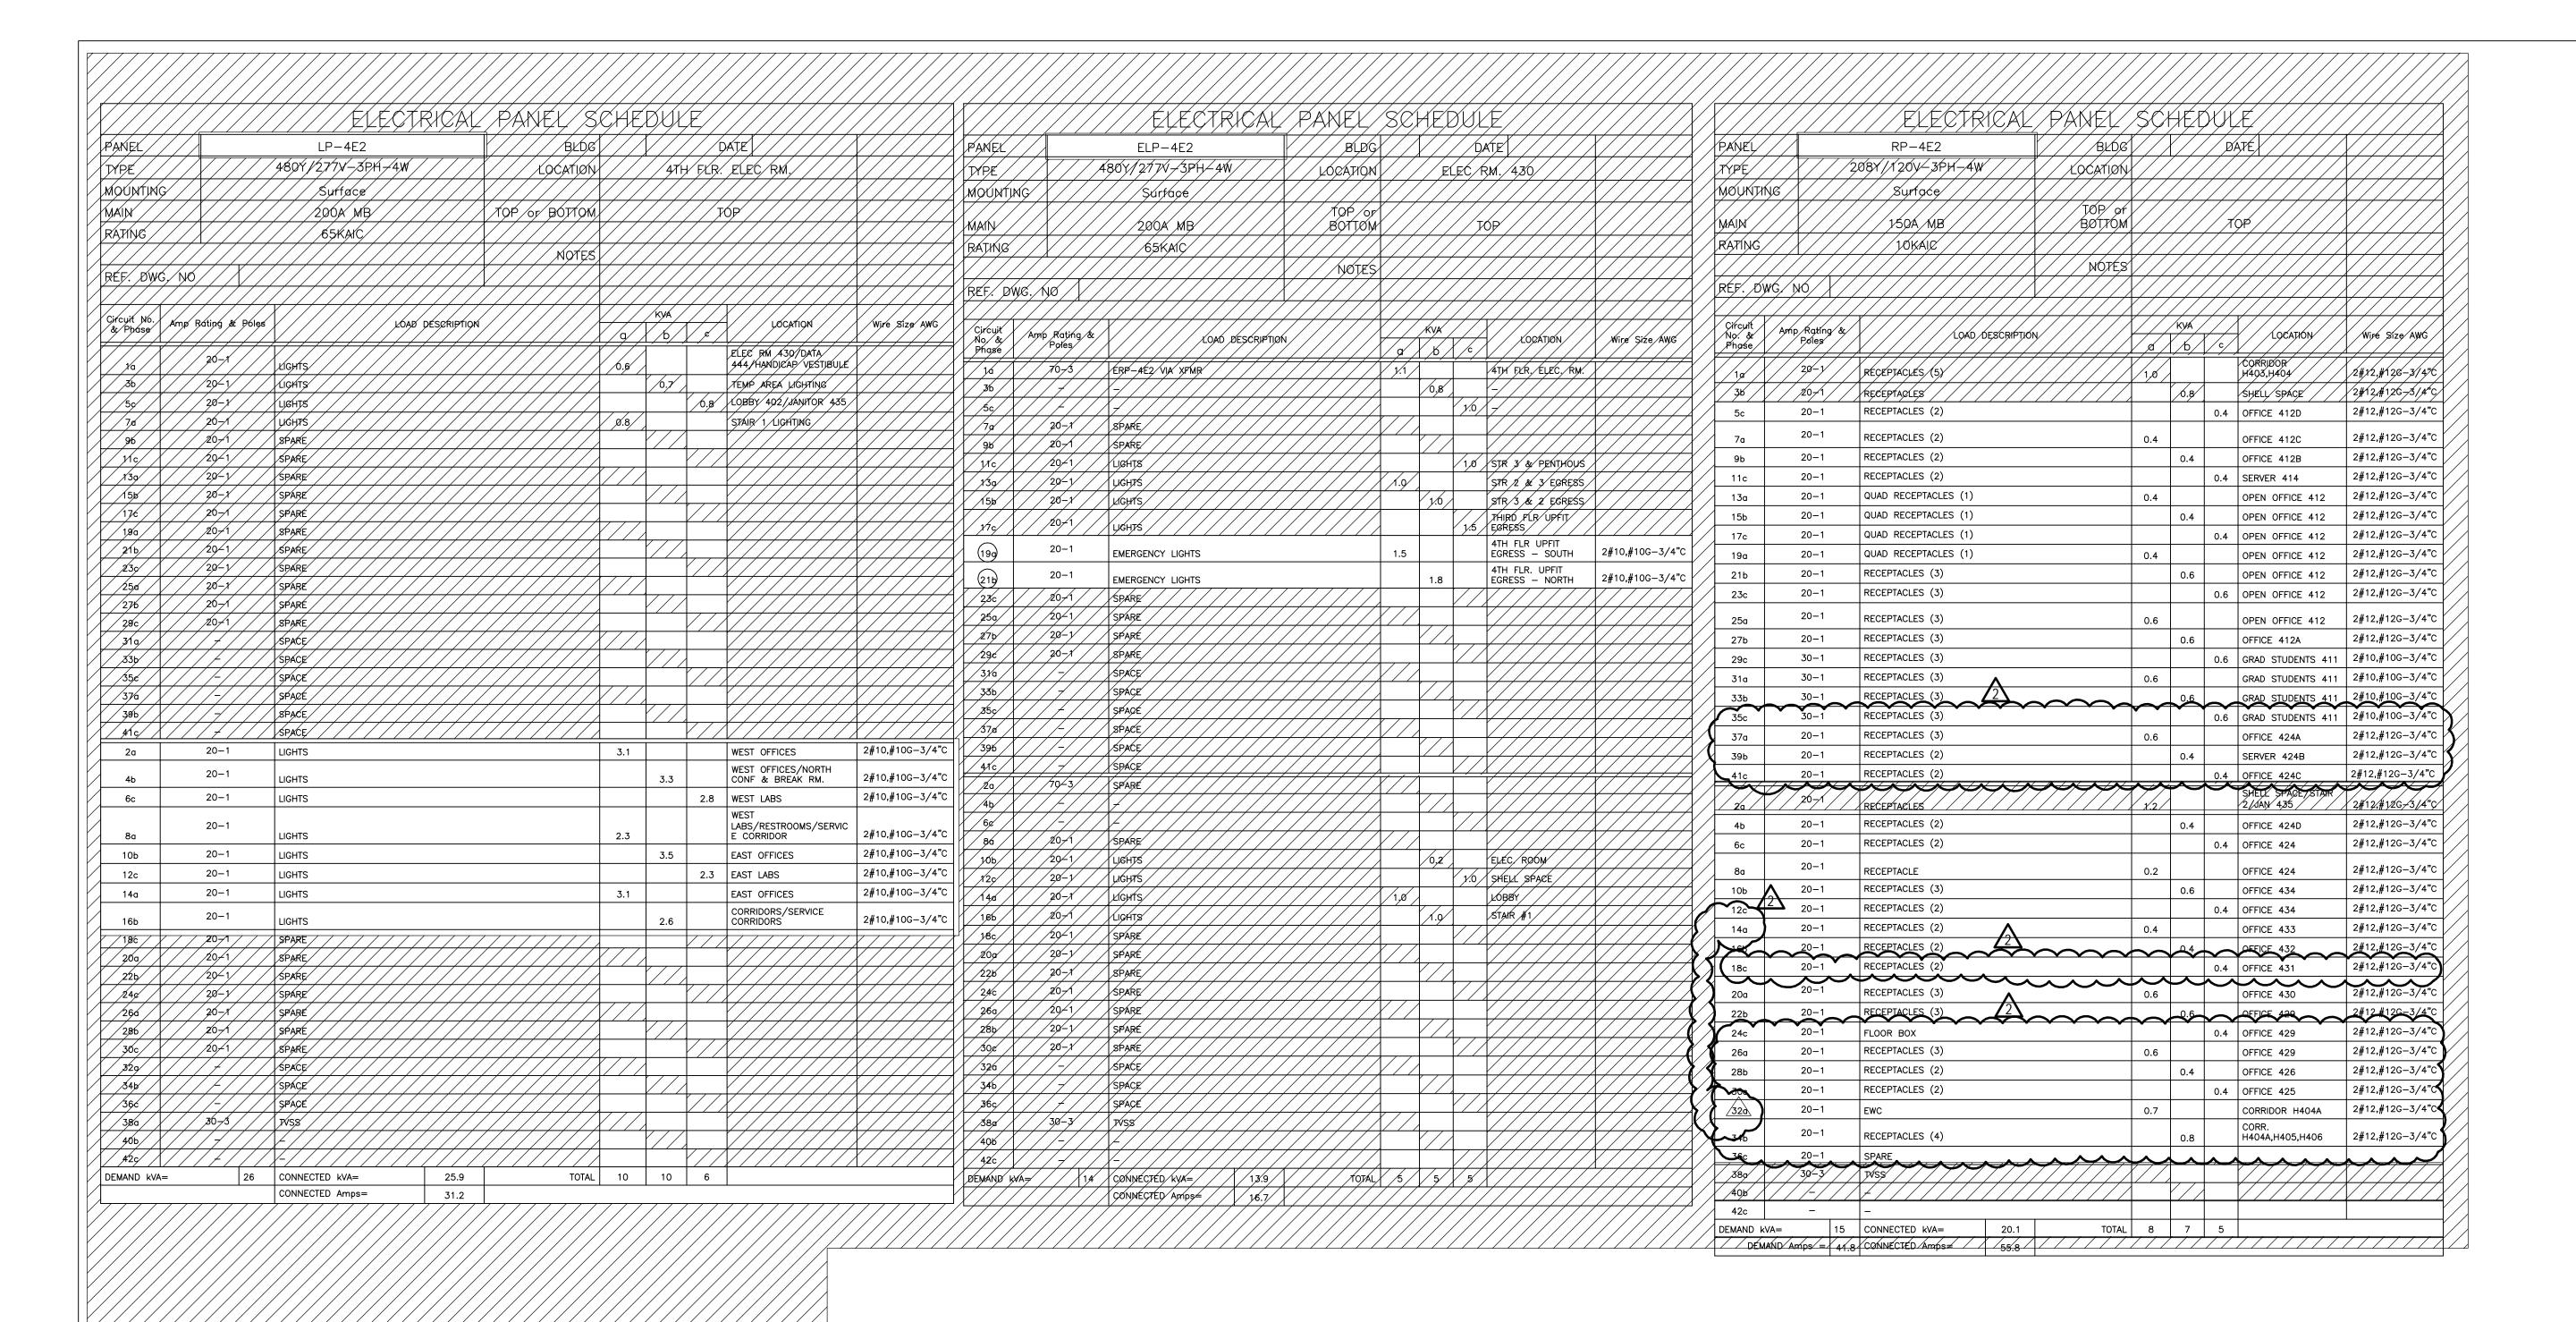

	/////	//FVF/TOIONV		ZOLIENY.			1									
							1			ELEC ⁻	TRICAL	PANEL SCHE	DUL	E.		
PANÉL		//ERP-4E2/////	///BLDG		BATE!		1	PANEL		URP-4C6.5		BLDG			ATE	
TYPE///	1///2	08Y/120V-3PH-4W///	LOCATION							208Y/120V-3PH-4W					AIL	
MOUNTING		// Surface/////						TYPE	10			LOCATION				
	X////		1/// TOP ør	<i>{//////</i> ,			1	MOUNTIN	G	Surface						
MAIN		// 1/5,0/A/MB/////	BOTTOM		104/////		1	MAIN		35A MB		TOP or BOTTOM		T(OP	
RATING/	1////	// 10KAJC / / / / /						RATING		10KAIC						
			MOTES									NOTES	18	CIRCL	JIT PANEL	
REF. DWG.	MO///						1	REF. DW	G. NO					ΤV	/SS	
Circuit No. & Phose	np Rating & Poles	LØAD/ DESCRIPTION		KWA / /	LOCATION	Wire Size AWG		Circuit No. & Phase	Amp Rating & Poles	LOA	D DESCRIPTION		KVA	_	LOCATION	Wire Size AWG
Fridse	29-1	RECEPTACLES		/ \d / / \b/ / \geq \d.6/	EKEÇ ROOM	1 2#12,#129-3/4°%			20-1	OHSC RECEPTACLES (2)		<u>a</u>	b	С		2#12,#12G-3/4"
3b/	<u> </u>	SPARE //		70.9	ELEC ROOM	1 1 1/2,11/2 97 1/3		1a				0.4			LAB 415	
50.	20-1	SPARE///		 	X//////		1	3b	20-1	OHSC RECEPTACLES (2) OHSC RECEPTACLES (2)			0.4	6 /	LAB 415	2#12,#12G-3/4"
1/2///	20/1//	CAB LIGHTS		Ø.1	ELEV KOØM	2#12,#12G-3/A"C	#	5c	20-1	OHSC RECEPTACLES (2)				0.4	LAB 421	2#12,#12G-3/4" 2#12,#12G-3/4"
/9b///	29-1//	RECEPTACLES		0,6	47H FLB DATA ROOM	1///////	44	7a	20-1	OHSC RECEPTACLES (2)		0.4	-		LAB 421	2#12,#12G-3/4" 2#12,#12G-3/4"
118	20-1	RECEPTACIES		 	ATH FLR DATA ROOM	* / / / / / /	41	9b	20-1	OHSC RECEPTACLES (2)			0.4	0.4	LAB 420	2#12,#12G-3/4" 2#12,#12G-3/4"
130	20-1	SPARE////	//////					11c	20-1	OHSC RECEPTACLES (2)		0.4		0.4	LAB 420	2#12,#12G-3/4 [*]
15b	20/1//	SPARE ////					1	13a 15b	20-1	SPARE SPARE		0.4			LAB 420	2π12,π120 0/4
110	20-1//	SPARÉ						-			2000	~~~~		~~		
19ø	20-1//	SPARE//////						2a	20-1	GAS DETECTION PANEL	<u> </u>	1.0			SERVICE CORRIDOR	2#12,#12G-3/4"
216	20-1	SPARE//////														
/2 <i>3</i> c//		SPACE////////						6c	20-1	SPARE						
250/		SPACE ///////					1	8a	20-1	SPARE						
276/		SPACE						10b	20-1	SPARE						
/29¢	/-///	8PACE/////////			<i>\//////</i>		4	12c	20-1	SPARE						
/316//	/-///	SPACE//////					1	14a	30-3	TVSS						
33b	////	SPACE //					1	16b	_	_						
35c/ 37g/		SPACE SPACE			<i>\//////</i>		1	18c		_						
396	////	SPACE						DEMAND kV		CONNECTED Average	3.8	TOTAL 2	1	1		
416	//_///	SPACE///					1		DEMAND Amps = 9.9	CONNECTED Amps=	10.5					
20	/20/1//	SHUNT TRIP		0.2	ELEV #3///	2#12,#12G-3/A"C	1									
4 b	20-1//	SPARE ///					1									
60/	20-1//	ELEV RECEPT		Ø.2,	ELEVATOR //	2#1/2,#12%-3/4°C	1									
80	20-1//	FIRE ALARM CAB.		9,2		2#12,#12G-3/4°C	#									
106	20/1//	PENT/4TH SMK		0.2		2#12,#12G-3/4°C	11									
1/20/	$\overline{}$	PENT/4TH SMK DMP		9.2	X///////	2#12,#x2G-3/4°C										
14,0	20-1//	SPARE////	///////		\//////		1									
166	20-1//	SPARE///														
18c	20-1	SPARE //////														
200/	/20/1//	SPARE /////					1									
/ 22b/ / /	/////	SPACE///////	////////		<u> </u>											

SPACE/

PANEL		RP-4D9.5						DATE	
TYPE		208Y/120V-3PH-4W		LOCATION		•			
MOUNTING	3	Surface							
MAIN	-	150A MB				TOP			
RATING		10KAIC		TOP or BOTTOM				101	
NATING		TORAIC	+	NOTES					
	2 10			NO1E2					
REF. DWO	3. NU								
<u> </u>						KVA			
Circuit No. & Phase	Amp Rating & Poles	LOAD DESCRIPTION				Ь	С	LOCATION	Wire Size AWG
1a	20-1	RECEPTACLES (3)		0.6		<u> </u>	OFFICE 435	2#12,#12G-3/4"C	
3b	20-1	RECEPTACLES (2)				0.4		OFFICE 436	2#12,#12G-3/4"C
5c	20-1	RECEPTACLES (2)					0.4	OFFICE437	2#12,#12G-3/4"C
7a	20-1	RECEPTACLES (2)			0.4			OFFICE438	2#12,#12G-3/4"C
9ь	20-1	RECEPTACLES (3)				0.6		OFFICE439	2#12,#12G-3/4"C
11c	20-1	RECEPTACLES (3)					0.6	OFFICE 401	2#12,#12G-3/4"C
13a	20-1	RECEPTACLES (4)			0.8			OFFICE 402	2#12,#12G-3/4°C
15b	20-1	RECEPTACLES (2)				0.4		OFFICE 403	2#12,#12G-3/4°C
17c	20-1	RECEPTACLES (4)					0.8	OFFICE 404	2#12,#12G-3/4"C
19a	20-1	RECEPTACLES (1)			0.2			BREAKROOM 404	2#12,#12G-3/4"C
21b	20-1	RECEPTACLES (2)				0.4		BREAKROOM 404	2#12,#12G-3/4"C
23c	20-1	REFRERIGERATOR					1.8	BREAKROOM 404	2#12,#12G-3/4"C
25a	20-1	REFRERIGERATOR			1.8			BREAKROOM 404	2#12,#12G-3/4"C
27b	20-1	RECEPTACLES (4)				0.8		BREAKROOM 404	2#12,#12G-3/4"C
29c	20-1	RECEPTACLES (4)					0.8	MEN 405, WOMEN 406	2#12,#12G-3/4"C
31a	30-1	HAND DRYER			2.0			WOMEN 406	2#10,#10G-3/4"C
3 3b	30-1	HAND DRYER				2.0		MEN 405	2#10,#10G-3/4"C
350	20-1	EWC					0.7	VESTIBULE V401	2#12,#12G-3/4"C
3,5	20-1	RECEPTACLES (6)			1.2			CORRIDOR H402,H403	2#12,#12G-3/4"C
39ь	20-1	RECEPTACLES (5)				1.0		CORRIDOR H405, H406	2#12,#12G-3/4"C
41c	20-1	SPARE							
2a	30-1	RECEPTACLES (3)			0.6			GRAD STUDENT 407	2#10,#10G-3/4"C
4b	30-1	RECEPTACLES (2)				0.4		GRAD STUDENT 407	2#10,#10G-3/4°C
6c	30-1	RECEPTACLES (3)					0.6	GRAD STUDENT 407	2#10,#10G-3/4"C
8a	30-1	RECEPTACLES (3)			0.6			GRAD STUDENT 408	2#10,#10G-3/4"C
10b	30-1	RECEPTACLES (3)				0.6		GRAD STUDENT 408	2#10,#10G-3/4"C
12c	30-1	RECEPTACLES (3)					0.6	GRAD STUDENT 410	2#10,#10G-3/4"C
1 4 a	30-1	RECEPTACLES (3)			0.6			GRAD STUDENT 410	2#10,#10G-3/4"C
16b	30-1	RECEPTACLES (3)				0.6		GRAD STUDENT 410	2#10,#10G-3/4°C
18c	30-1	RECEPTACLES (3)					0.6	GRAD STUDENT 410	2#10,#10G-3/4°C
20a	30-1	RECEPTACLES (3)			0.6			GRAD STUDENT 410	2#10,#10G-3/4°C
22b	30-1	RECEPTACLES (3)				0.6		GRAD STUDENT 410	2#10,#10G-3/4°C
24c	30-1	RECEPTACLES (2)					0.4	GRAD STUDENT 410	2#10,#10G-3/4°C
26a	30-1	RECEPTACLES (3)		0.6			GRAD STUDENT 408,410	2#10,#10G-3/4°C	
28ь	20-1	SPARE							
30c	20-1	SPARE							
32a	20-1	SPARE							
34b	20-1	SPARE							
36c	20-1	SPARE							
38a	30-3	TVSS							
40b	-	_							
42c		-	1						
DEMAND kVA	= 21.7	CONNECTED kVA=	25.1	TOTAL	10	8	7		

NOTES:

- 1. ALL BRANCH CIRCUIT BREAKERS ARE 20A, 1P UNLESS OTHERWISE NOTED.
- 2. TRIANGLE AROUND CIRCUIT NUMBER INDICATES CIRCUIT BREAKER WITH GROUND FAULT INTERRUPTER.
- 3. CIRCLE AROUND CIRCUIT NUMBER INDICATES HANDLE LOCK DEVICE.
- 4. ROOM NUMBER ON THIS DRAWING SHOULD MATCH COMPANION PLAN DRAWINGS. THE ROOM NUMBERS ARE NOT FINAL USC ROOM NUMBERS. SUBMITTAL OF PANEL SCHEDULES SHALL REFLECT ROOM NUMBER PER A SERIES DRAWINGS AND CLOSE OUT DRAWINGS SHALL BE MARKED WITH FINAL ROOM

LEGEND:

INDICATES EXISTING EQUIPMENT/DEVICES



STATE PROJECT NO.: H27-6081-AC

HORIZON I **GROUND & FOURTH FLOORS UPFIT**

University of South Carolina 541 Main Street Columbia, South Carolina

REV.	DATE	DESCRIPTION
1	07/17/13	ADDENDUM 1
2	07/25/13	ADDENDUM 2




WATSON TATE SAVORY


Fourth Floor Panel Schedules

P.O. BOX 8444. COLUMBIA, SC 29202 1316 WASHINGTON STREET. COLUMBIA, SC 29201

JUNE 17, 2013 WTS NO.: 11700

© These drawings are the property of Watson Tate Savory Architects and may not be used in whole or in part without written consent of the architects and any infringement is subject to legal action.

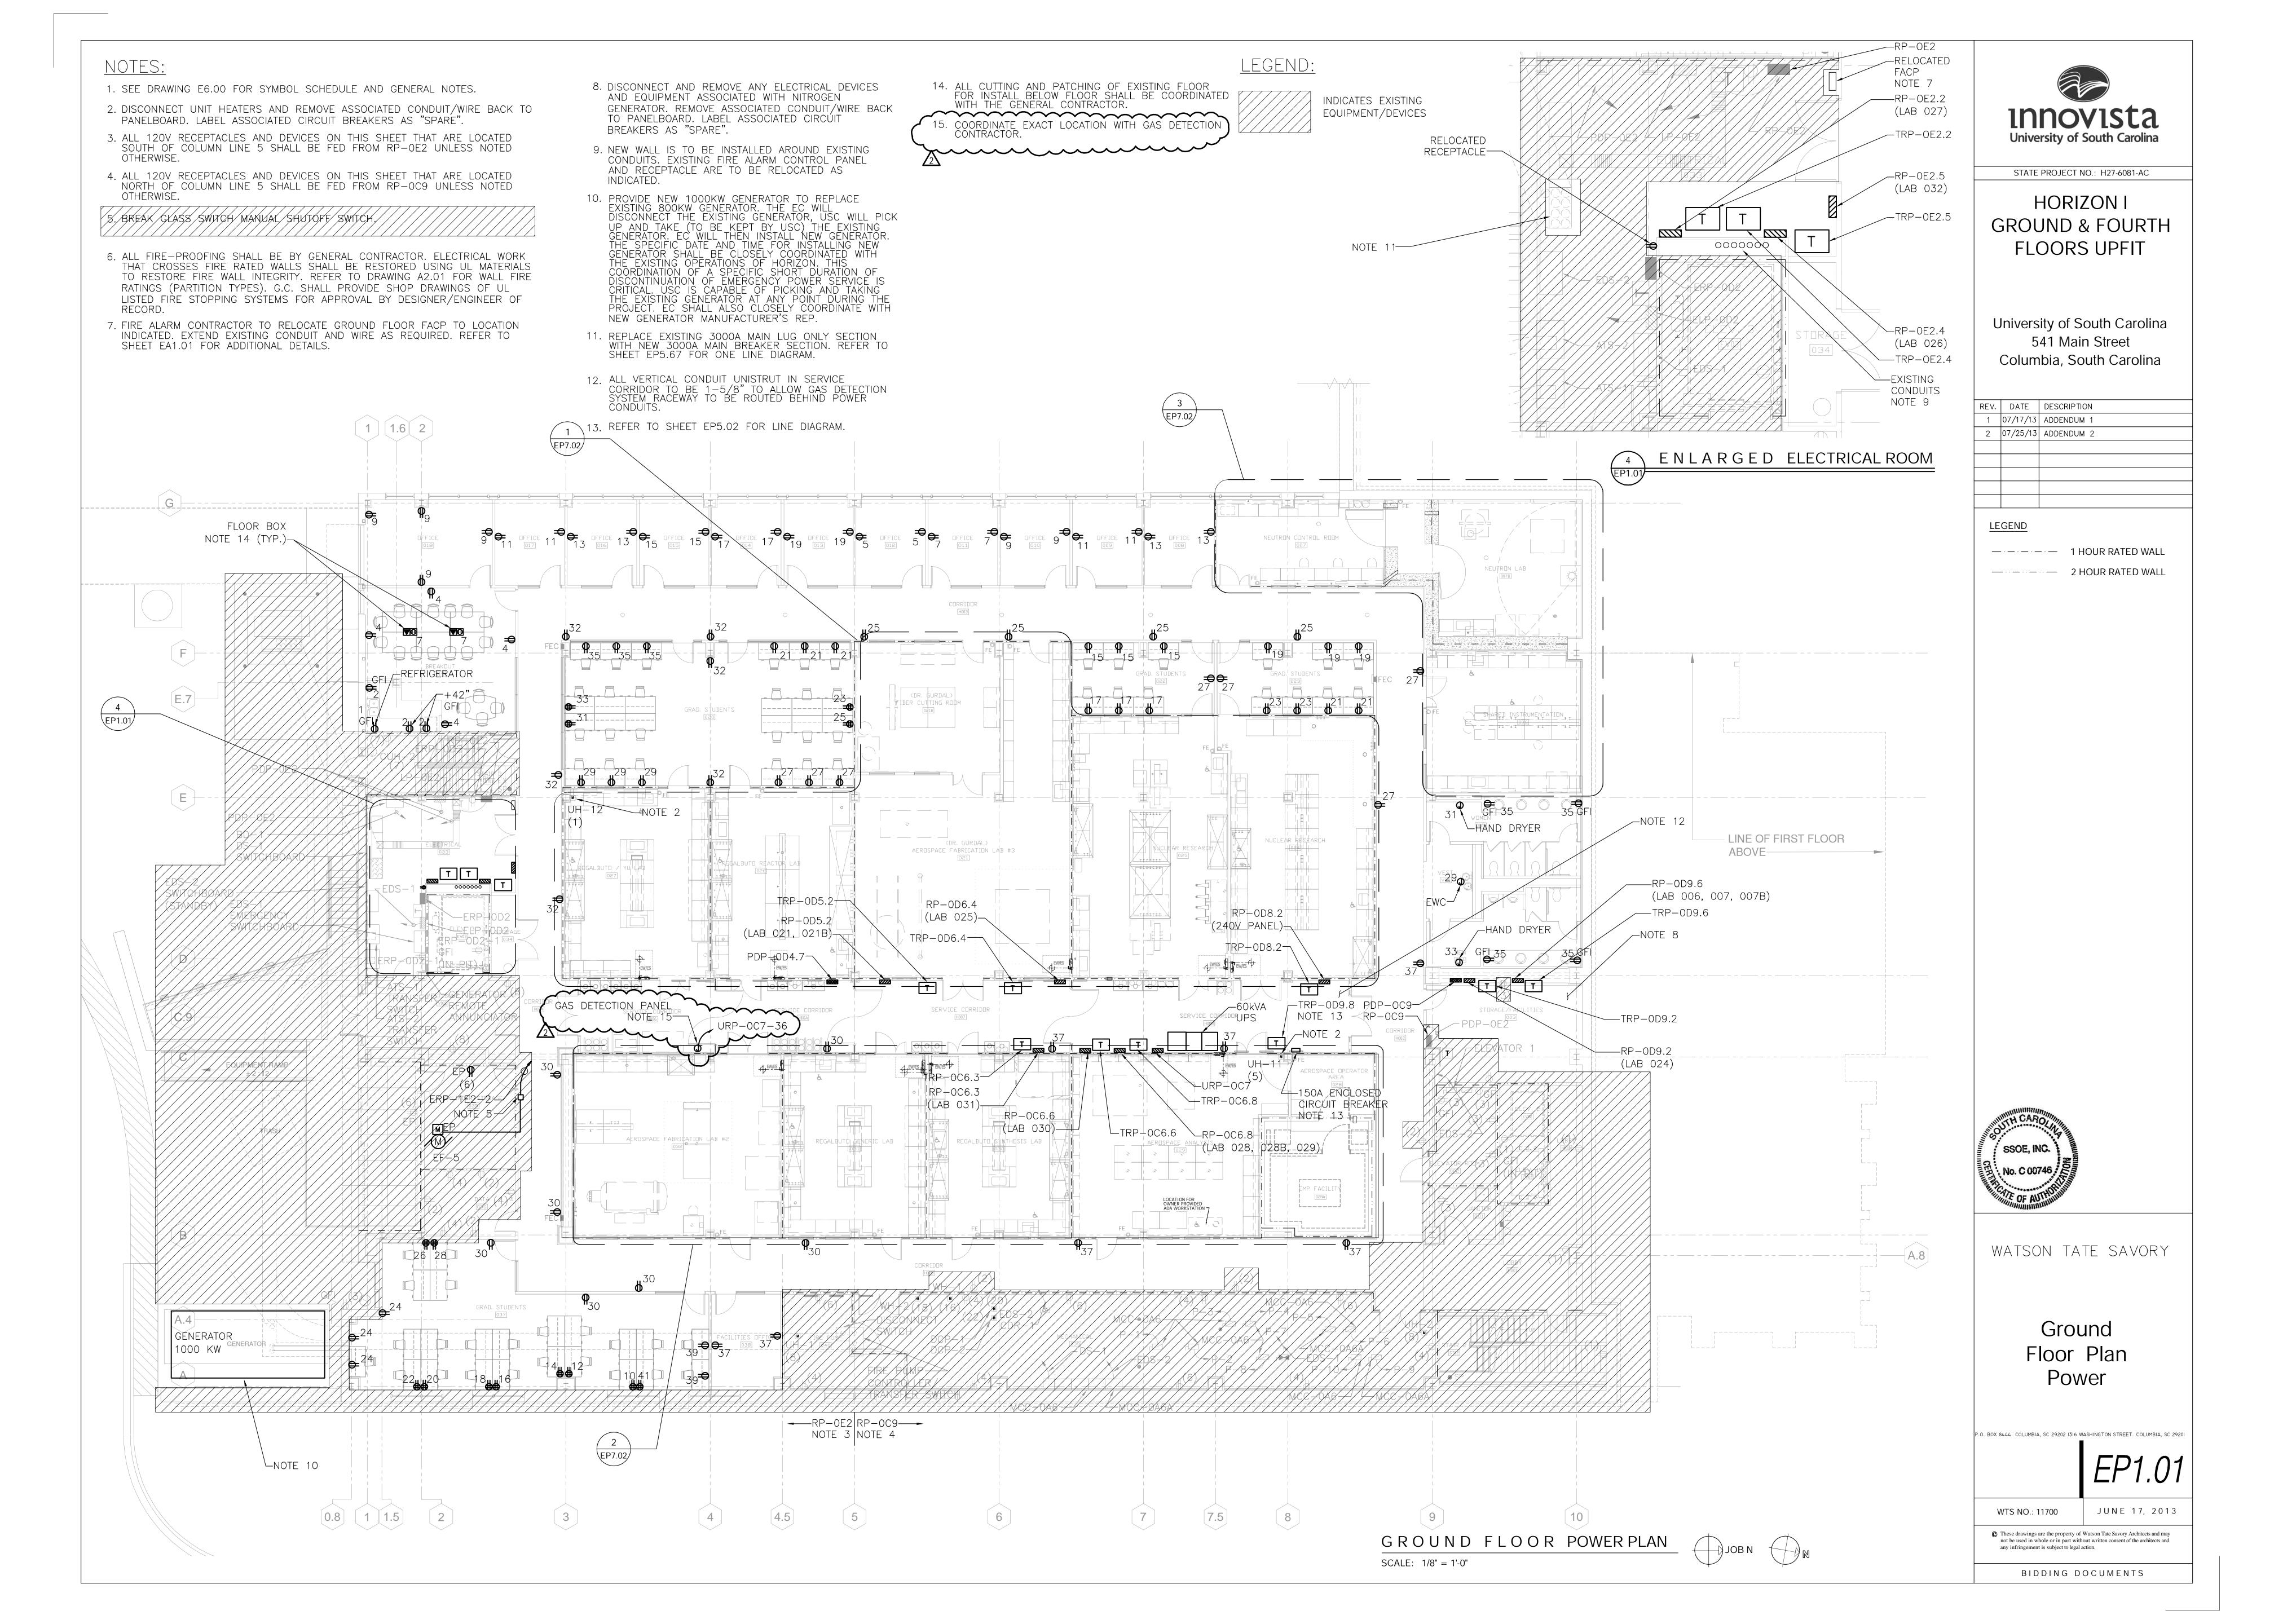

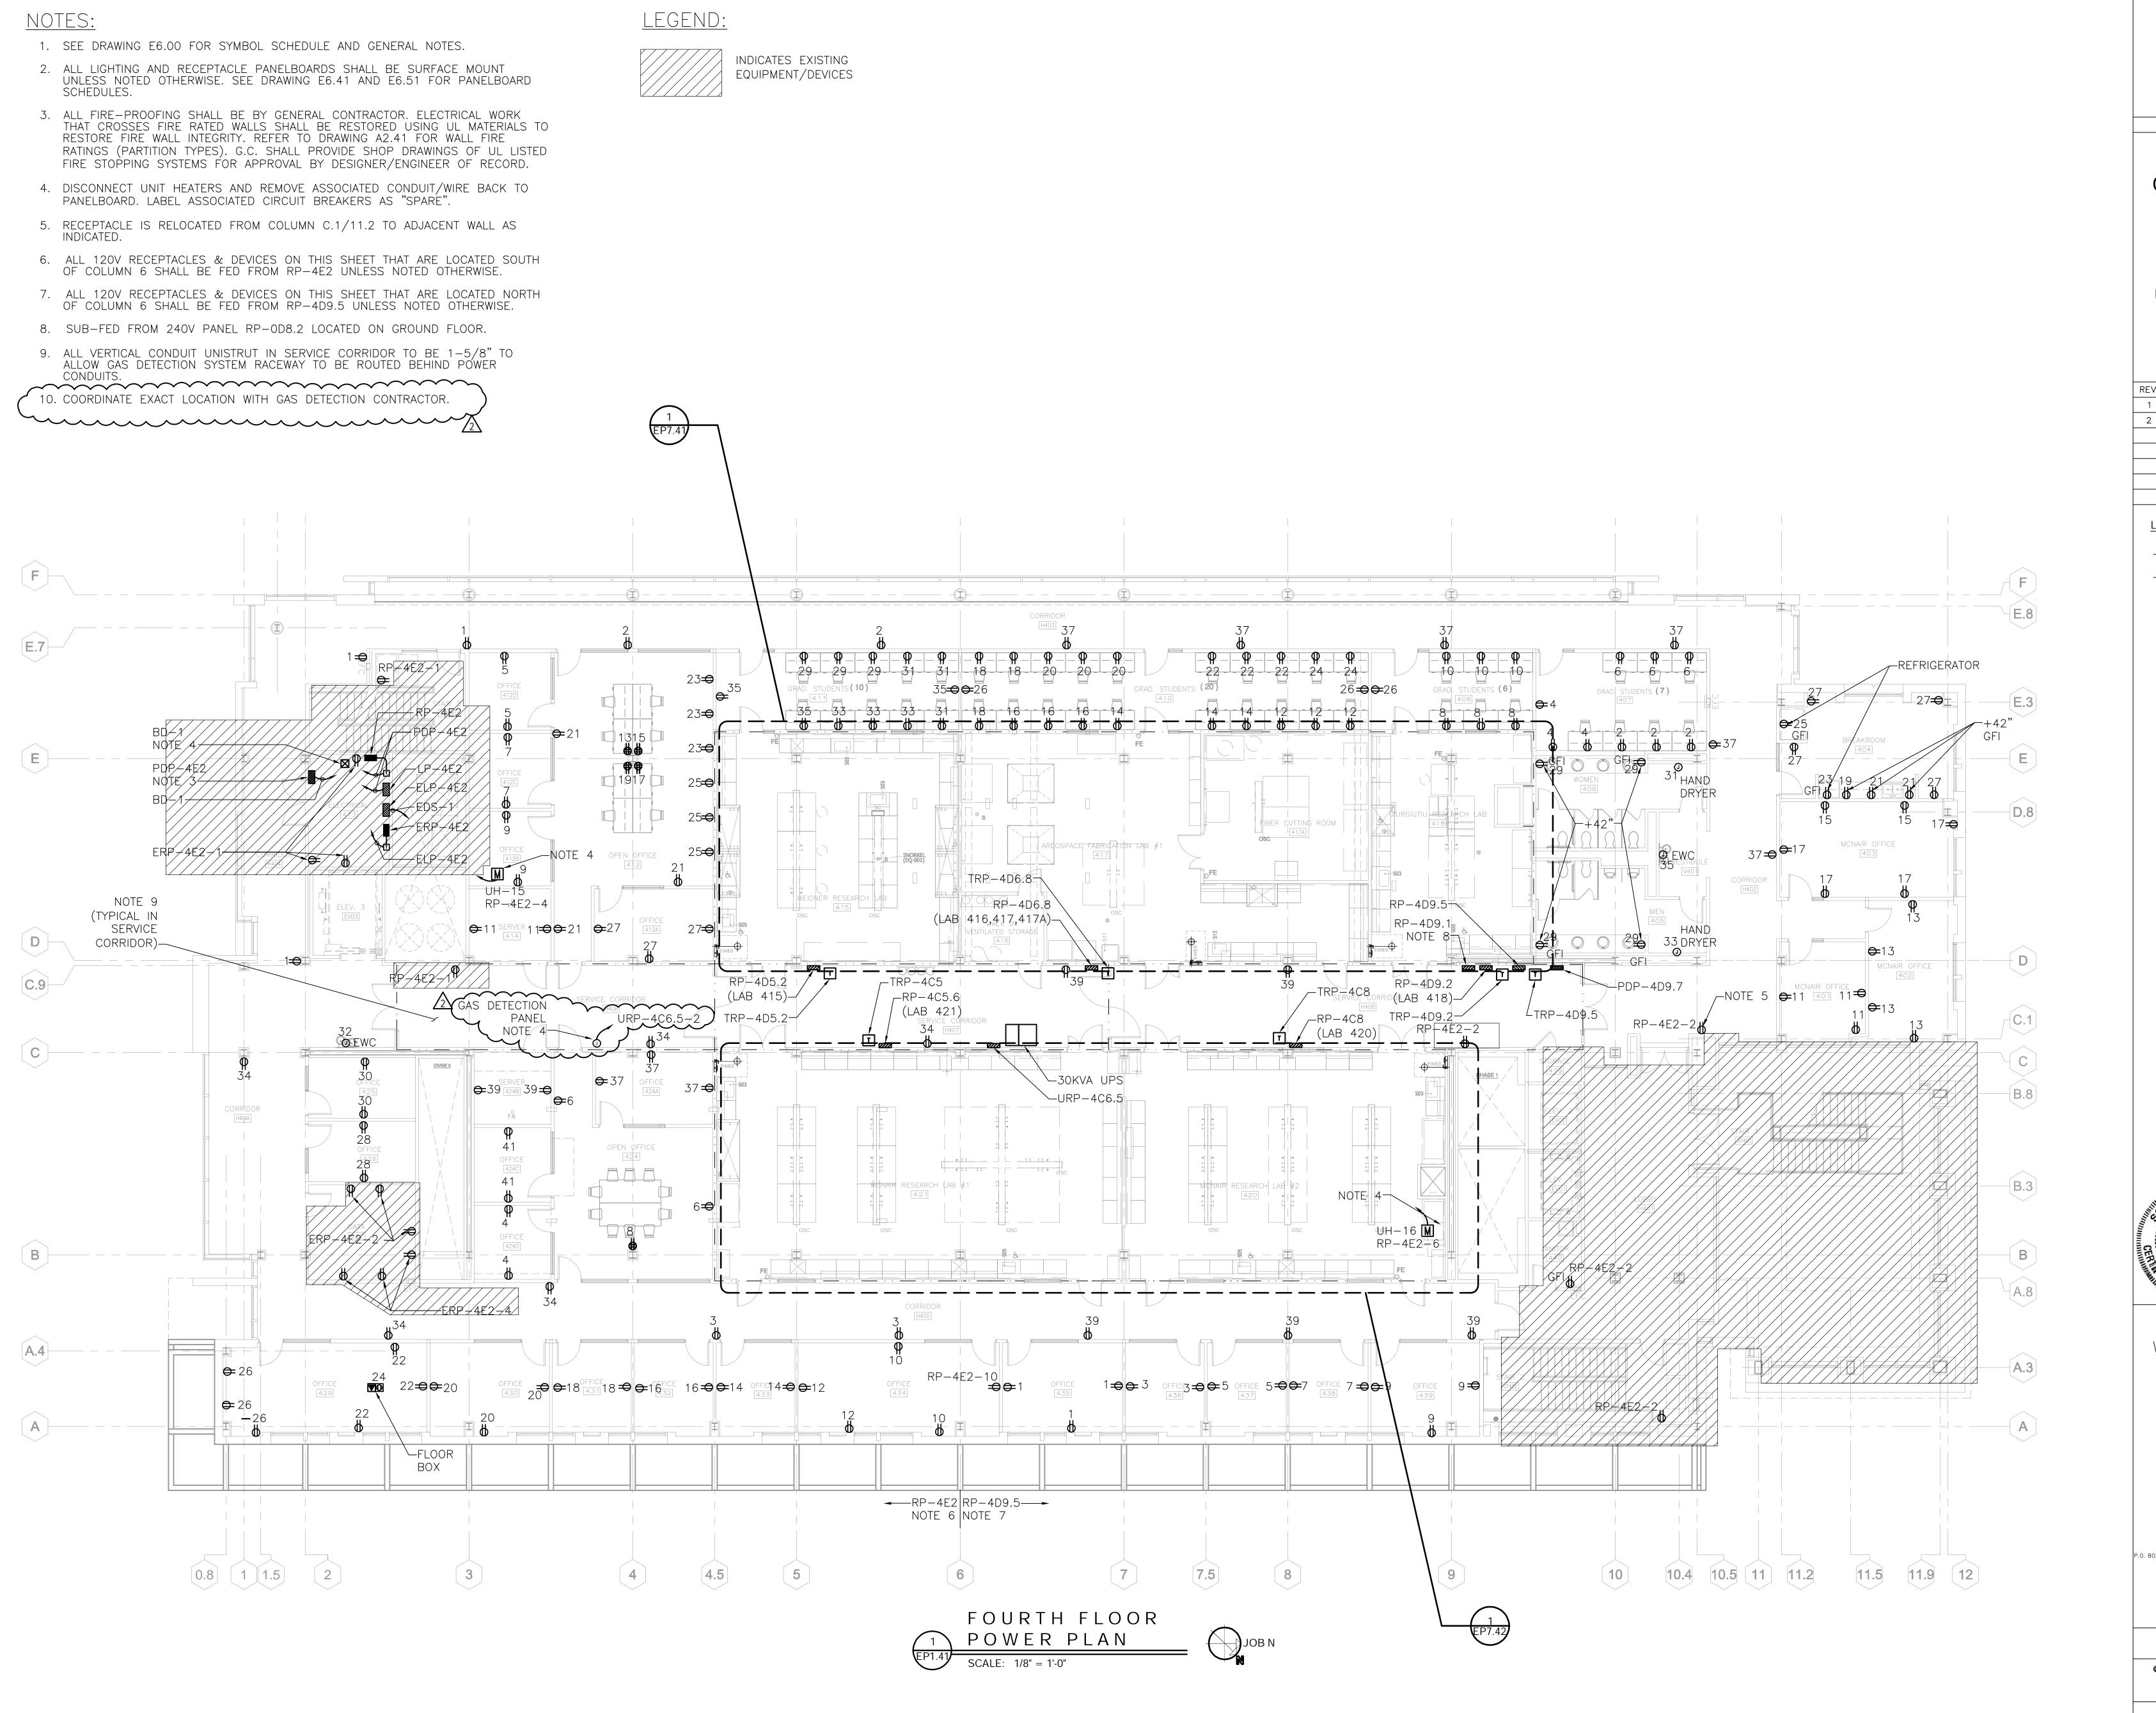



STATE PROJECT NO.: H27-6081-AC

HORIZON I GROUND & FOURTH FLOORS UPFIT

University of South Carolina 541 Main Street Columbia, South Carolina

REV. DATE DESCRIPTION

1 07/17/13 ADDENDUM 1

2 07/25/13 ADDENDUM 2

<u>LEGEND</u>

— HOUR RATED WALL— 2 HOUR RATED WALL



WATSON TATE SAVORY

Fourth Floor Power Plan

P.O. BOX 8444. COLUMBIA, SC 29202 1316 WASHINGTON STREET. COLUMBIA, SC 29201

EP1.41WTS NO.: 11700

JUNE 17, 2013

These drawings are the property of Watson Tate Savory Architects and may not be used in whole or in part without written consent of the architects and any infringement is subject to legal action.



STATE PROJECT NO.: H27-6081-AC

HORIZON I **GROUND & FOURTH FLOORS UPFIT**

University of South Carolina 541 Main Street Columbia, South Carolina

WATSON TATE SAVORY

Riser Diagram

P.O. BOX 8444. COLUMBIA, SC 29202 1316 WASHINGTON STREET. COLUMBIA, SC 29201

WTS NO.: 11700

2.6. ERP-0D2

ONE LINE DIAGRAMS.

INDICATES EXISTING EQUIPMENT/DEVICES


BREAKER. PROVIDE NEW 4#6 &


#8GND. WIRE. AS REQUIRED.


3. REFER TO SHEETS EP5-64, EP5-65, EP5-66, AND EP5-67 FOR


JUNE 17, 2013

C These drawings are the property of Watson Tate Savory Architects and may not be used in whole or in part without written consent of the architects and any infringement is subject to legal action.

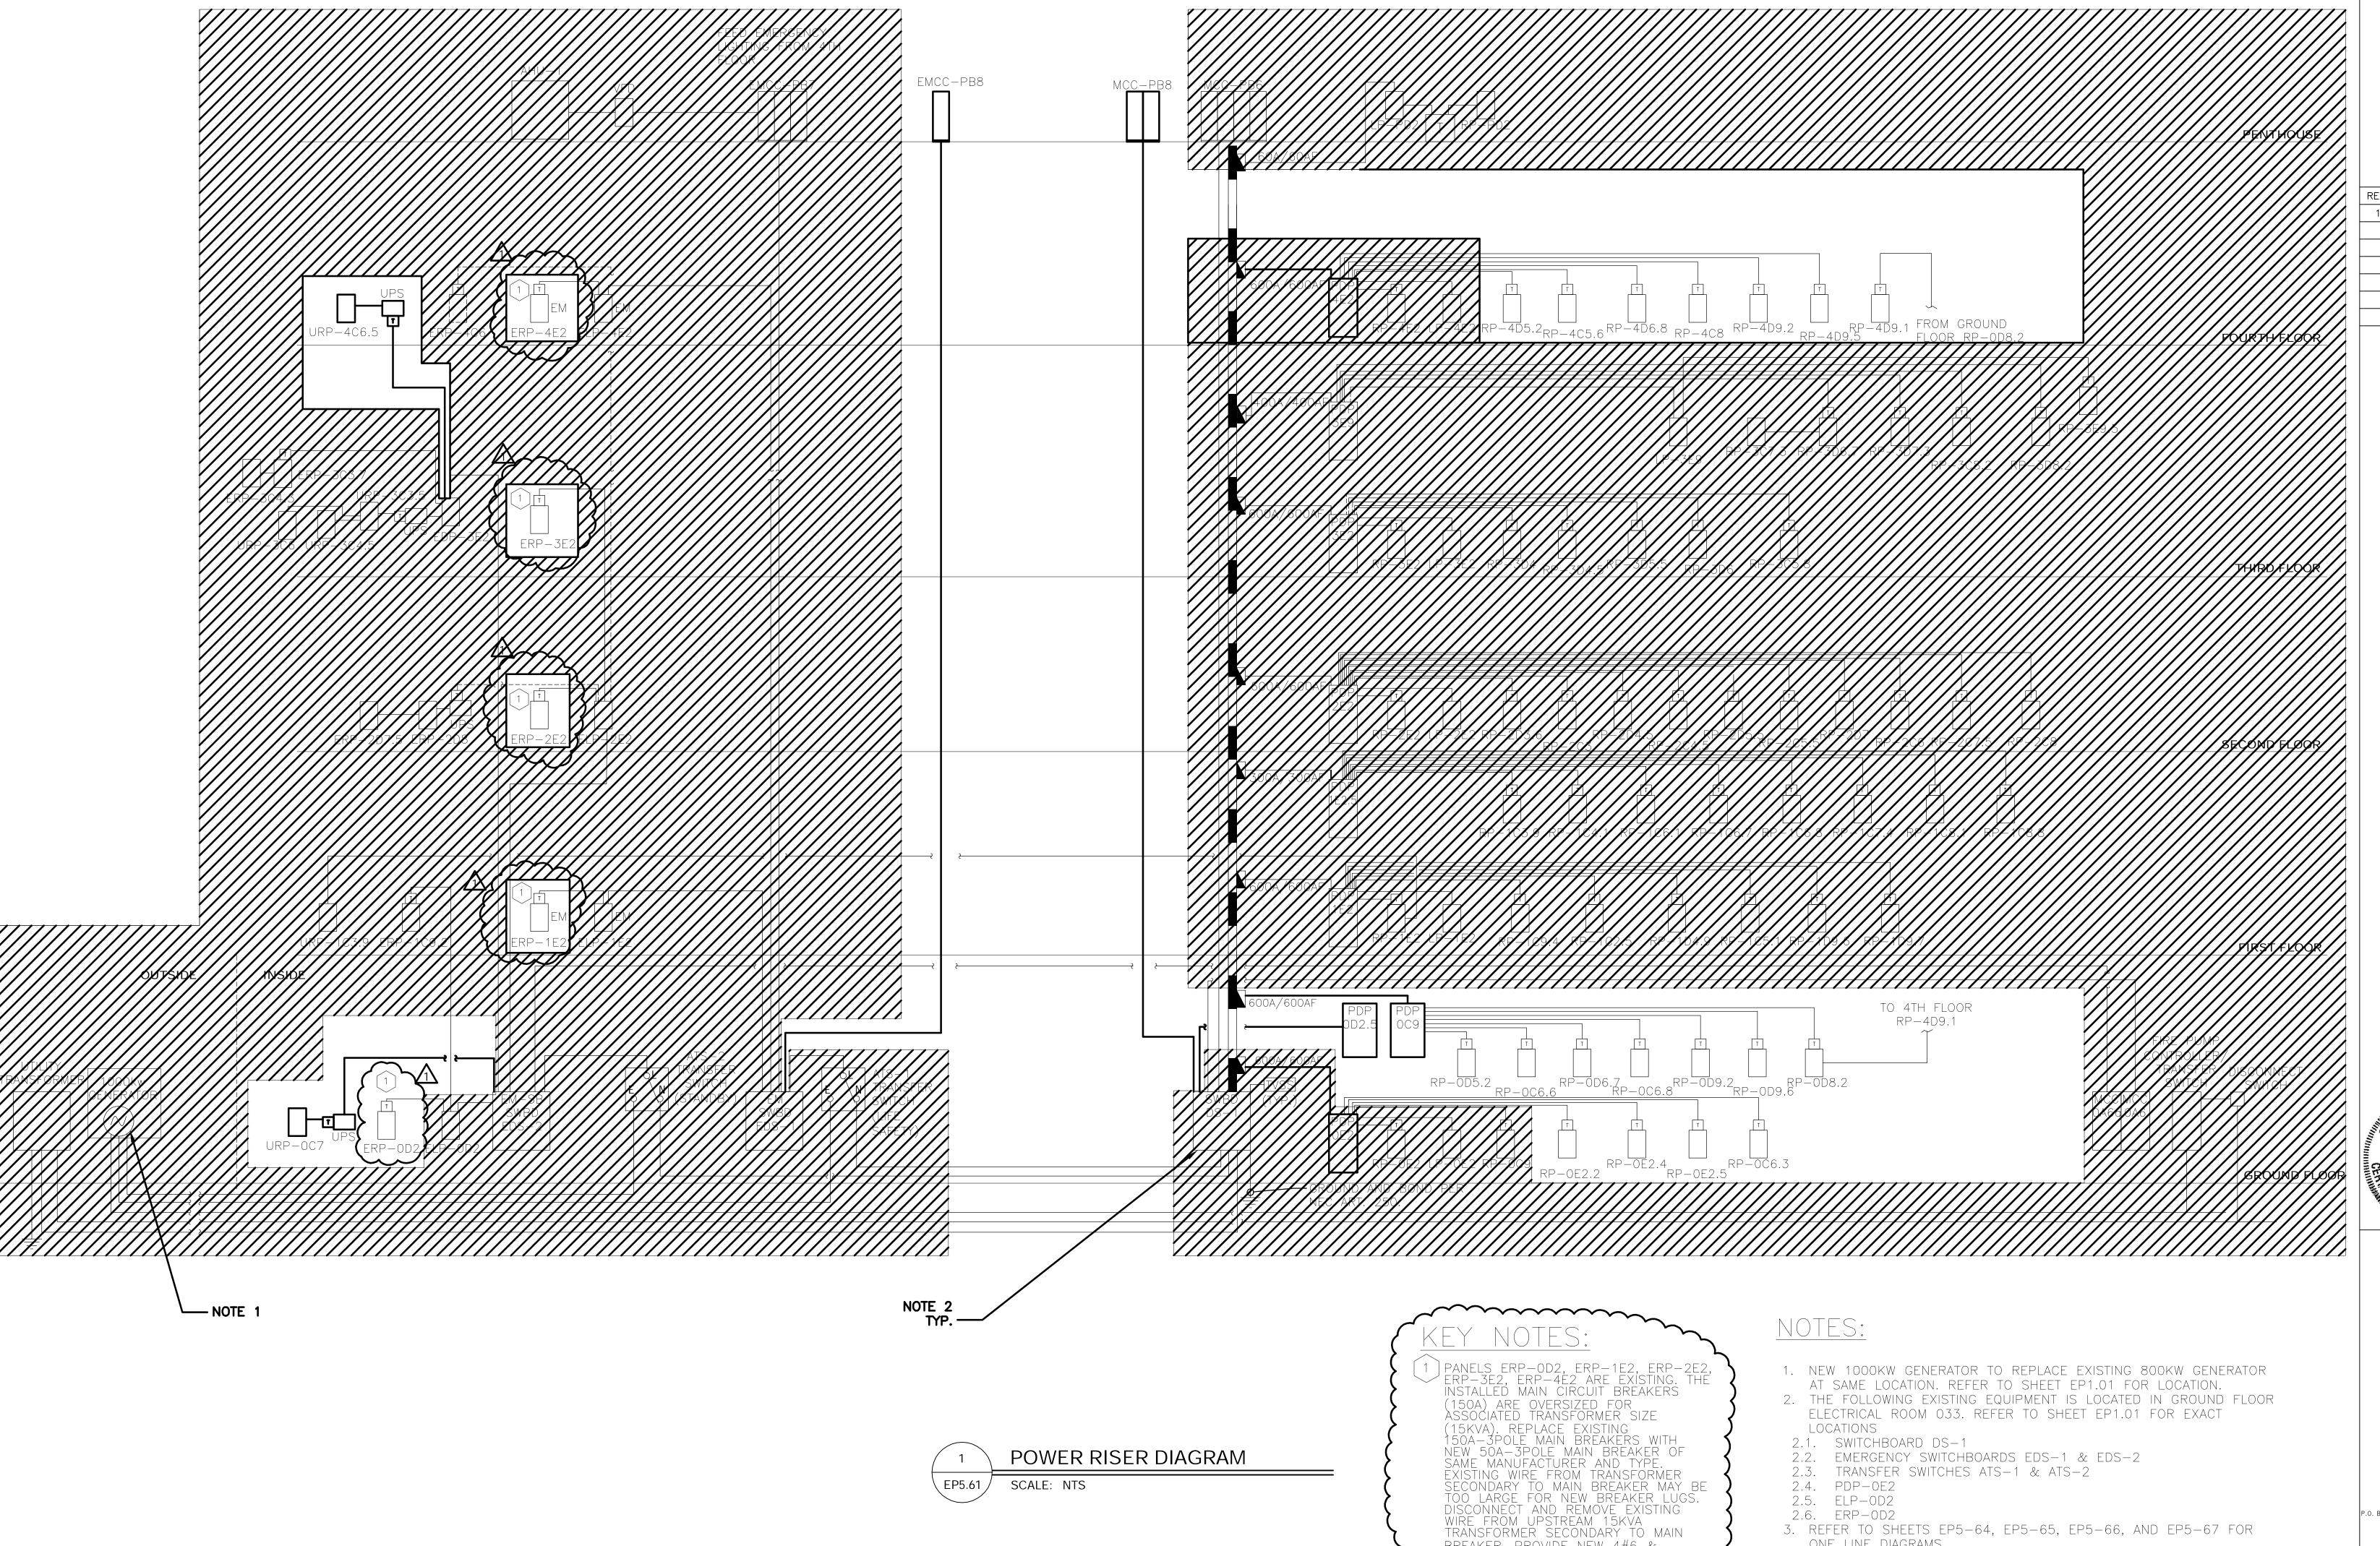


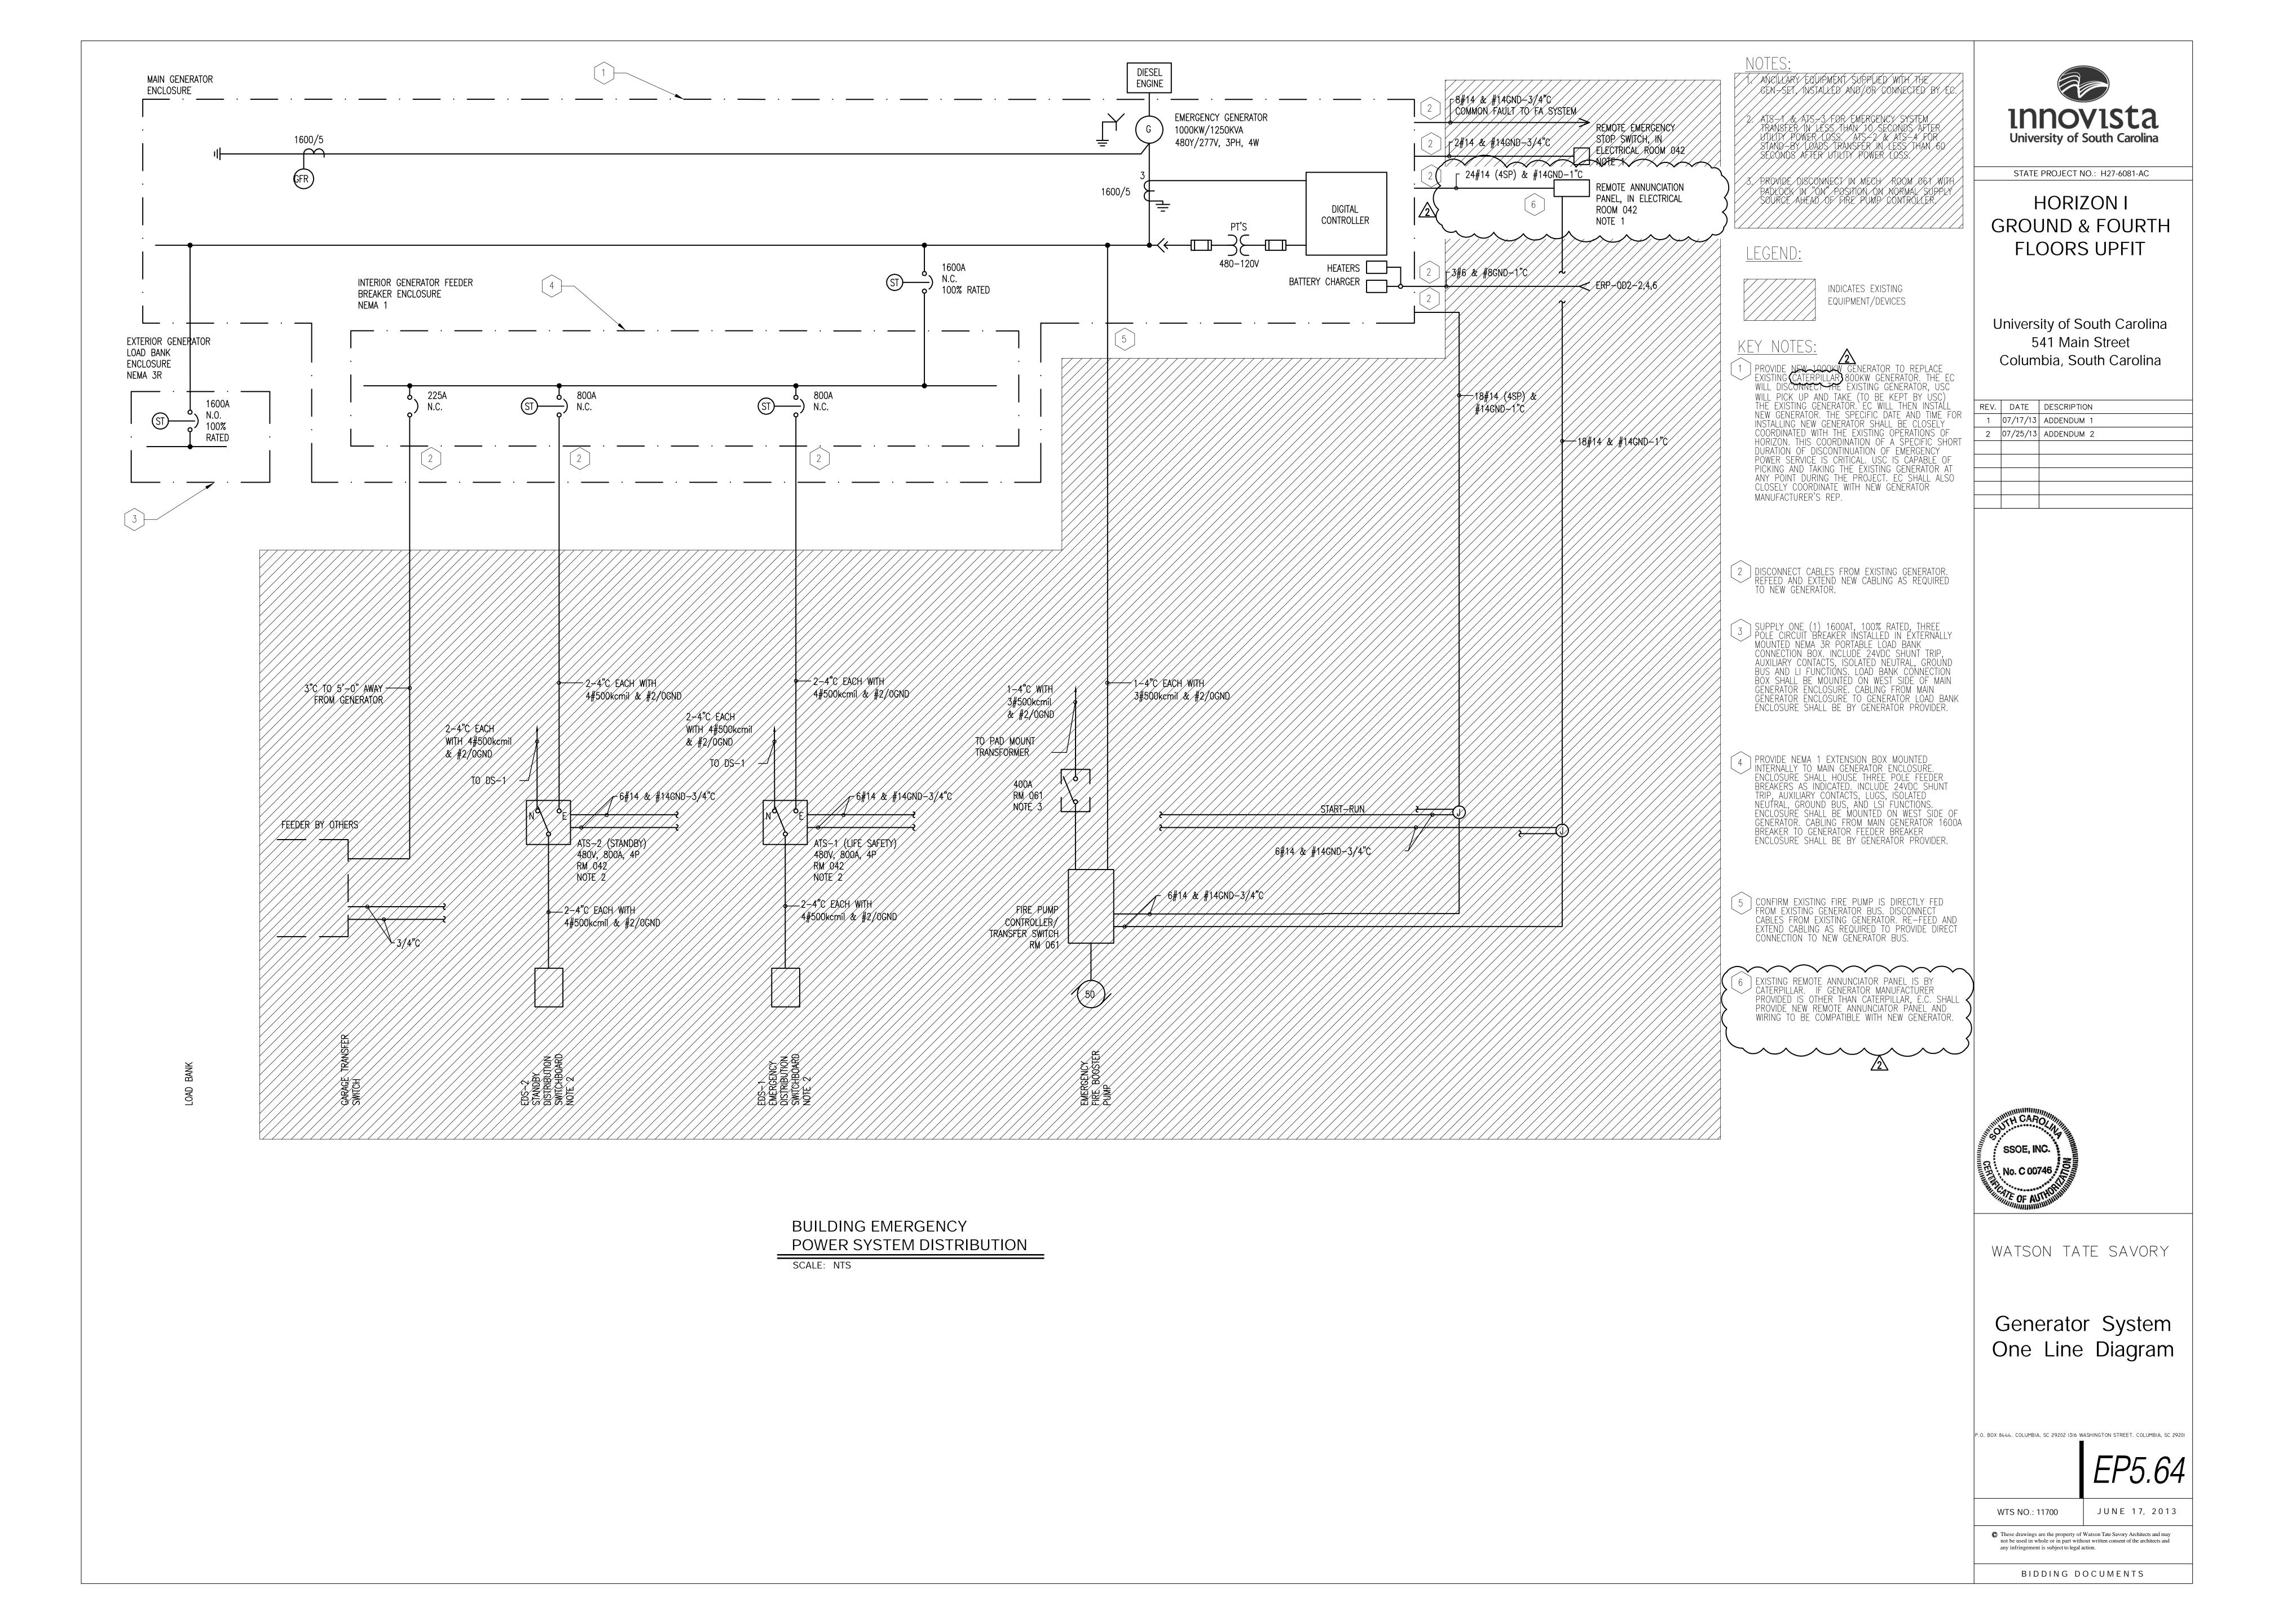

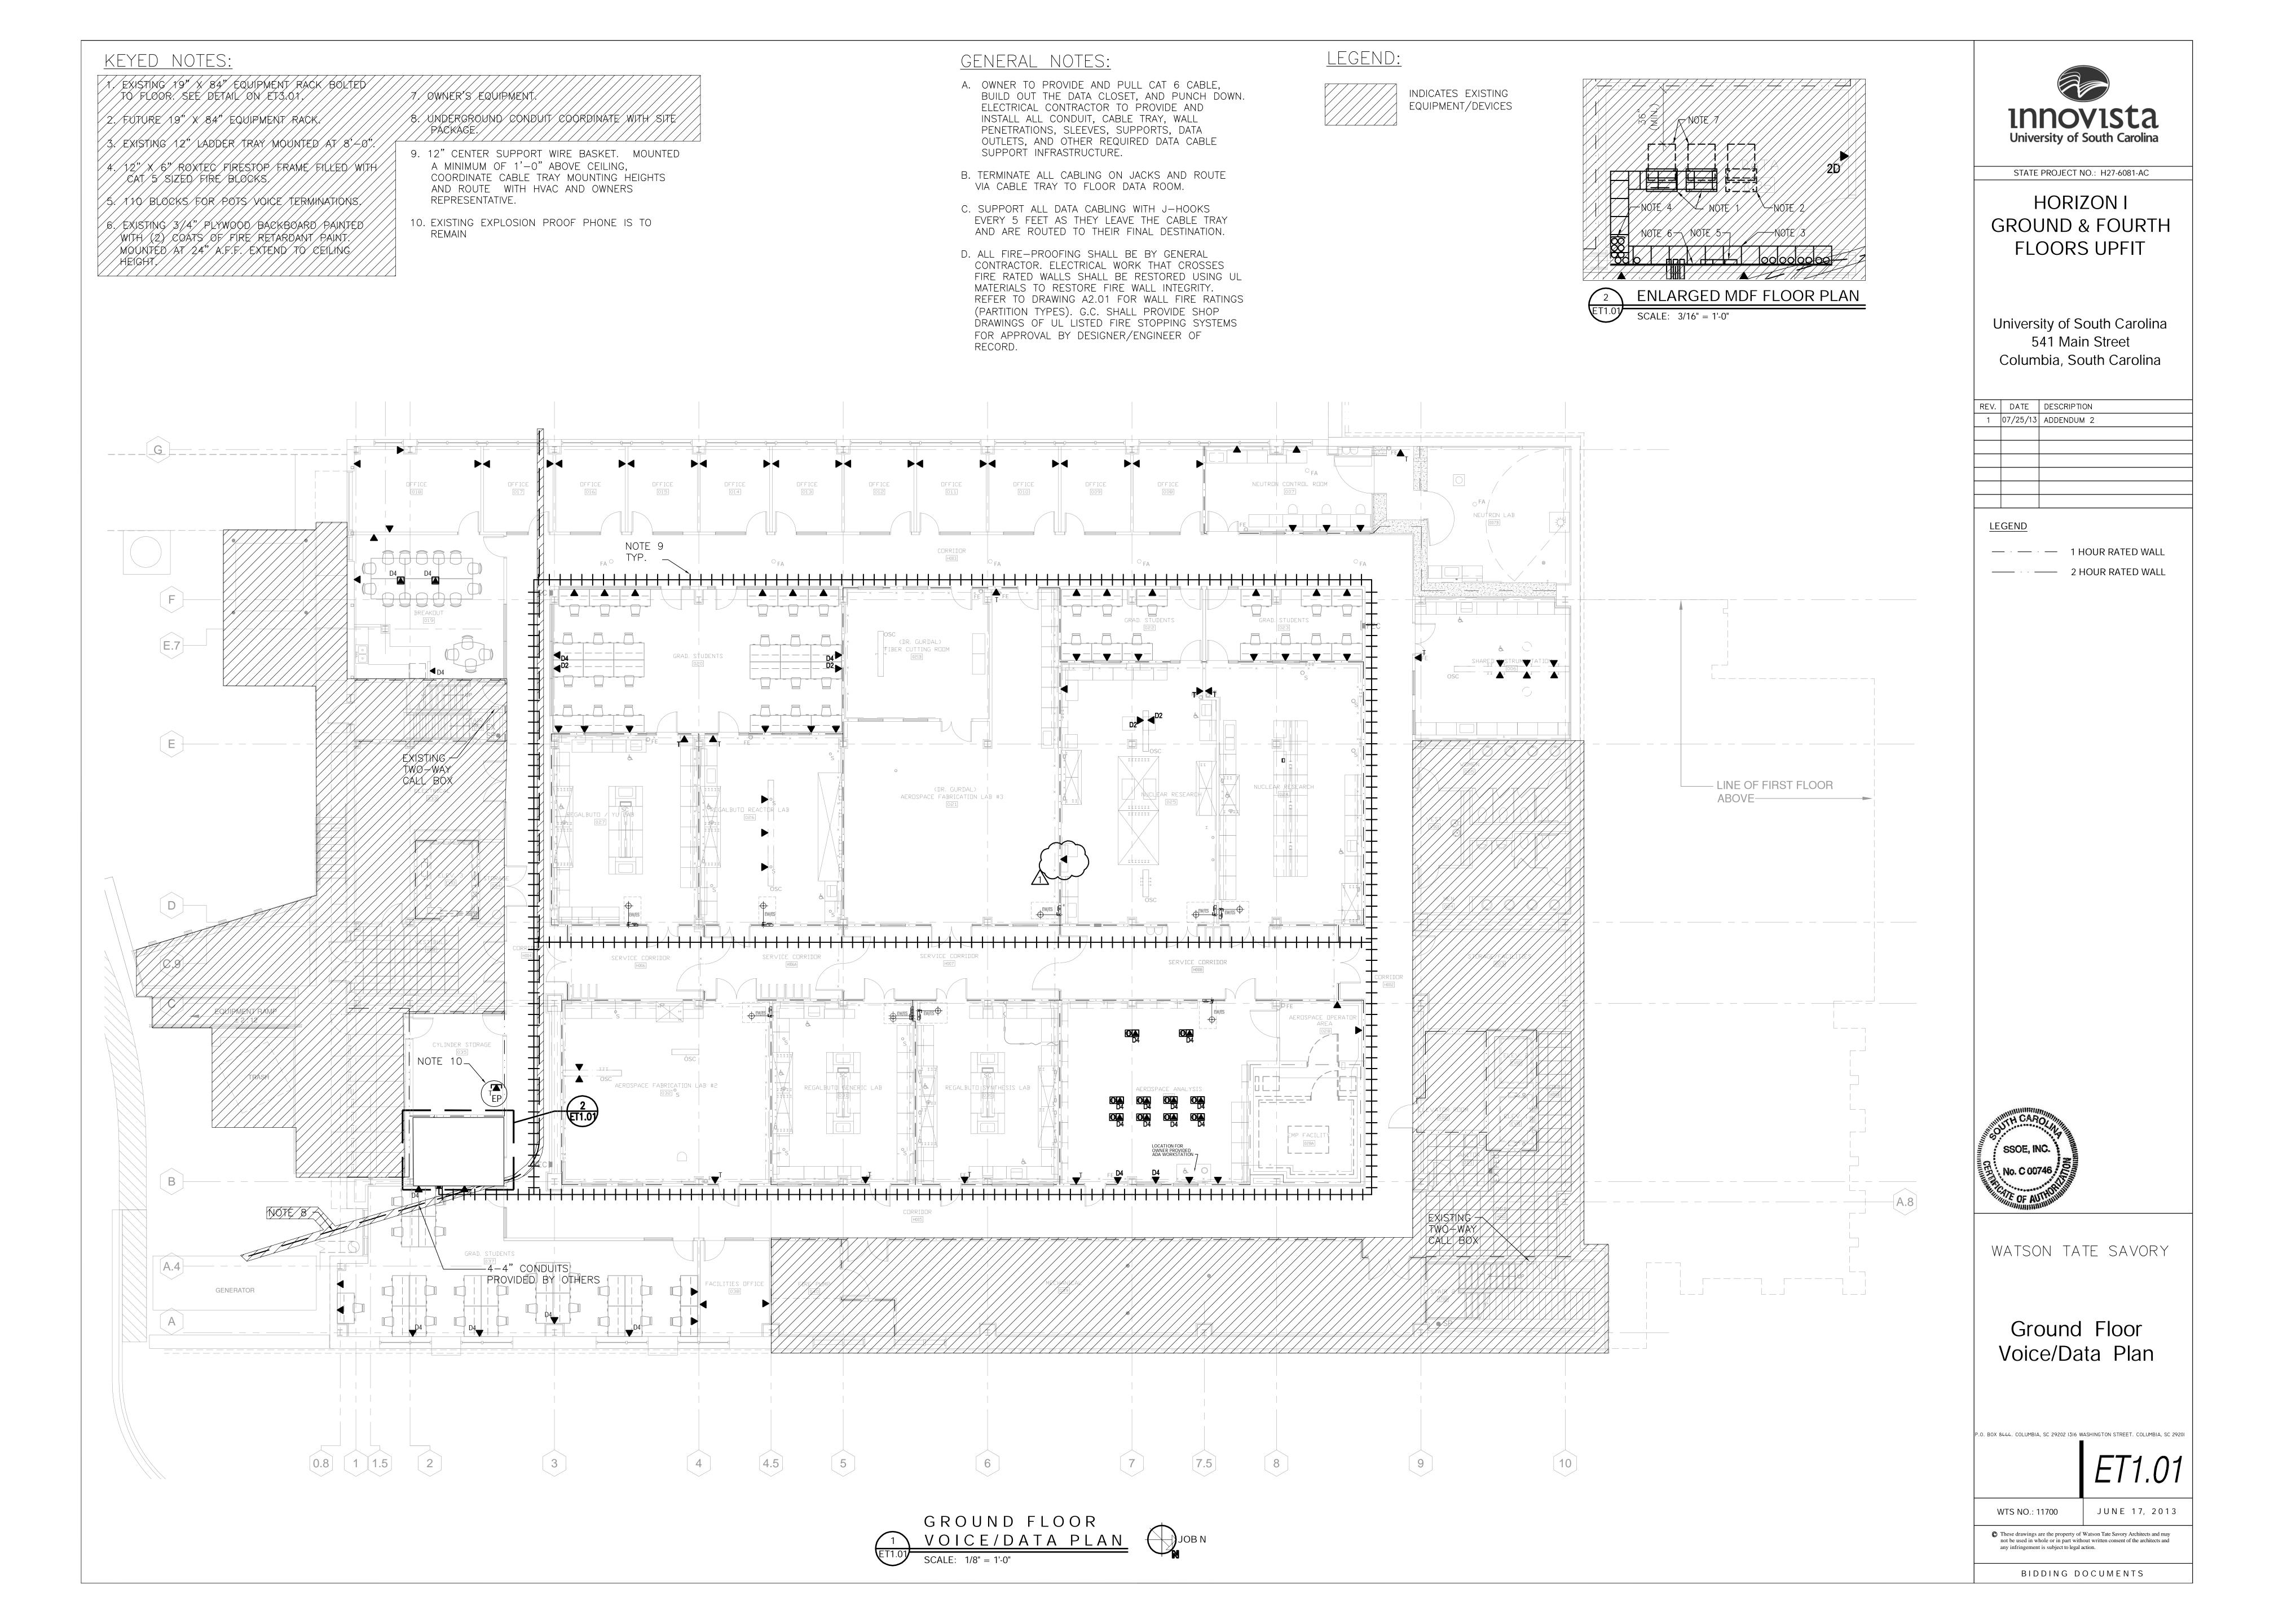

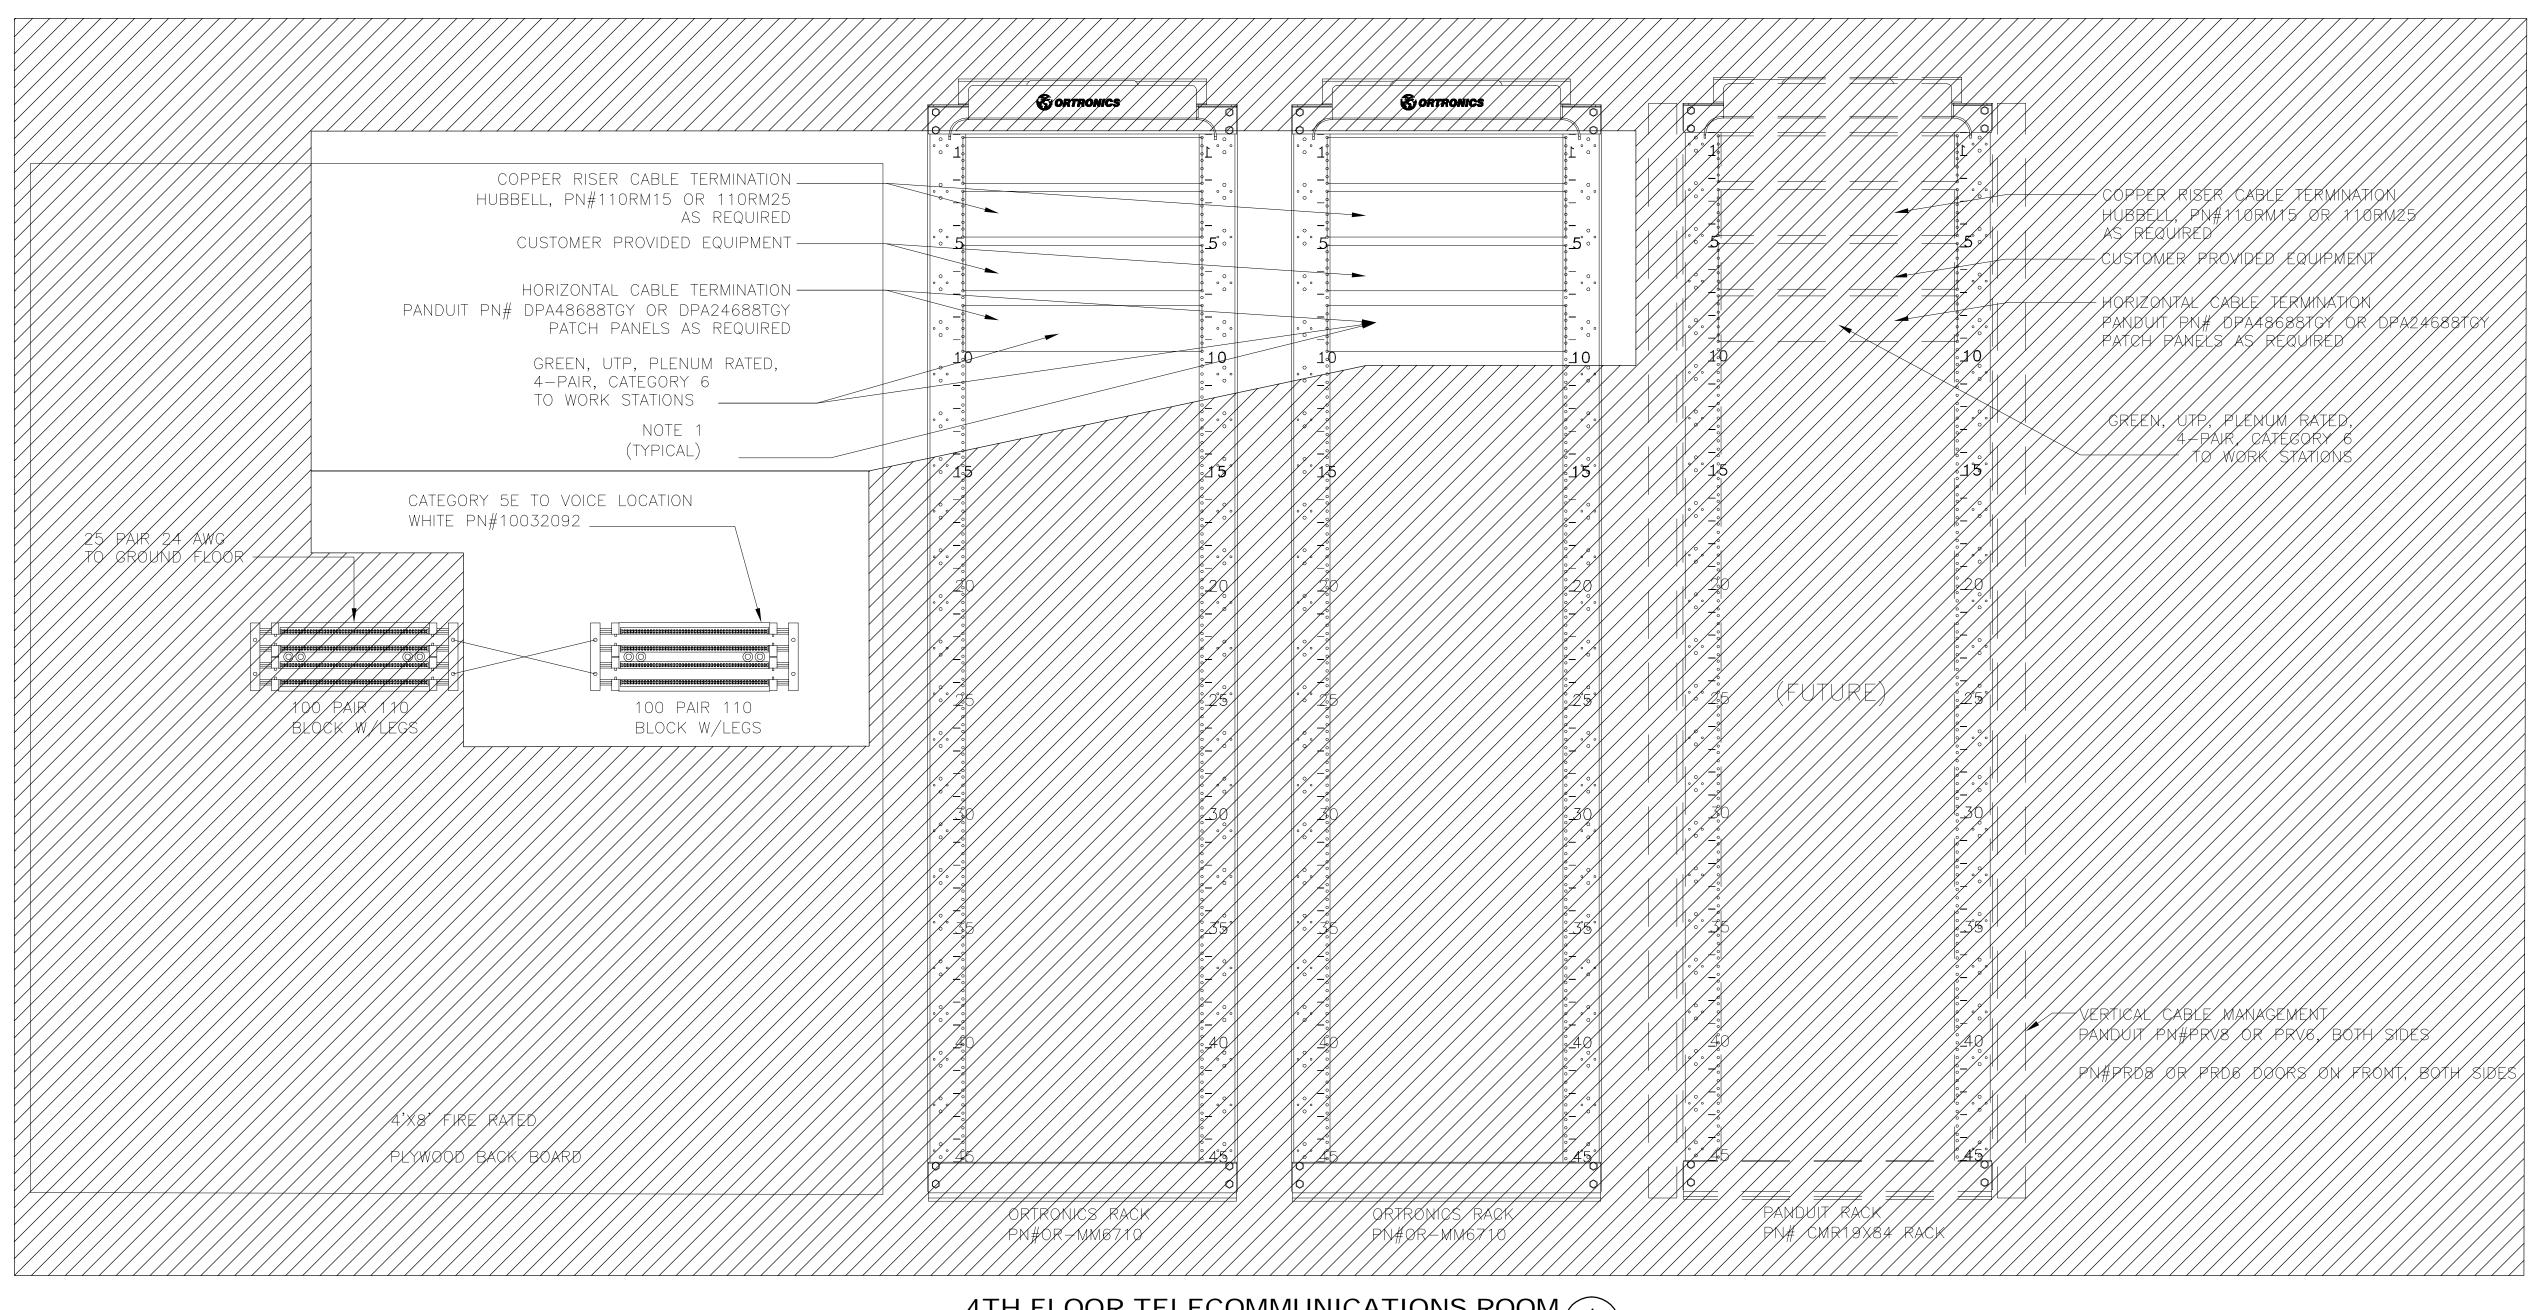

4TH FLOOR TELECOMMUNICATIONS ROOM 1

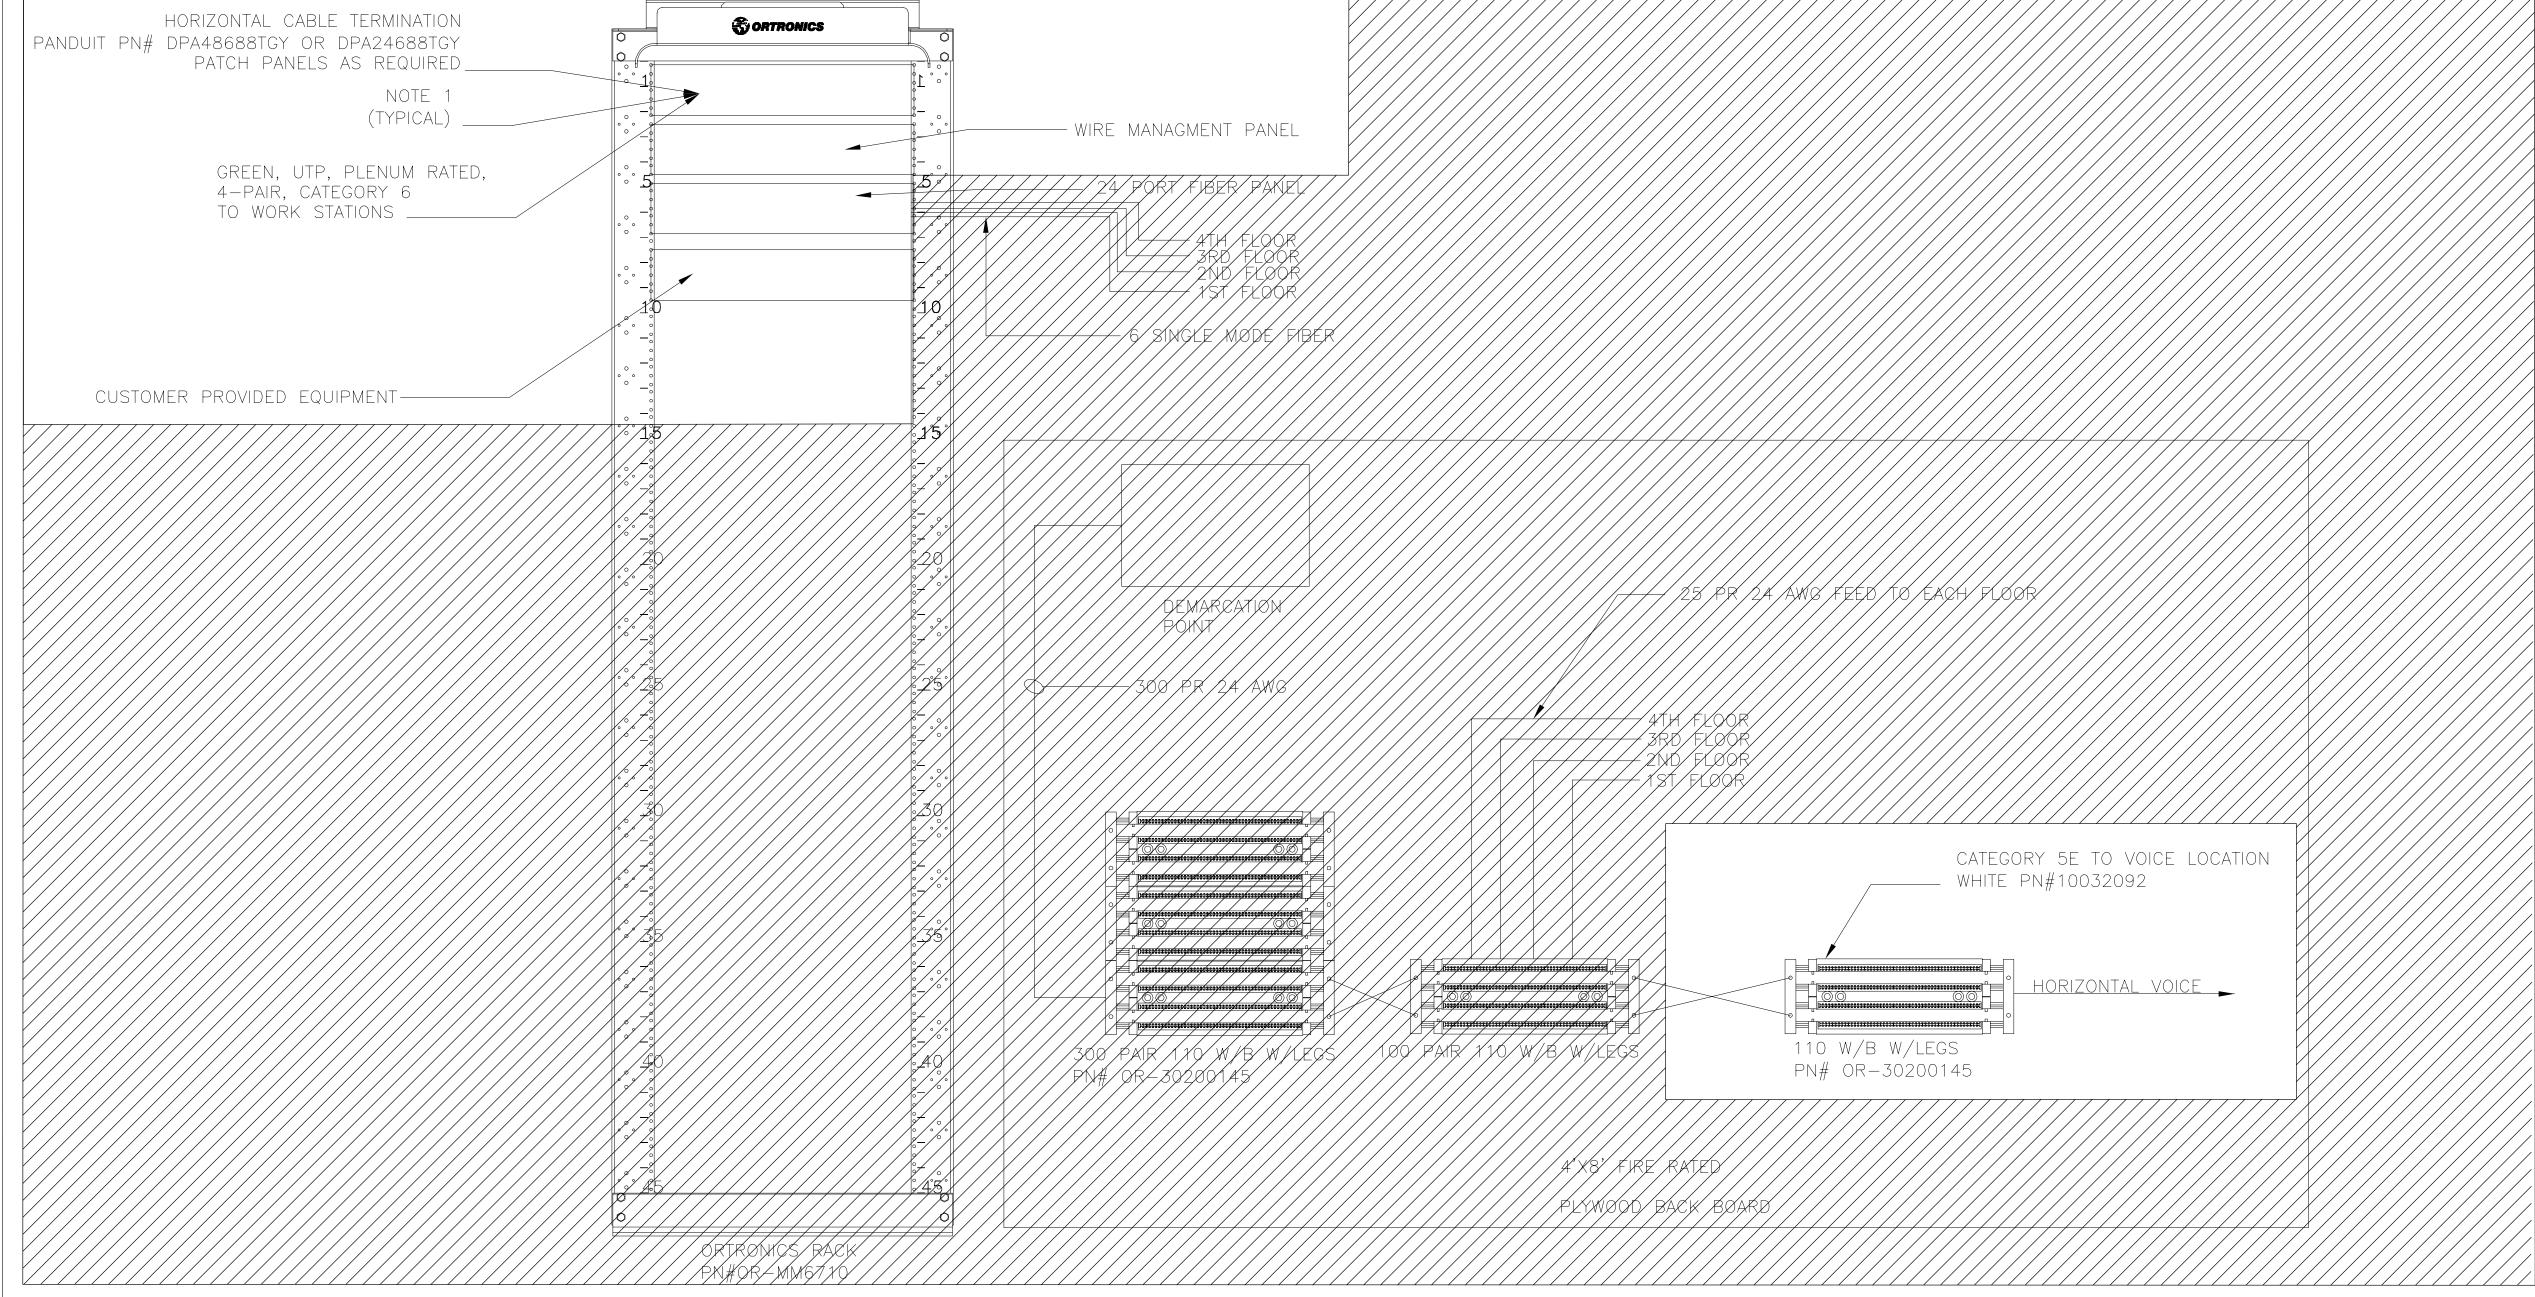

VOICE/DATA GENERAL NOTES:

- A. OWNER TO PROVIDE AND PULL CAT 6 CABLE, BUILD OUT THE DATA CLOSET, AND PUNCH DOWN. ELECTRICAL CONTRACTOR TO PROVIDE AND INSTALL ALL CONDUIT, CABLE TRAY, WALL PENETRATIONS, SLEEVES, SUPPORTS, DATA OUTLETS, AND OTHER REQUIRED DATA CABLE SUPPORT INFRASTRUCTURE.
- B. VOICE AND DATA CABLES ARE TO BE UL/NEC LISTED TYPE AND INSTALLED AS PER NEC #725, 770, 800 AND EIA/TIA 568A AS APPLICABLE, UNLESS OTHERWISE STATED IN SPECIFICATIONS.
- C. ALL DATA AND VOICE CABLES ARE TO BE CATEGORY 6.
- D. CABLES SHALL BE PLACED WITH SUFFICIENT BENDING RADIUS SO AS NOT TO KINK SHEAR OR DAMAGE JACKETS.
- E. ALL HORIZONTAL CABLE SHALL BE PLENUM RATED IN PLENUM AREAS.


. UNATTACHED WIRES, CABLES OR BUNDLES ARE NOT PERMITTED.

G. GENERAL CONTRACTOR IS RESPONSIBLE FOR SLEEVING AND FIRE SEALING OF VOICE AND DATA UTILIZED OPENINGS IN ANY AND ALL FIRE RATED WALLS, FLOOR AND CEILINGS. INCLUDING TELECOMMUNICATIONS CLOSETS.

- H. ALL VOICE AND DATA WORK SHALL BE CLOSELY COORDINATED WITH "OWNER".
- I. ALL CONDUITS, RECESSED WALL BOXES AND PULL WIRES ARE TO BE SUPPLIED BY ELECTRICAL CONTRACTOR.
- J. ALL CABLES ARE TO BE HELD TIGHT TO BUILDING STEEL EVERY 48" TO 60" USING VELCRO TIE WRAPS. USE PLENUM TIE WRAPS IN PLENUM AREAS. WHERE CABLE LEAVES THE CABLE TRAY, THEY MUST BE PROPERLY ATTACHED USING J-HOOKS.
- K. OWNER MUST TAKE CARE TO FASTEN CABLES IN A MANNER CONSISTANT WITH THE GUIDELINES ESTABLISHED BY THE ANSI/EIA/TIA 568A AND 569 STANDARDS.
- L. OWNER SHALL TERMINATE AND LABEL EACH NEW VOICE AND DATA CABLE WITH THE DATE OF INSTALLATION/CERTIFICATION AND ITS RESPECTIVE NUMBERING SCHEME. THE LABEL MUST BE MACHINE MADE, NOT HANDWRITTEN AND PLACED AT BOTH ENDS OF THE CABLE. CABLES TO BE TERMINATED IN NUMERICAL ROOM NUMBER ORDER.
- M. OWNER SHALL KEEP ALL WIRE TAILS BETWEEN THE WIRED JUNCTION BOXES AND THE MODULAR FURNITURE AS SHORT AS POSSIBLE.
- N. OWNER SHALL BE RESPONSIBLE FOR CROSS CONNECTING THE NEW HORIZONTAL VOICE CABLE TO THE COPPER VOICE RISER. THE VOICE/DATA CONTRACTOR WILL BE RESPONSIBLE TO PROVIDE ALL VERTICAL RISER CABLE FROM THE TR 110 BLOCK TO THE MAIN MC LOCATION. AS WELL AS A 300 PAIR FEED FROM THE PBX LOCATION TO THE PHONE COMPANY DEMARC. THE VOICE/DATA CABLING CONTRACTOR SHALL FIELD COORDINATE WITH THE "OWNER" TO DETERMINE THE APPROPRIATE RISER PAIRS FOR CROSS—CONNECTION.
- O. NEW DATA PATCH PANELS SHALL BE 48 PORT, CATEGORY 6 MODULAR PATCH PANELS.
- P. OWNER SHALL PROVIDE SUFFICIENT QUANTITY OF CAT 6 PATCH PANELS AND TWO POSITION ORGANIZER PANELS TO PROVIDE FOR ALL DATA JACKS AND FOR 20% EXPANSION ON EACH RACK.
- Q. OWNER SHALL PROVIDE A VERTICAL POWER DISTRUBUTION UNIT FOR EACH RACK.
- R. BETWEEN CLOSETS (TELECOMMUNICATIONS ROOMS ON EACH FLOOR)
 THERE WILL BE A SIX STRAND FIBER, AND A 25 PAIR COPPER CABLE.
 THE DATA RISER SHALL SHOW THIS. THE SINGLE MODE 6 FIBER CABLE
 TO BE TERMINATED USING LC CONNECTORS. FIBER SHALL BE INSTALLED
 IN 1" INNERDUCT.
- S. USE 568-B PIN OUT CONFIGURATION FOR TERMINATING ALL RJ45 JACKS AND PATCH PANELS.

NOTES:

1. PART NUMBERS INDICATED ARE BASED ON USC COMMUNICATIONS INFRASTRUCTURE GUIDELINES FOR NEW RACKS AND EQUIPMENT. PART NUMBERS FOR NEW EQUIPMENT IN EXISTING RACKS SHALL BE COORDINATED WITH OWNER AND EXISTING EQUIPMENT ON SITE.

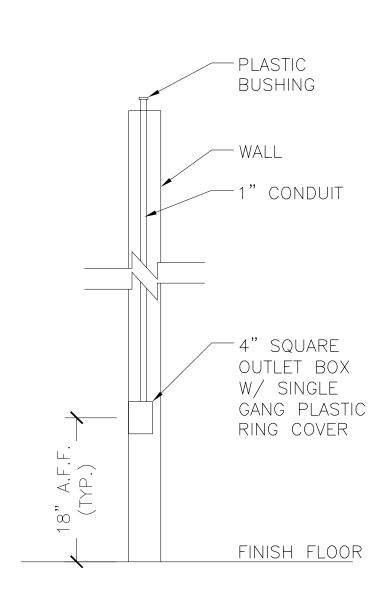

TYPICAL WALL MOUNT VOICE/DATA OUTLET 3




STATE PROJECT NO.: H27-6081-AC

HORIZON I GROUND & FOURTH FLOORS UPFIT

University of South Carolina 541 Main Street Columbia, South Carolina

REV.	DATE	DESCRIPTION
1	07/17/13	ADDENDUM 1
2	07/25/13	ADDENDUM 2

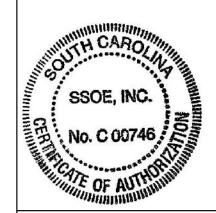

WATSON TATE SAVORY

Electrical
Voice/Data Details
& General Notes

P.O. BOX 8444. COLUMBIA, SC 29202 1316 WASHINGTON STREET. COLUMBIA, SC 29201

WTS NO.: 11700

ET3.01

JUNE 17, 2013

These drawings are the property of Watson Tate Savory Architects and may not be used in whole or in part without written consent of the architects and any infringement is subject to legal action.

BIDDING DOCUMENTS

MAIN CLOSET GROUND FLOOR 2

NTS ---

ADDENDUM NO. 3

Date: July 29, 2013

RE: Watson Tate Savory Architects, Inc.

USC Horizon I Ground and Fourth Floors Upfit

To: Bidders: This addendum forms a part of the contract documents and modifies the

original Bidding Documents dated June 17, 2013. Acknowledge receipt of this

addendum in the space provided on the bid form.

From: SSOE Group

2520 Meridian Parkway, Suite 450

Durham, NC 27707 Phone: (919) 361-9606 Fax: (919) 484-8627

CLARIFICATIONS

Electrical

Drawing EP1.01

- 1. Revise note 7. Revise drawing to indicate "NAC" instead of "FACP". Revise to indicate existing NAC panel location and corrected new location.
- 2. Replace this drawing with drawing EP1.01 in this addendum.

Drawing EL1.01

- 1. Add note 15 and note 15 callout at lighting control panel.
- 2. Replace this drawing with drawing EL1.01 in this addendum.

Drawing EA1.01

- 3. Revise note 7. Revise drawing to indicate "NAC" instead of "FACP". Revise to indicate existing NAC panel location and corrected new location.
- 4. Replace this drawing with drawing EA1.01 in this addendum.

Addendum Clarifications:

1. On drawing EA1.01, note #18 states that the existing fire alarm panel is to be relocated. The symbol (FACP), for this indicates that it is a fire alarm control panel. TriTek completed the original fire alarm installation for this building and our records indicate that the fire alarm control panel is located on the first floor directly above this electrical room. There is a NAC power panel located in the ground floor electrical room that has note

ADDENDUM NO. 3

#18. Can you clarify for me as to which panel needs to be moved, either the NAC panel located on the ground floor or in fact the FACP located on the 1st floor?

Response: Panel to be relocated is NAC panel Ground Floor Elec Room. Refer to drawings EA1.01, EL1.01, and EP1.01 in this addendum 3 for clarification on NAC panel and coordination with new lighting control panel.

END OF ADDENDUM

