

## AMENDMENT NO. 1

- TO: ALL VENDORS
- **FROM:** Lana Widener
- SUBJECT: USC-IFB-2494-LW Mechanical Equipment for USC Coker Life Science Building
- **DATE:** August 21, 2013

This Amendment No. 1 modifies the Invitation for Bids only in the manner and to the extent as stated herein.

- ITEM ONE: **EXTENDED DEADLINE FOR RECEIPT OF BIDS** TO SEPTEMBER 5, 2013, 11:00 AM
- ITEM TWO: **EXTENDED DEADLINE FOR RECEIPT OF QUESTIONS** TO AUGUST 28, 2013, 10:00 AM
- ITEM THREE: REPLACE THE ORIGINAL SECTION 15840 AIR TERMINAL UNITS WITH ATTACHED DOCUMENT SECTION 15840 – AIR TERMINAL UNITS
- ITEM FOUR: **Replace the Original Drawings M2.7 and M7.1** with the Attached Drawings M2.7 and M7.1

BIDDER SHALL ACKNOWLEDGE RECEIPT OF AMENDMENT NO. 1 IN THE SPACE PROVIDED BELOW AND RETURN IT **WITH THEIR BID RESPONSE**. FAILURE TO DO SO MAY SUBJECT BID TO REJECTION.

Authorized Signature

Firm

Date

## SECTION 15840 - AIR TERMINAL UNITS

#### PART 1 GENERAL

#### 1.01 SECTION INCLUDES

- A. Terminal units.
- B. Electronic Airflow Control Valves

#### **1.02 RELATED REQUIREMENTS**

- A. Section 15065 Motors for Mechanical Equipment.
- B. Section 15182 Hydronic Piping: Connections to heating coils.
- C. Section 15183 Hydronic Specialties: Connections to heating coils.
- D. Section 15810 Ducts.
- E. Section 15820 Duct Accessories.
- F. Section 15850 Air Outlets and Inlets.
- G. Section 15928 Instruments and Control Elements: Thermostats and Actuators.

#### 1.03 SUBMITTALS

- A. See Section 01300 Administrative Requirements for submittal procedures.
- B. Product Data: Provide data indicating configuration, general assembly, and materials used in fabrication. Include catalog performance ratings that indicate air flow, static pressure, and NC designation. Include electrical characteristics and connection requirements.
- C. Shop Drawings: Indicate configuration, general assembly, and materials used in fabrication, and electrical characteristics and connection requirements.
  - 1. Include schedules listing discharge and radiated sound power level for each of second through sixth octave bands at inlet static pressures of 1 to 4 inch wg.
- D. Project Record Documents: Record actual locations of units.
- E. Operation and Maintenance Data: Include manufacturer's descriptive literature, operating instructions, maintenance and repair data, and parts lists. Include directions for resetting constant volume regulators.
- F. Warranty: Submit manufacturer warranty and ensure forms have been completed in Owner's name and registered with manufacturer.
- G. Operation and Maintenance Manuals: Include in manuals the information listed below. For information on how to prepare and submit manuals see section 1780 (Closeout Submittals).
  - 1. Spare parts lists
  - 2. Operating instructions
  - 3. Maintenance instructions, including preventative and corrective maintenance.
  - 4. Copies of warranties
  - 5. Wiring diagrams
  - 6. Shop drawings and product data

1.04 WARRANTY

AIR TERMINAL UNITS

- A. See Section 01780 Closeout Submittals, for additional warranty requirements.
- B. Provide five year manufacturer warranty for air terminal units.

## PART 2 PRODUCTS

## 2.01 AIR TERMINAL UNITS

- A. MANUFACTURERS
  - 1. Carrier
  - 2. Enviro-Tec
  - 3. JCI
  - 4. Trane
  - 5. Price
  - 6. Titus
  - 7. Metal Aire
  - 8. Nailor
- B. Refer to schedules for model and type terminal unit specified.
- C. Hot Water Heating Coil:
  - 1. Construction: 1/2 inch copper tube mechanically expanded into aluminum plate fins, leak tested under water to 200 psig pressure, factory installed.
- D. Automatic Damper Operator:
  - 1. Electric Actuator: 24 volt with high limit.

## 2.02 ELECTRONIC AIRFLOW CONTROL VALVE

- A. Manufacturers
  - 1. Phoenix Controls
  - 2. Other acceptable manufacturer's that meet specification
- B. General
  - 1. The airflow control device shall be a venturi valve.
  - 2. The valve assembly manufacturer's Quality Management System shall be registered to ISO 9001:2008.
  - 3. The airflow control device shall be pressure independent over its specified differential static pressure operating range. An integral pressure independent assembly shall respond and maintain specific airflow within one second of a change in duct static pressure irrespective of the magnitude of pressure and/or flow change or quantity of airflow controllers on a manifolded system.
  - 4. The airflow control device shall maintain accuracy within  $\pm 5\%$  of signal over an airflow turndown range of no less than:
    - a. Standard Valve Body Type
      - 1) Up to 1000 CFM 20 to 1
      - 2) Up to 1500 CFM 16 to 1
      - 3) Up to 2500 CFM 12 to 1
    - b. Shut-off Valve Body Type
      - 1) Up to 850 CFM 17 to 1
      - 2) Up to 1300 CFM 14 to 1
      - 3) Up to 1600 CFM 8 to 1
  - 5. No minimum entrance or exit straight length of duct shall be required to ensure

accuracy and/or pressure independence.

- 6. The airflow control device shall maintain pressure independence regardless of loss of power.
- 7. The airflow control device shall be constructed of one of the following four types:
  - a. Class A-The airflow control device for non-corrosive airstreams, such as supply and general exhaust, shall be constructed of 16-gauge aluminum. The device's shaft and internal "S" link shall be made of 316 stainless steel. The shaft support brackets shall be made of galvaneal (non shutoff valves) or 316 stainless steel (shutoff valves). The pivot arm shall be made of aluminum (for non shutoff valves) and 303/304 stainless (for shut off valves). The pressure independent springs shall be a spring-grade stainless steel. All shaft bearing surfaces shall be made of a PP (polypropylene) or PPS (polyphenylene sulfide) composite. Sound attenuating devices used in conjunction with general exhaust or supply airflow control devices shall be constructed using 24 gauge galvanized steel or other suitable material used in standard duct construction. No sound absorptive materials of any kind shall be used.
  - b. Class B-The airflow control device for corrosive airstreams, such as fume hoods and biosafety cabinets, shall have a baked-on, corrosion-resistant phenolic coating. The device's shaft shall be made of 316 stainless steel with a Teflon coating. The shaft support brackets shall be made of 316 stainless steel. The pivot arm and internal "S" link shall be made of 316 or 303 stainless steel. The pressure independent springs shall be a spring-grade stainless steel. The internal nuts, bolts and rivets shall be stainless steel. All shaft bearing surfaces shall be made of PP (polypropylene) or PPS (polyphenylene sulfide) composite.
- 8. Actuation
  - a. A standard-speed electric actuator shall be used to modulate the airflow over the range of the specific valve size. The maximum time to modulate from minimum to maximum flow shall be less than 60 seconds for standard valves and 90 seconds for shut-off valves. A UL or CSA listed electronic actuator shall be factory mounted to the valve. The actuator shall have sufficient torque to modulate the airflow against the maximum duct static pressure (within product specifications).
- 9. The control valves shall integrate with the BMS.
- 10. Certification
  - a. Each airflow control device shall be factory characterized to the job specific airflows as detailed on the plans and specifications using NIST accredited air stations and instrumentation having a combined accuracy of no more than  $\pm 1\%$  of signal (5,000 to 250cfm),  $\pm 2\%$  of signal (249 to 100cfm) and  $\pm 3\%$  of signal (199 to 35cfm). Electronic airflow control devices shall be further characterized and their accuracy verified to  $\pm 5\%$  of signal at a minimum of 48 different airflows across the full operating range of the device.
  - b. Each airflow control device shall be marked with device-specific factory characterization data. At a minimum, it should include the room number, tag number, serial number, model number, eight-point characterization information (for electronic devices), date of manufacture and quality control inspection numbers. All information shall be stored by the manufacturer for use with as-built documentation. Characterization data shall be stored indefinitely by the manufacturer and backed up off site for catastrophic event recovery.
- 11. Airflow control devices that are not venturi valves and are airflow measuring devices (e.g., pitot tube, flow cross, air bar, orifice ring, vortex shedder, etc.) shall only be

acceptable, provided these meet all the performance and construction characteristics as stated throughout this specification and:

- a. The airflow control device employs transducers manufactured by Rosemount, Bailey, Bristol, or Foxboro. Accuracy shall be no less than  $\pm 0.15\%$  of span (to equal  $\pm 5\%$  of signal with a 15 to 1 turndown) over the appropriate full-scale range, including the combined effects of nonlinearity, hysteresis, repeatability, drift over a one-year period, and temperature effect. 316L stainless steel materials shall be provided for all exhaust applications. The use of 304 stainless steel or aluminum materials shall be provided for all supply air applications.
- b. Airflow sensors shall be of a multi-point averaging type, 304 stainless steel for all supply and general exhaust applications, 316L stainless steel for all fume hood, canopy, snorkel, and biosafety cabinet applications. Single point sensors are not acceptable.
- c. Suppliers of airflow control devices or airflow measuring devices requiring minimum duct diameters shall provide revised duct layouts showing the required straight duct runs upstream and downstream of these devices. Coordination drawings reflecting these changes shall be submitted by the supplier of the LACS. In addition, suppliers shall include static pressure loss calculations as part of their submittals. All costs to modify the ductwork, increase fan sizes and horsepower and all associated electrical changes shall be borne by the control system supplier.

## C. EXHAUST AND SUPPLY AIRFLOW DEVICE CONTROLLER

- 1. One controller shall be provided for both the supply airflow control device and the corresponding exhaust airflow control device. The controller shall be a microprocessor-based design and use closed-loop control to linearly regulate airflow based on a digital control signal. The device shall generate a digital feedback signal that represents its airflow.
- 2. In flow tracking applications where an exhaust device and or a return device is tracking a supply device, flow data for each device (up to 3 valves total) shall be downloaded to the controller in the factory.
- 3. The airflow control device shall store its control algorithms in non-volatile, rewritable memory. The device shall be able to stand alone or to be networked with other room-level digital airflow control devices through an industry standard protocol.
- 4. Room-level flow tracking control functions shall be embedded in and executed by one controller mounted on one of the airflow devices.
- 5. The room-level control network shall communicate by using BACnet® MS/TP protocol. The control device must meet the requirements of a BACnet Application Specific Controller (B-ASC Level Device), and be a BACnet Testing Laboratories (BTL) certified device.
- 6. The airflow control device shall use industry standard 24 VAC power.
- 7. The airflow control device shall have provisions to connect a notebook PC commissioning tool and every node on the network shall be accessible from any point in the system.
- 8. The airflow control device shall include inputs with 10-bit resolution that accept 10K thermistors, 0-10 VDC, 0-5 VDC, 0-20 mA and dry contact signals. Controller shall include binary and analog outputs on board. Analog outputs shall be 5 VDC, 0-10 VDC, 2-10 VDC, or 0-20mA. Software shall include scaling features for analog outputs. Controller shall include a 24 Vdc voltage supply for use as power supply to external sensors.

- 9. Controller shall also include support for interface with digital display which allows display and modification of controller set point variables.
- D. Temperature Controller
  - 1. For zones with constant volume (CV) venturi valves that require hydronic reheat control, provide a low-voltage and microprocessor-based zoning thermostat-controller capable of (Select: three point floating or 0-10Vdc analog control). The thermostat-controller shall operate in a stand-alone mode and be capable of BACnet MSTP communications.
    - a. Thermostat-controller shall be pre-programmed, containing all required I/O to accomplish local HVAC temperature control for heating with reheat.
    - b. Thermostat-controller shall be provided with two (2) floating or two (2) analog proportional-integral control outputs. Thermostat-controller shall have integrated changeover function, which will allow seamless switching between cooling and heating mode based upon temperature or a network value input.
    - c. Thermostat-controller shall achieve accurate temperature control using a PI proportional-integral algorithm. Differential-based thermostat-controllers are not acceptable. Thermostat-controller shall have an adjustable deadband.
    - d. Thermostat-controller shall have an on-board 10K NTC thermistor and the capability for a remote temperature sensor that will replace the on-board temperature sensor.
    - e. Thermostat-controller shall be capable of local or remote override during unoccupied mode. The thermostat-controller shall resume occupied setpoints and will revert back to unoccupied setpoints after a set time adjustable from 0 to 24 hours. Thermostat-controller shall also have configurable temporary or permanent local override setpoints. When the "temporary setpoints" mode is enabled, once the temporary occupancy timer expires, the setpoints will revert back to their default values. Thermostat-controller shall have adjustable local unoccupied heating and cooling setpoint limits as well as maximum heating and minimum cooling limits.
    - f. Thermostat-controller shall also provide; (2) additional configurable inputs for remote night setback, occupancy sensing, door contact, remote override, or filter alarm as required. (1) additional configurable input for dry contact or analog sensor changeover, or for other temperature sensor monitoring as required. (1) configurable auxiliary output to be used for heating or local digital output.
    - g. Thermostat-controller shall be equipped with 2-line, 16-character LCD dual intensity backlit display with two status LEDs for heating or cooling mode, and be capable of displaying temperatures in Celsius or Fahrenheit.
    - h. Thermostat-controller shall utilize EEPROM memory to back up local configuration parameters in the event of power failure. Thermostat-controllers requiring batteries, or have no provisions for retention during loss of power shall not be acceptable.
    - i. Thermostat-controller shall have (4) adjustable keypad lockout levels limiting access to changes of occupied and unoccupied setpoints.
- E. OPERATION SEQUENCES
  - 1. Room Volumetric Offset Control
    - a. The airflow control system shall control supply and exhaust airflow devices in order to maintain a volumetric offset (either positive or negative). Offset shall be maintained regardless of any change in flow or static pressure. The offset

represents the air volume that enters or exits the room from the corridor or adjacent spaces.

- b. The airflow control system shall maintain the fixed volumetric offset as the supply and exhaust venturi valves increase or decrease flow to meet temperature, occupancy, or ACH demands.
- c. The offset control algorithm shall sum the flow values of all supply and exhaust airflow devices and command appropriate controlled devices to new set points to maintain the desired offset. This offset shall be adjustable from the BMS or locally through commissioning software installed on a laptop computer.
- d. The offset control algorithm shall consider non-networked airflow control devices that consist of supply and exhaust flow devices that provide an analog signal scaled to reflect actual flow and any number of constant volume devices where the total of the supply and exhaust devices or may be included in the offset control algorithm.
- 2. Space Temperature Control
  - a. The airflow control system shall regulate the space temperature through a simultaneous combination of programmable volumetric thermal override and control of reheat coils and/or staged or simultaneous auxiliary temperature control devices. The controller shall calculate separate cooling and heating set points based on a single writable set point from the BMS, with the option of a local set point offset adjustment.
  - b. Temperature control shall be implemented through the use of independent primary cooling and heating control functions, as well as an auxiliary temperature control function, which may be used for either supplemental cooling or heating. Cooling shall be provided as a function of thermal override of conditioned air with the supply and exhaust airflow devices responding simultaneously to maintain the desired offset. Heating shall be provided through either modulating or floating point control actuator of a properly sized control valve connected to the selected reheat coil.
- 3. Occupancy Override Control
  - a. The airflow control system shall have the ability to change the minimum ventilation and/or temperature control set points, based on the occupied state, to reduce energy consumption when the space is not occupied. Two occupancy modes shall be available: occupied and unoccupied. The occupancy state may be set by either the BMS as a scheduled event or a local override button that allows a user to set the space to occupied for a predetermined interval. The local timed bypass button (located on the wall mounted temp sensor) or the override contact shall be given priority over the BMS command.
- 4. Emergency Mode Control (Alternate Flow Control)
  - a. The airflow control system shall provide a means in conjunction with a BMS supervisory controller of overriding temperature and pressurization control in response to a command indicating an emergency condition exists, and airflow control devices are to be driven to a specific flow set point. The system shall support up to four emergency control modes. The emergency control modes may be initiated either by a local contact input or BMS command. Once an emergency mode is invoked, pressurization (offset) and temperature control are overridden for the period that the mode is active. Emergency modes shall have a priority scheme allowing a more critical mode to override a previously set condition.
- 5. Humidity Control

- a. The airflow control system shall have an optional embedded humidity control function, which allows the monitoring and control of the relative humidity level in the pressurized zone. The airflow devices shall have the ability to monitor the relative humidity level of the space and, based on a BMS writeable set point, develop a control signal to drive a humidification control circuit.
- 6. Shut-off Control
  - a. The air flow control venturi valves shown on the drawings and schedules as type SOV shall be capable of shut off function. Each device shall be capable of accepting a digital input to switch the air valves from the set point flow to shut-off position using either Pandemic or Emergency modes. These valves shall also be capable of network operation and being commanded to shut-off position from the BMS. Feedback shall be available to indicate flow and shut-off.
- 7. 3-State Control
  - a. The airflow control system shall provide a means of controlling a 2 or 3-state local exhaust device (e.g. hood, canopy, snorkel). 2-state control can be set for either min flow (unoccupied) and max flow (occupied), or off and max flow (normal).
    3-state control can be off, min (unoccupied) and max (normal) flow.
- 8. LED Control / Alarming
  - a. The airflow control system shall provide LED notification for 2 or 3-state hoods, 2-state snorkels or capture hoods (LED provided by others). Alternatively, when not used for LED notification, the LED control can be used for room-level alarm indication for spaces such as Operating Rooms (alarm provided by others).
- 9. Indoor Air Quality (IAQ) Control
  - a. The airflow control system shall provide a means of dynamically controlling the air change per hour (ACH) rate to the space, based on the input from an air quality signal (i.e. monitoring system or a maximum of two local sensors). A minimum and maximum ACH shall be programmed into the controller and the airflow control system shall linearly ramp within these values in response to the air quality signal. Proper offset and directional airflow will be maintained at all times.
- 10. Pandemic Mode Control
  - a. The airflow control system shall provide a means of receiving a local or network command to switch to 100% outside exhaust by closing the return air valve and opening the exhaust air valve, change the pressurization (i.e. volumetric offset) of the space from neutral to negative or positive and increase the ACH set point.
- 11. BACnet Multi-Use Inputs
  - a. In addition to the dedicated inputs for standard control functions, each BACnet venturi valve controller shall provide multi-use inputs for the following local monitoring or control functions (per the capabilities and limitations shown in Section 2.05.A):
    - 1) Discharge Air Sensor
    - 2) Volumetric Cooling Override
    - 3) Occupancy Sensor
    - 4) Humidity Sensor
    - 5) Pressure Monitoring
    - 6) IAQ Sensor
    - 7) Pandemic Switch
    - 8) Emergency Switch
    - 9) Additional Flow Inputs (Supply and Exhaust)
    - 10) Local Offset Selection Switch

## F. BACnet INTERFACE TO BUILDING MANAGEMENT SYSTEMS

1. The airflow control system network shall interface digitally with the BMS via BACnet MS/TP. All room-level points shall be available to the BMS for monitoring or trending. At a minimum, the airflow controller shall be BACnet Testing Lab (BTL) certified as an Application Specific Controller (B-ASC).

## PART 3 EXECUTION

#### 3.01 INSTALLATION

- A. Install in accordance with manufacturer's instructions.
- B. Support units individually from structure. Do not support from adjacent ductwork.
- C. Connect to ductwork in accordance with Section 15810.

#### 3.02 ELECTRONIC AIRFLOW CONTROL VALVES

- A. Installation
  - 1. The BMS contractor shall install any required routers and repeaters or supervisory controllers in an accessible location in or around the designated critical or non critical room.
  - 2. The BMS shall install an appropriately sized and fused 24 Vac transformer suitable for NEC Class II wiring.
  - 3. The BMS contractor shall provide all required reheat coil and radiation control valves. Actuators shall be proportional or floating point control.
  - 4. All cable and conduit shall be furnished and installed by the BMS contractor. The BMS contractor shall terminate and connect all cables as required. The BMS shall utilize cables specifically recommended by the airflow controls supplier.
  - 5. The mechanical contractor shall install all airflow control devices in the ductwork and connect all airflow control valve linkages.
  - 6. The mechanical contractor shall install any sound attenuating devices provided by the airflow controls supplier.
  - 7. The mechanical contractor shall provide and install all reheat coils and duct transitions.
  - 8. The mechanical contractor shall install all reheat and radiation control valves.
  - 9. The mechanical contractor shall provide and install insulation as required.
  - 10. Each pressurization zone shall have either a dedicated, single-phase primary circuit or a secondary circuit disconnect.
- B. System Start-up and Training
  - 1. System start-up shall be provided by a factory-authorized representative of the airflow control system manufacturer. Start-up shall also provide electronic verification of airflow, supply, make-up, general exhaust, system programming and integration to BMS (when applicable).
  - 2. The balancing contractor shall be responsible for final verification and reporting of all airflows.
  - 3. The airflow control system supplier shall furnish a minimum of eight hours of owner training by factory trained and certified personnel. The training will provide an overview of the job specific airflow control components, verification of initial fume hood monitor calibration, general procedures for verifying airflows of air valves and general troubleshooting procedures.
  - 4. Operation and maintenance manuals, including as-built wiring diagrams and

component lists, shall be provided for each training attendee.


#### C. CLOSEOUT ACTIVITIES


- 1. Training
  - a. The ACS supplier shall furnish a minimum of eight hours of owner training by factory trained and certified personnel. The training will provide an overview of the job specific airflow control components, general procedures for verifying airflows of air valves and general troubleshooting procedures.
  - b. Operation and maintenance manuals, including as-built wiring diagrams and component lists, shall be provided for each training attendee.

## 2. Maintenance

- a. The airflow control valve utilizing flow metering and volumetric offset shall require no scheduled maintenance.
- b. Systems using airflow management sensors/transducers (e.g., pitot tube, flow cross, orifice ring, air bar, hot wire, vortex shedder, side wall sensors, etc.) shall provide at no additional cost to the owner during and after the warranty period five years of required preventive maintenance on all airflow sensors.
  - 1) Airflow sensors shall be removed, inspected, and cleaned semi annually during the five-year period to prevent inaccuracies due to long-term buildup of dust, lint corrosion, wet or sticky particles, or other materials that foul the sensors.
  - 2) If impractical to remove the airflow sensors, the critical airflow control system supplier shall include in the proposal the cost of supplying and installing duct access doors, one for each sensor, so that they may be cleaned in place.
  - 3) The transducer shall be checked and recalibrated every 6 months to ensure long-term accuracy.
  - 4) Note that auto-zero recalibration of transducers is not acceptable as a substitute for semi-annual recalibration.

## **END OF SECTION**

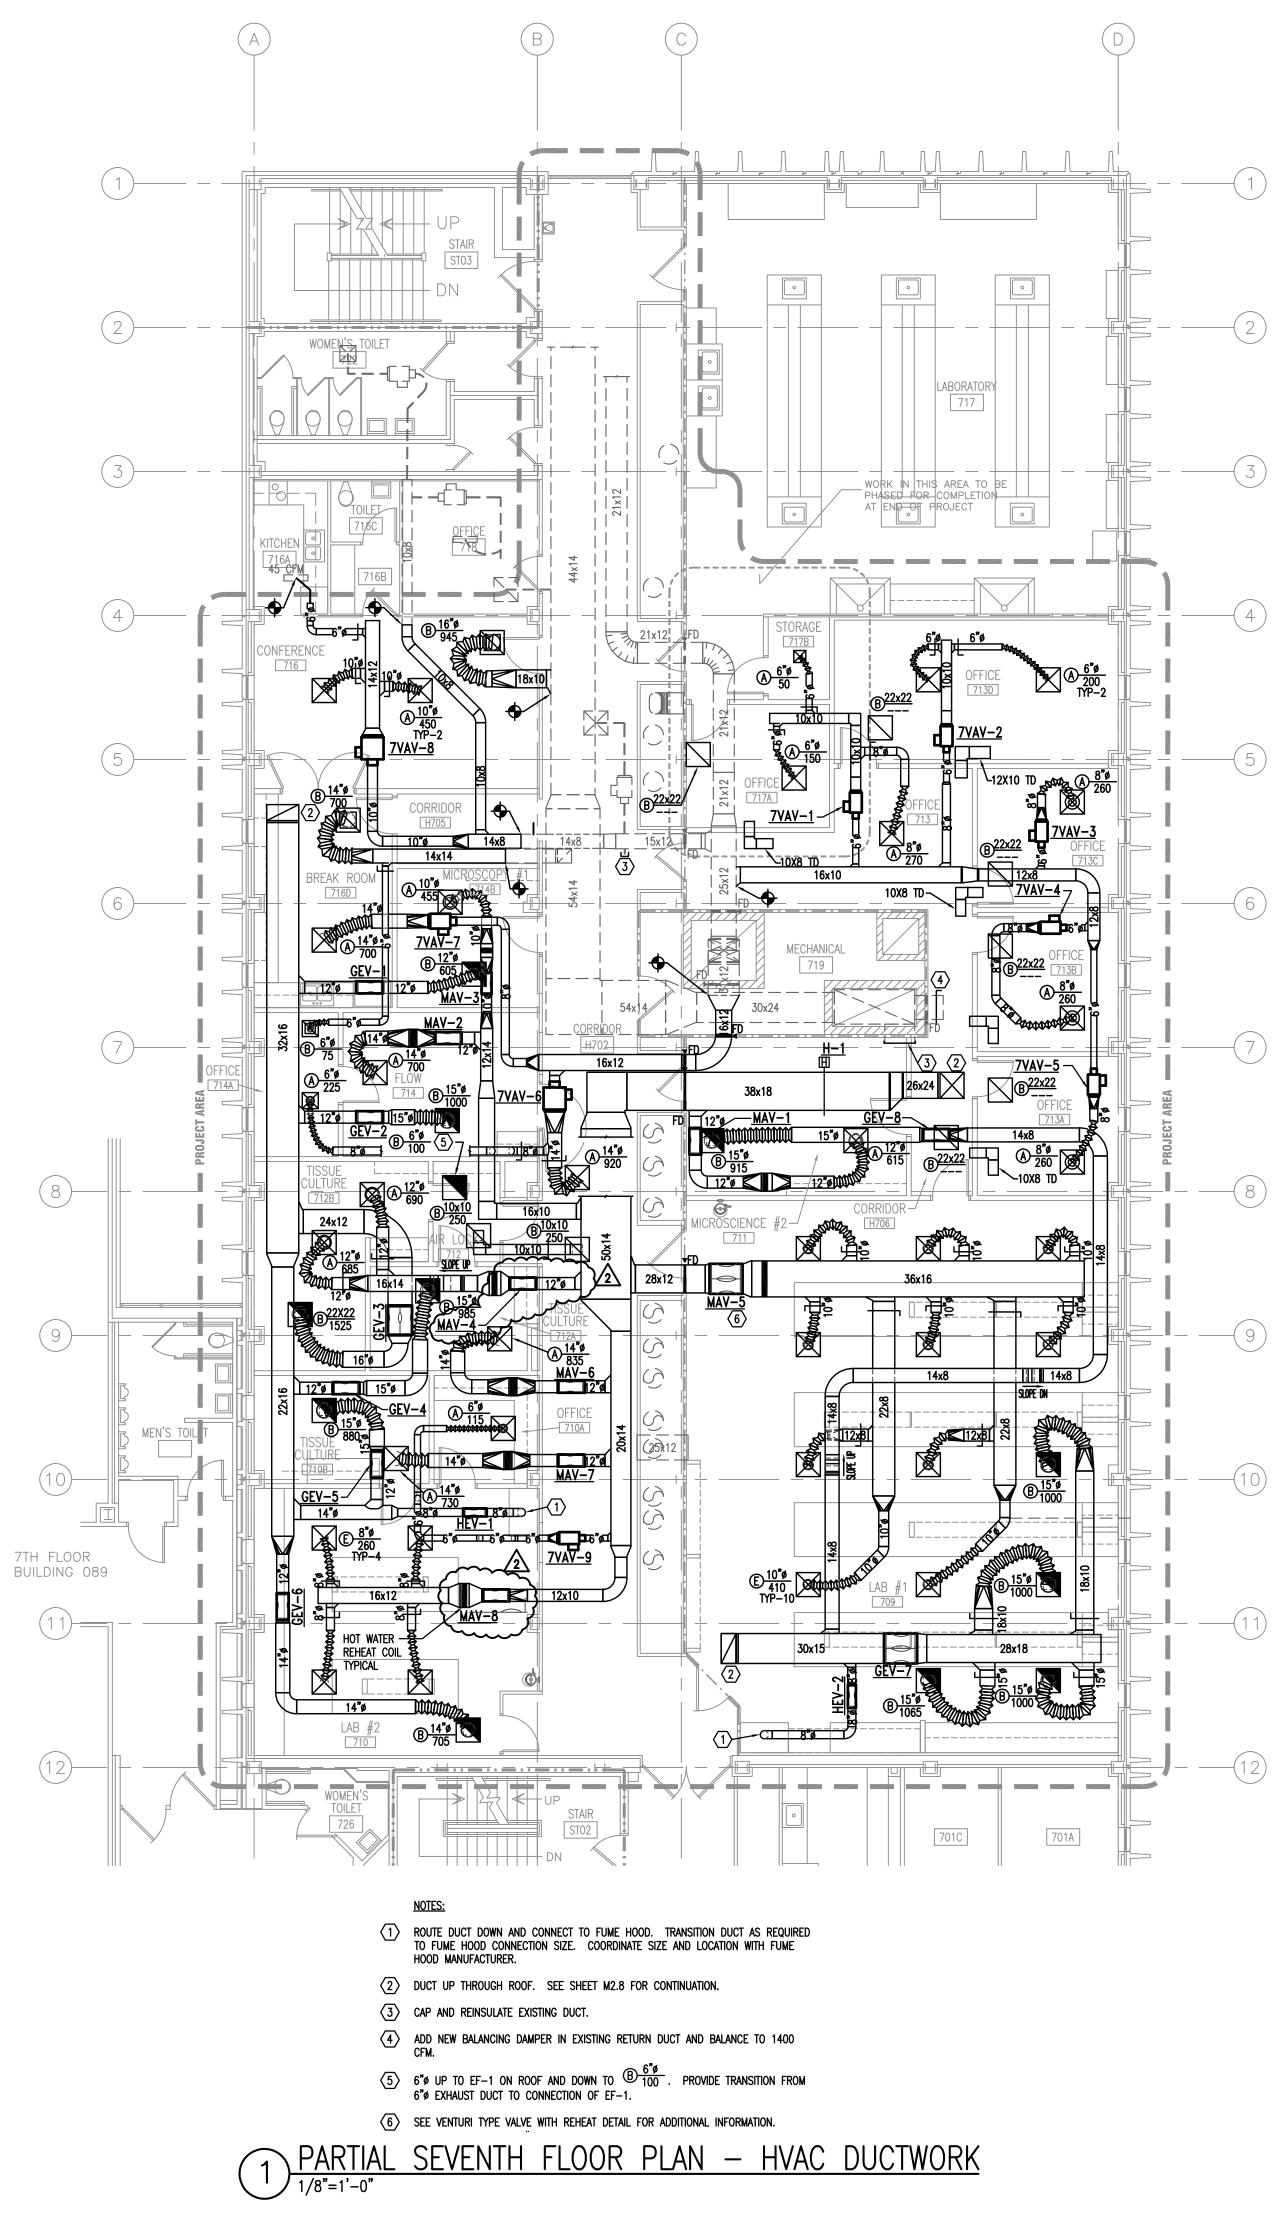


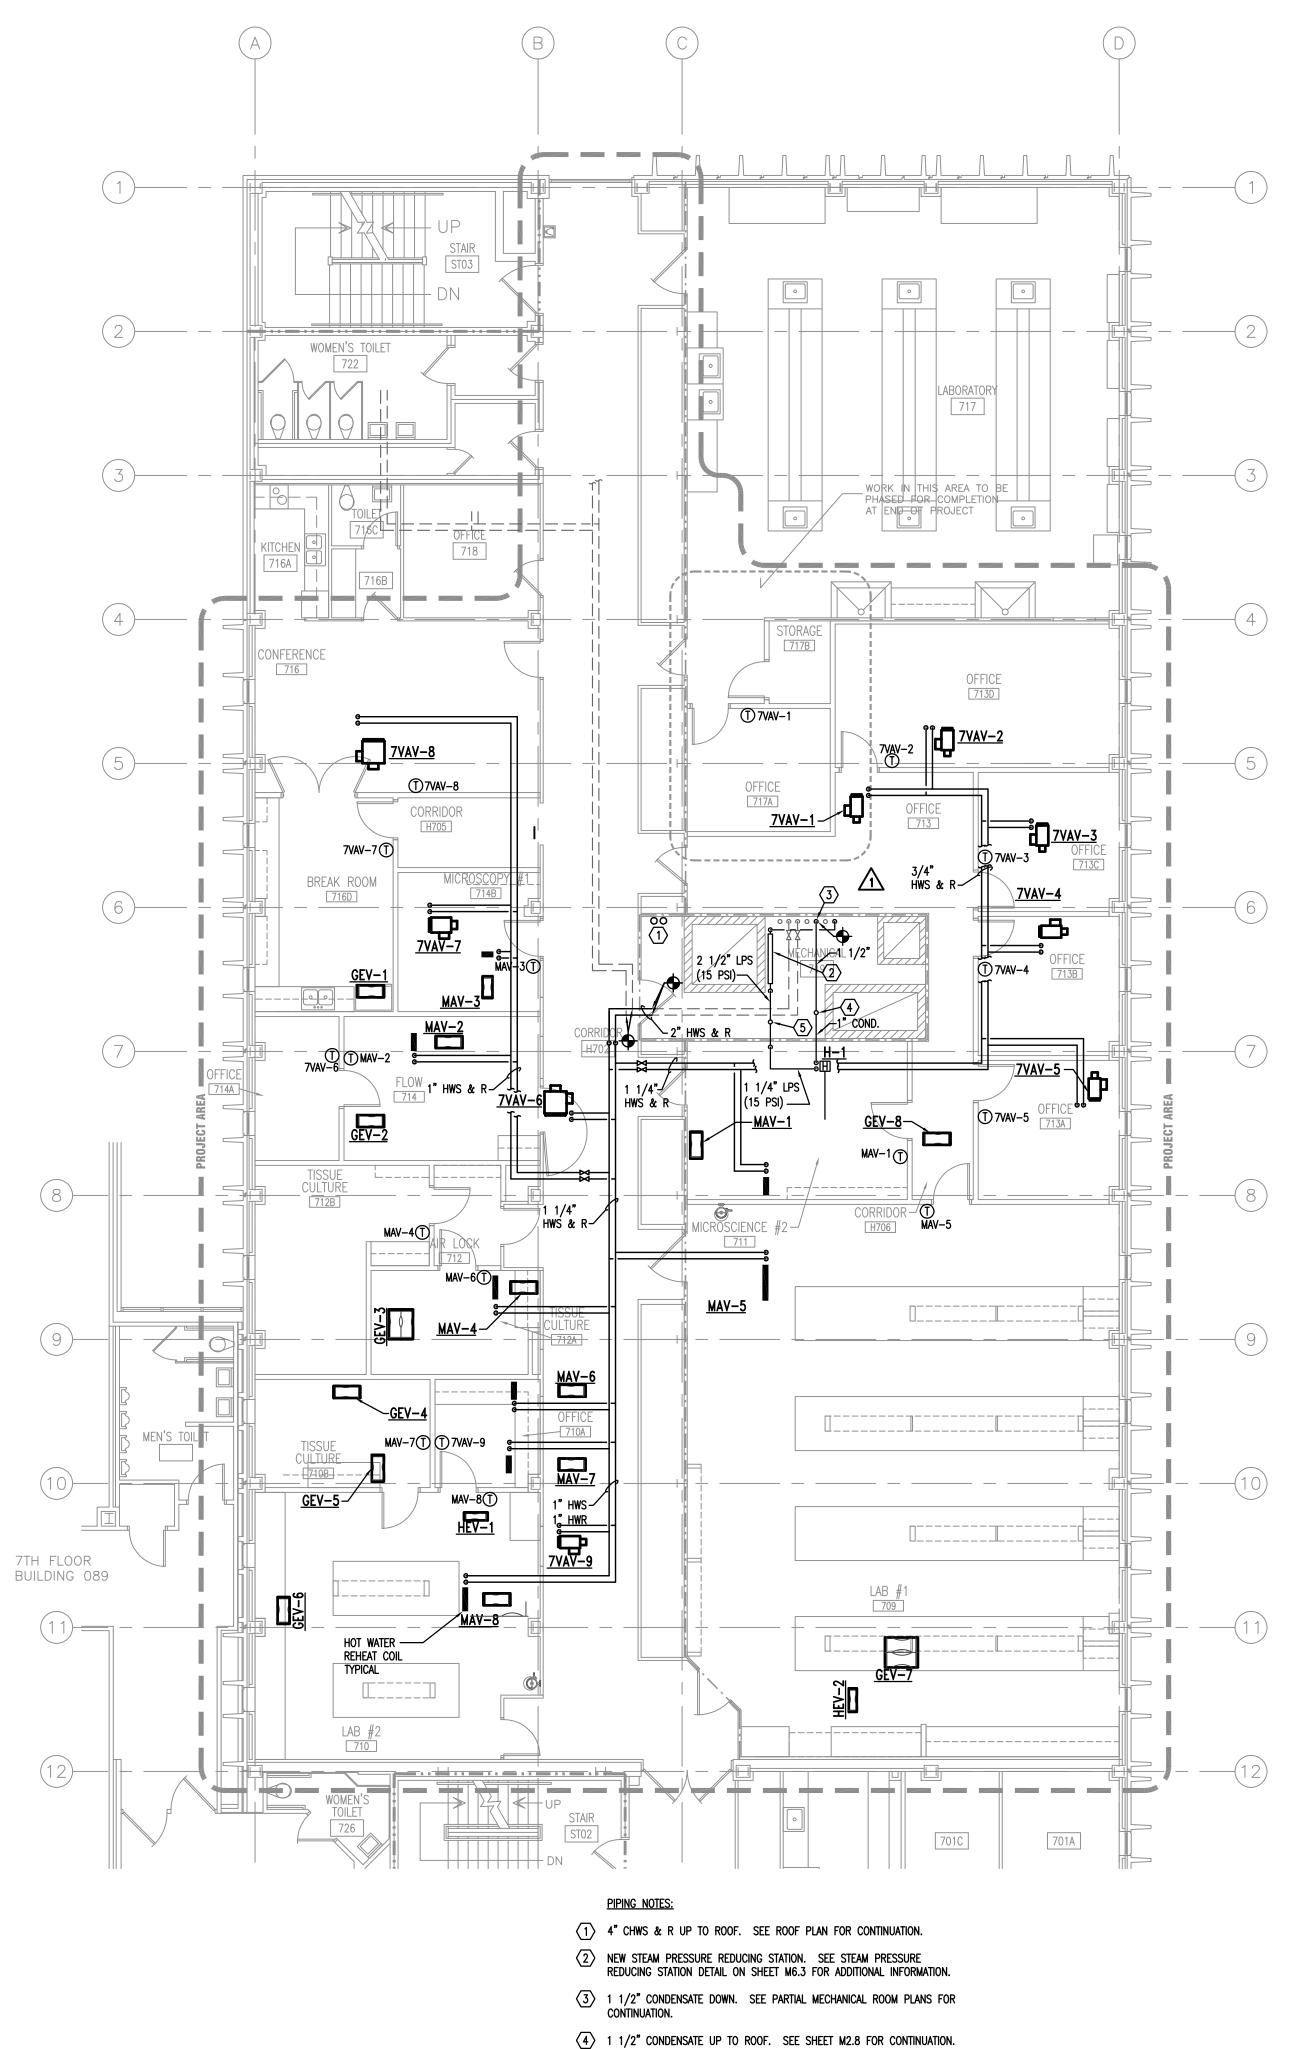

 $\overline{5}$  2" LPS (15 PSI) UP TO ROOF. SEE SHEET M2.8 FOR CONTINUATION.

2 PARTIAL SEVENTH FLOOR PLAN — HVAC PIPING

GMK ASSOCIATES, INC. Design/Planning/Construction
1201 Main Street, Suite 2100 Columbia, S.C. 29201 tel. 803-256-0000 fax 803-255-7243 ALL RIGHTS RESERVED. THIS DRAWING AND THE DESIGN SHOWN THEREON ARE COPYRIGHTED AS PRESCRIBED BY THE LAWS OF THE UNITED STATES AND ARE THE PROPERTY OF GMK ASSOCIATES ARCHITECTURAL DIVISION. ANYONE DUPLICATING, REPRODUCING OR CAUSING TO BE REPRODUCED THE WHOLE OR PART OF THESE DRAWINGS OR THE DESIGN THEREON WITHOUT PERMISSION OF THE ARCHITECT WILL BE SUBJECT TO LEGAL ACTION. consultants owner project name COKER - 7th FLOOR PHARMACY RENOVATION State project number H27- 6101 project number 12023.01 seals/signature issued for CONSTRUCTION APRIL 23, 2013 <u>number</u> date 05/28/13 ADDENDUM NO. 2 07/25/13 VALUE ENGINEERING -----\_\_\_\_\_ \_\_\_\_\_ \_\_\_\_\_ \_\_\_\_\_ \_\_\_\_\_ ------\_\_\_\_\_ key plan COKER  $\square$ sheet title PARTIAL SEVENTH FLOOR PLAN HVAC DUCTWORK AND PIPING sheet number M2.7 drawn by JDR checked by JDR

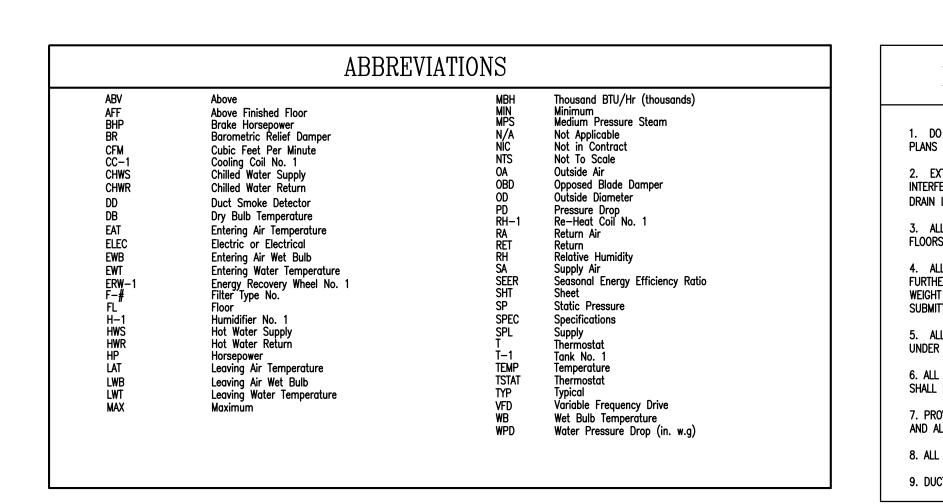

	ME
1.	drawin and e not ni verify
2.	demol Suppo And A
3.	When Shown Not Ri Or Br Practi Finishe
4.	remov. If not Below

									1		_
	AI	R DIS	STRIBU	UTION	SCHED	ULE					
TAG	DESCRIPTION	NECK	MODULE SIZE	MOUNT	CONSTR.	MFGR	MODEL	NOTES		TAG	
A	SQUARE PLAQUE CEILING SUPPLY	AS SHOWN	24x24	LAY-IN	ALUMINUM	PRICE	SERIES ASPD	2,3	1		I
В	PERFORATED CEILING RETURN/EXHAUST	AS SHOWN	24x24	LAY-IN	ALUMINUM	PRICE	SERIES APDDR	3	1	LEF-1	
C	SQUARE PLAQUE CEILING SUPPLY	AS SHOWN	16x16	SURFACE	ALUMINUM	PRICE	SERIES ASPD	2,3	]	LEF-2	
D	PERFORATED CEILING RETURN/EXHAUST	AS SHOWN	16x16/1	SURFACE	ALUMINUM	PRICE	series apddr 🏠	3	₩.	EF-1	
E	LABORATORY SUPPLY DIFFUSER	AS SHOWN	24x24	LAY-IN	ALUMINUM	PRICE	SERIES AFRFD	3,4	F)	1. MOTORIZED BA	ACKI
									]	2. GRAVITY BACK	DRA
	IRNISH WITH OPPOSED BLADE DAMPER 1		ENAMEL OF	F-WHITE FINIS Tern	SH 5. FUR	NISH WITH 2	SETS OF REPLACEMENT FILTI	ERS		3. DISCONNECT S 4. BIRDSCREEN	>WII

													ROOFTOP	UNIT S	CHEDUL	£													I	FILTER SC	CHEDULE					
TAG	SERVICE	CAPACITY CFM	MINIMUM O.A.	Fan Type	STATIC PR IN. W.G TOTAL		FAN PM BI	IP RP	MOTOR PM HP	LAT Unit (	r elec (°F) volts	CTRICAL S/PHASE	EMERGENCY POWER	AIR VOLUME CONTROL	PREHEAT COIL EQ. NO.	HEATING COIL EQ. NO.	COOLING COIL EQ. NO.	PRE-FILTER (%)	FINAL FILTER	Humidifier Eq. No.	MANUFACTURER	MODEL	REMARKS	TAG	SYSTEM	type Media	CAPACITY (CFM)	Filter Depth (Inches)	Maximum Air Velocity (FPM)	INITIAL PRESS. DROP (IN. WG.)	FINAL PRESS. DROP (IN. WG.)	EFFICIENCY PERCENT	MERV Rating	MANUFACTURER	MODEL	NOTES
RTU-1	SUPPLY	11000	11000	AIRFOIL	7.58	3.5 20	)17 20.	21 180	00 25	55.0	) 48	80/3	YES	VFD	HC-1		CC-1	30	F-1A & F-1B		TRANE	PERFORMANCE CLIMATE CHANGER-25	1,2	F-1A	RTU-1	PRE-FILTER	11000	4"	500	0.31	1.0	30	8	FARR	30/30	1
																								F-1B	RTU-1	FINAL FILTER	11000	12"	500	0.6	1.5	95	14	FARR	RIGA-FLO	1
1. FACTORY 2. SINGLE F	Mounted VFD Point Power Connect	ΓΙΟΝ							·															1. TEST MET	THOD: ASHRAE 52.1	-92 standard										

									VALVE S						$\longrightarrow$	2\		
NG NO.	MAXIMUM	MINIMUM	MIN. INLET	PIPE RUNOUT			REF	HEAT COIL				PRIMARY NC @ 1.5" SP	INLET SIZE	ELECTRICAL	TRACKING	MANUFACTURER	MODEL NO.	NOTE
6 NO.	BOX CFM	BOX CFM	S.P. (W.C.)	SIZE (INCHES)	GPM	MBH	EWT ("F)	LWT ('F)	MAX. AIR VEL.	MAX COIL HT.	MAX. WPD	DISCH/RAD.	(INCHES)	(VOLTS/PHASE)	<pre>VALVE </pre>	MANUFACTURER		
AV-1	615	300	1.25	3/4"	1.2	11.7	160	140	900	12"	5		12	120/1	<b>CEV-8</b>	PHOENIX CONTROLS	HSVAF10M-ALAHZ	1,2,3,4
V-2	700	300	1.25	3/4"	1.2	11.7	160	140	900	12"	5		▲ <sup>12</sup>	120/1	6EV-2	PHOENIX CONTROLS	SHSVAF12M-ALAHZ	1,2,3,4
/-3	455	150	1.25	3/4"	0.6	5.9	160	140	900	10"	5		2 10	120/1	GEV-1 5	PHOENIX CONTROLS	KSVAF10M-ALAHZ	1,2,3,4
V-4	1375	195	1.25	3/4"	0.8	7.6	160	140	900	12"	5			120/1	GEV-3	PHOENIX CONTROLS	HSVAF12M-ALAHZ	1,2,3,4
/-5	4100	1495	1.25	1"	5.8	58.4	160	140	900	14"	5		28X14	120/1	<b>6 EV</b> -7	PHOENIX CONTROLS	HSVA214M-ALAHZ	1,2,3,4
/-6	835	150	1.25	3/4"	0.6	5.9	160	140	900	12"	5		12	120/1	6EV-4	PHOENIX CONTROLS	SVAF12M-ALAHZ	1,2,3,4
1–7	730	150	1.25	3/4"	0.6	5.9	160	140	900	12"	5		12	120/1	GEV-5	PHOENIX CONTROLS	KSVAF12M-ALAHZ	1,2,3,4
V-8	1040	480	1.25	3/4"	1.9	18.7	160	140	900	12"	5		12	120/1	GEV-6	PHOENIX CONTROLS	HSVAF12M-ALAHZ	1,2,3,4
																	h	<del>m</del>

1. LOW SPEED ELECTRIC ACTUATOR 4. FLANGED CONNECTION 1 3. REHEAT COIL MOUNTED IN DUCT

					VARI	ABLE	AIR Y	VOLUN	IE TE	RMINA	AL BOX SC	HEDULE									H00	D EXHAUS'	Γ VALVE	SCHEDULE			
TAG NO.	area served	MAXIMUM BOX CFM	MINIMUM BOX CFM	MIN. INLET S.P. (W.C.)	PIPE RUNOUT SIZE (INCHES)	GPM	_	REHEAT COIL EWT (*F)	LWT (°F)	MAX. WPD	PRIMARY NC @ 1.5" SP DISCH/RAD.	INLET SIZE (INCHES)	ELECTRICAL (VOLTS/PHASE)	MANUFACTURER	MODEL NO.	NOTE	TAG NO.	AREA SERVED	MAXIMUM BOX CFM	MINIMUM BOX CFM	MIN. INLET S.P. (W.C.)	PRIMARY NC @ 1.5" SP DISCH/RAD.	INLET SIZE (INCHES)	ELECTRICAL (VOLTS/PHASE)	MANUFACTURER	MODEL NO.	NOTE
7VAV-1		470	140	1.0	3/4"	0.8	7.7	160	140	5		6	120/1	TRANE	VCWF-06	1,2	HEV-1		485	485	1.25		8	120/1	PHOENIX CONTROLS	CEVBF08M-ACNHZ	3,4,6,7
7VAV-2		400	120	1.0	3/4"	0.7	7.3	160	140	5		6	120/1	TRANE	VCWF-06	1,2	HEV-2		485	485	1.25		8	120/1	PHOENIX CONTROLS	CEVBF08M-ACNHZ	3,4,6,7
7VAV-3		260	80	1.0	3/4"	0.5	5.0	160	140	5		6	120/1	TRANE	VCWF-06	1,2											
7VAV-4		260	80	1.0	3/4"	0.5	5.0	160	140	5		6	120/1	TRANE	VCWF-06	1,2			-								
7VAV-5		260	80	1.0	3/4"	0.5	5.0	160	140	5		6	120/1	TRANE	VCWF-06	1,2	1. HIGH SPEE 2. LOW SPEE	D ELECTRIC ACTUATO D ELECTRIC ACTUATOR	R R		ION-RESISTANT COATING		7. FLANGED C	ONNECTION 1			
7VAV-6		1145	1145	1.0	1"	4.4	44.1	160	140	5		10	120/1	TRANE	VCWF-10	1,2		POWER TRANSFORMER				FOR MORE INFORMATION					
7VAV-7		700	210	1.0	3/4"	1.0	10.4	160	140	5		8	120/1	TRANE	VCWF-08	1,2											
7VAV-8		900	450	1.0	3/4"	1.8	18.5	160	140	5		8	120/1	TRANE	VCWF-08	1,2											
7VAV-9		115	115	1.0	3/4"	1.8	18.5	160	140	5		6	120/1	TRANE	VCWF-06	1,2											

1. ELECTRIC ACTUATOR 2. CONTROL POWER TRANSFORMER 3. SOUND ATTENUATOR

										C0]	IL SC	HEDU	ΓE																	PU	MP SCHEDULE				
TAG	LOCATION	SERVICE	CAPACIT CFM	MAX. AIR VELOCITY (FPM)	MIN. FAC AREA (SQ. FT.)	AIR PRES DROP (IN. WG.)	s Total Mbh	CAPACIT L SENS I MBH	т <u>ү</u> 5. кw	DB	AIR ENTERING	TEMPERATU F DB	RE LEAVING 'F WB 'F	CAPACITY (LBS/HR)	TEAM PRESS. (PSIG)	Entering Temp. *F	WATER LEAVING TEMP. *F	GPM PRESS DROP (FT. WATER)	MINIMUM NO. OF ROWS	Maximum No. Of FINS/FT.	ELECTRICAL (VOLTS/PHASE)	NOTES	TAG	SERVICE	TYPE	FLOW (CPM)	HEAD	EFFICIENC)	/	MOTOR	ELECTRICAL (VOLTS/PHASE)	EMERGENCY POWER	MANUFACTURER	MODEL	NOTES
CC-1	rtu-1	COOLING	11000	500	23.73	1.251	1057.3	33 516.23	3	- 95	5.0 80.0	) 53.	.0 52.9			48.0	60.0	175.7 20	8	163			P-1B	SECONDARY CHILLED WATER	INLINE	200	56	59.5	HP 7.5	RPM TYI 1750 OD		NO	BELL AND GOSSETT	SERIES 80 2-1/2 X 9-1/2B	1,2
HC-1	rtu-1	HEATING	11000	500	22.67	0.069	473.7	7		- 20	0.0	- 59.	7	500.7	15			0.1	1	42			1. INVERTER I												
/INIMUM WATI 2—way valve	r velocity – 3 fe	et per second		3. 3—WAY 4. MINIMUN		– 4 feet per s	SECOND																2. VARIBABLE	FREQUENCY DRIVE											

## MECHANICAL GENERAL NOTES

1. DO NOT SCALE DRAWINGS; SEE ARCHITECTURAL DRAWINGS AND REFLECTED CEILING PLANS FOR EXACT LOCATIONS OF DOORS, WINDOWS, CEILING, DIFFUSERS, ETC. 2. EXTEND ALL DRAIN LINES TO EXTERIOR AND SPILL ON GRADE, ROUTE TO AVOID INTERFERENCE WITH PASSAGEWAYS. CONDENSATE DRAINS SHALL BE TRAPPED. SLOPE Drain lines 1/8" per foot.

3. ALL PIPING AND DUCTWORK INSULATION SHALL BE RUN CONTINUOUSLY THROUGH FLOORS, ROOFS AND PARTITIONS EXCEPT WHERE PROHIBITED BY FIRE CODES. 4. ALL PIPING SHALL BE SUPPORTED IN ACCORDANCE WITH THE SPECIFICATIONS AND FURTHER SUPPORTS OR HANGERS SHALL BE ADJACENT TO ELBOWS, TO PREVENT WEIGHT OF PIPING BEING PLACED ON THE EQUIPMENT. SUPPORT DETAILS SHALL BE SUBMITTED TO THE MECHANICAL ENGINEER.

5. ALL PIPING AND DUCTWORK LOCATIONS SHALL BE COORDINATED WITH THE WORK UNDER OTHER DIVISIONS OF THE SPECIFICATIONS TO AVOID INTERFERENCE. 6. ALL PIPING, DUCTS, VENTS, ETC. EXTENDING THRU EXTERIOR WALLS AND ROOFS

SHALL BE FLASHED AND COUNTERFLASHED. 7. PROVIDE ALL TRANSITIONS REQUIRED FOR INSTALLATION OF DUCT, EXHAUST FANS, AND ALL OTHER EQUIPMENT AND APPURTENANCES.

8. ALL DUCT IS GALVANIZED SHEET METAL EXCEPT AS NOTED.

9. DUCT SIZES ARE CLEAR INSIDE DIMENSIONS.

# CHANICAL DEMOLITION NOTES

AWINGS SHOW GENERAL INTENT OF DEMOLITION. QUANTITIES, LOCATIONS, SIZES D EQUIPMENT ARE SHOWN TO INDICATE TYPE OF SYSTEM INSTALLED AND DOES T NECESSARILY REPRESENT EXACT CONDITIONS. CONTRACTOR SHALL FIELD RIFY BEFORE BIDDING.

DLITION OF EQUIPMENT, SYSTEMS, AND COMPONENTS SHALL INCLUDE ALL PORTS, PADS, HANGERS, INSULATION, CONTROLS, STARTERS, ACCESSORIES, APPURTENANCES NOT REQUIRED FOR THE INSTALLATION OF THE NEW SYSTEM. N PARTIAL DEMOLITION OF A SYSTEM IS INDICATED, THE PART OF THE SYSTEM WN TO REMOVED SHALL BE REMOVED TO THE ACTIVE MAIN OR BRANCH IF REQUIRED FOR THE INSTALLATION OF THE NEW SYSTEM. THE ACTIVE MAIN BRANCH SHALL BE REPAIRED TO MATCH NEW INSTALLATION AS MUCH AS CTICAL. IF SYSTEM IS INSULATED, INSULATION SHALL BE PATCHED AND

HED REPAIR (IE: VAPOR BARRIER, COATING, ETC.) OVAL OF SYSTEMS SHALL INCLUDE COMPLETE SYSTEM WHENEVER PRACTICAL. OT, SYSTEM (IE: PIPE, CONDUIT, ETC.) SHALL BE REMOVED TO 1 INCH W SURFACE.

			HVAC LEGEND		
SYMBOL	DESCRIPTION	SYMBOL	DESCRIPTION	SYMBOL	DESCRIPTION
T	TEMPERATURE SENSOR OR THERMOSTAT		CEILING SUPPLY DIFFUSER, RETURN GRILLE W/ FLEX DUCT CONN. FOR RETURN OR EXHAUST AIR; SEE "DIFFUSER & GRILLE SCHEDULE"	12x12	TRANSITION, FLAT ON BOTTOM (FOB) FLAT ON TOP (FOT, IF APPLICABLE)
\$	WALL SWITCH		EXISTING DUCT WORK TO REMAIN		TURNING VANES
Ħ	WALL HUMIDISTAT	X//////X	EXISTING DUCT WORK TO BE REMOVED		DUCT SMOKE DETECTORS
•	CONNECT TO EXISTING		DUCT TURNING DOWN		CONCEALED REGULATOR
- 18x12 -	RECTANGULAR DUCT SIZE, FIRST FIGURE IS SIDE SHOWN		DUCT TURNING UP		MANUAL VOLUME DAMPER
<u> </u>	Round duct size		UNION	A <u>6"ø</u> 100	A – DIFFUSER TAG 6"ø – NECK SIZE 100 – CFM
	CHANGE OF ELEVATION, RISER (R), DROP (0)		STRAINER		GATE VALVE
<u>↓</u>	ACOUSTICAL LINING INSULATION		STRAINER WITH BLOW OFF		CONTROL VALVE, TWO WAY
	FLEXIBLE DUCT		ECCENTRIC REDUCER FLAT ON TOP		END CAP
CHWS	CHILLED WATER SUPPLY	-+0+	TEE OUTLET UP	(-+-)	ELBOW TURNED DOWN
CHWR	CHILLED WATER RETURN	+0+	TEE OUTLET DOWN	-+0	ELBOW TURNED UP
	CONCENTRIC REDUCER				ECCENTRIC REDUCER FLAT ON BOTTOM

						FAN SCHE	DULE			
TAG	TYPE	CAPACITY CFM	E.S.P. (IN. WG.)	MC HP	)TOR RPM	ELECTRICAL (VOLTS/PHASE)	EMERGENCY POWER	MANUFACTURER	MODEL NO.	NOTES
EF-1	VENT SET	6535	2.2	15	1725	460/3/60	NO	GREENHECK	VEKTOR-CD-15-1-III-MV	3,6,9,10,11,12,13
F-2	VENT SET	5465	2.2	15	1725	460/3/60	NO	GREENHECK	VEKTOR-CD-15-1-III-MV	3,6,9,10,11,12,13
F-1	DOWNBLAST	100	0.375	1/6	1725	115/1/60	NO	GREENHECK	G-060-VG	2,3,4,5,8
	Backdraft Damper Kdraft Damper Switch	5. Seismic RC 6. Belt guar 7. Filter 8. ECM Motoi	D	10. F 11. C	YPASS DAMI Plenum Chemical Re FD in Nema	PER SIST FLEX CONNECTION 3R ENCLOSURE	13. SPRING ISOLATORS			

TAG	LOCATION	TYPE	DUCT SIZE	CFM	CAPACITY (LBS/HR)	steam press. (PSIG)	MAXIMUM ABSORPTION DISTANCE	AIR PD (IN W.C.)	MANUFACTURER	MODEL	NOTES
H-1	RM 711	DUCT MOUNTED	38X18	11000	215	15	24"	0.051	DRI-STEEM	ULTRA-SORB LV	1,2,3,4,5,6,7
HI-LIMIT SEN DUCT MOUNT	ating control Isor Fed humidity sensor DN Emergency power	5. PRESSURE AIF 6. STEAM TRAP 7. ELECTRONIC A	FLOW PROVING SWITCH CTUATOR								

TAG NO.	AREA SERVED	MAXIMUM Box CFM	MINIMUM BOX CFM	MIN. INLET S.P. (W.C.)	PRIMARY NC @ 1.5" SP DISCH/RAD.	INLET SIZE (INCHES)	ELECTRICAL (VOLTS/PHASE)	MANUFACTURER	MODEL NO.	NOTE
GEV-1		605	300	1.25		12	120/1	PHOENIX CONTROLS	HEVAF12M-ALNHZ	2,3,6,7
GEV-2		1000	600	1.25		12	120/1	PHOENIX CONTROLS	HEVAF12M-ALNHZ	2,3,6,7
GEV-3		1525	345	1.25		24X12	120/1	PHOENIX CONTROLS	K HEVA212M-ALNHZ	2,3,6,7
GEV-4		985	300	1.25		12	120/1	PHOENIX CONTROLS	HEVAF12M-ALNHZ	2,3,6,7
GEV-5		880	300	1.25		12	120/1	PHOENIX CONTROLS	HEVAF12M-ALNHZ	2,3,6,7
GEV-6		670	110	1.25		12	120/1	PHOENIX CONTROLS	KEVAF12M-ALNHZ	2,3,6,7
GEV-7		4065	1460	1.25		28X14	120/1	PHOENIX CONTROLS	HEVA214M-ALNHZ	2,3,6,7
GEV8		915	600	1.25		12	120/1	PHOENIX CONTROLS	HEVAF12M-ALNHZ	2,3,6,7
									- hand	m

SOX 201	HEDULE	
PRIMARY @ 1.5" SP ISCH/RAD.	INLET SIZE (INCHES)	ELECTRICAL (VOLTS/PHAS

GMK ASSOCIATES, INC. Design/Planning/Construction 1201 Main Street, Suite 2100 Columbia, S.C. 29201 tel. 803-256-0000 fax 803-255-7243 ALL RIGHTS RESERVED. THIS DRAWING AND THE DESIGN SHOWN THEREON ARE COPYRIGHTED AS PRESCRIBED BY THE LAWS OF THE UNITED STATES AND ARE THE PROPERTY OF GMK ASSOCIATES ARCHITECTURAL DIVISION. ANYONE DUPLICATING, REPRODUCING OR CAUSING TO BE REPRODUCED THE WHOLE OR PART OF THESE DRAWINGS OR THE DESIGN THEREON WITHOUT PERMISSION OF THE ARCHITECT WILL BE SUBJECT TO LEGAL ACTION. consultants owner project name COKER - 7th FLOOR PHARMACY RENOVATION State project number H27- 6101 project number 12023.01 seals/signature issued for CONSTRUCTION <sup>date</sup> APRIL 23, 2013 date number 05/28/13 ADDENDUM NO. 2 07/25/13 VALUE ENGINEERING \_\_\_\_\_ \_\_\_\_\_ \_\_\_\_\_ \_\_\_\_\_ \_\_\_\_\_ \_\_\_\_\_ \_\_\_\_\_ \_\_\_\_\_ ---------key plan COKER Μ sheet title HVAC LEGENDS, NOTES, ABBREVIATIONS & SCHEDULES sheet number M7.1 drawn by JDR checked by JDR