



U N I V E R S I T Y O F  
**SOUTH CAROLINA**

AMENDMENT NO. 4 TO SOLICITATION

TO: ALL VENDORS

FROM: Charles Johnson, Procurement Manager

SUBJECT: SOLICITATION NUMBER: USC-RFP-1761-CJ

**SOLAR PV INSTALLATION AT USC BASEBALL STADIUM**

DATE: June 29, 2010

---

This Amendment **No. 4** modifies the Request For Proposals only in the manner and to the extent as stated herein.

---

BIDDER SHALL ACKNOWLEDGE RECEIPT OF AMENDMENT **NO. 4** IN THE SPACE PROVIDED BELOW AND RETURN IT WITH THEIR BID RESPONSE. FAILURE TO DO SO MAY SUBJECT BID TO REJECTION.

\_\_\_\_\_  
Authorized Signature


\_\_\_\_\_  
Name of Offeror

\_\_\_\_\_  
Date

**THE FOLLOWING DRAWINGS ARE THE ACTUAL PDFs FOR IMPROVED RESOLUTION AND QUALITY:**


Drawings A1-4-VE.pdf, A1-1-VE.pdf, A1-2-VE.pdf, and A1-3-VE are Architectural Drawings for the Baseball Stadium.

F:\Projects\04193\Drawings\VE Documents 121007\VE CHANGED FILES\AS BUILT\A1-4 VE ROOF LEVEL REFERENCE PLAN.dwg

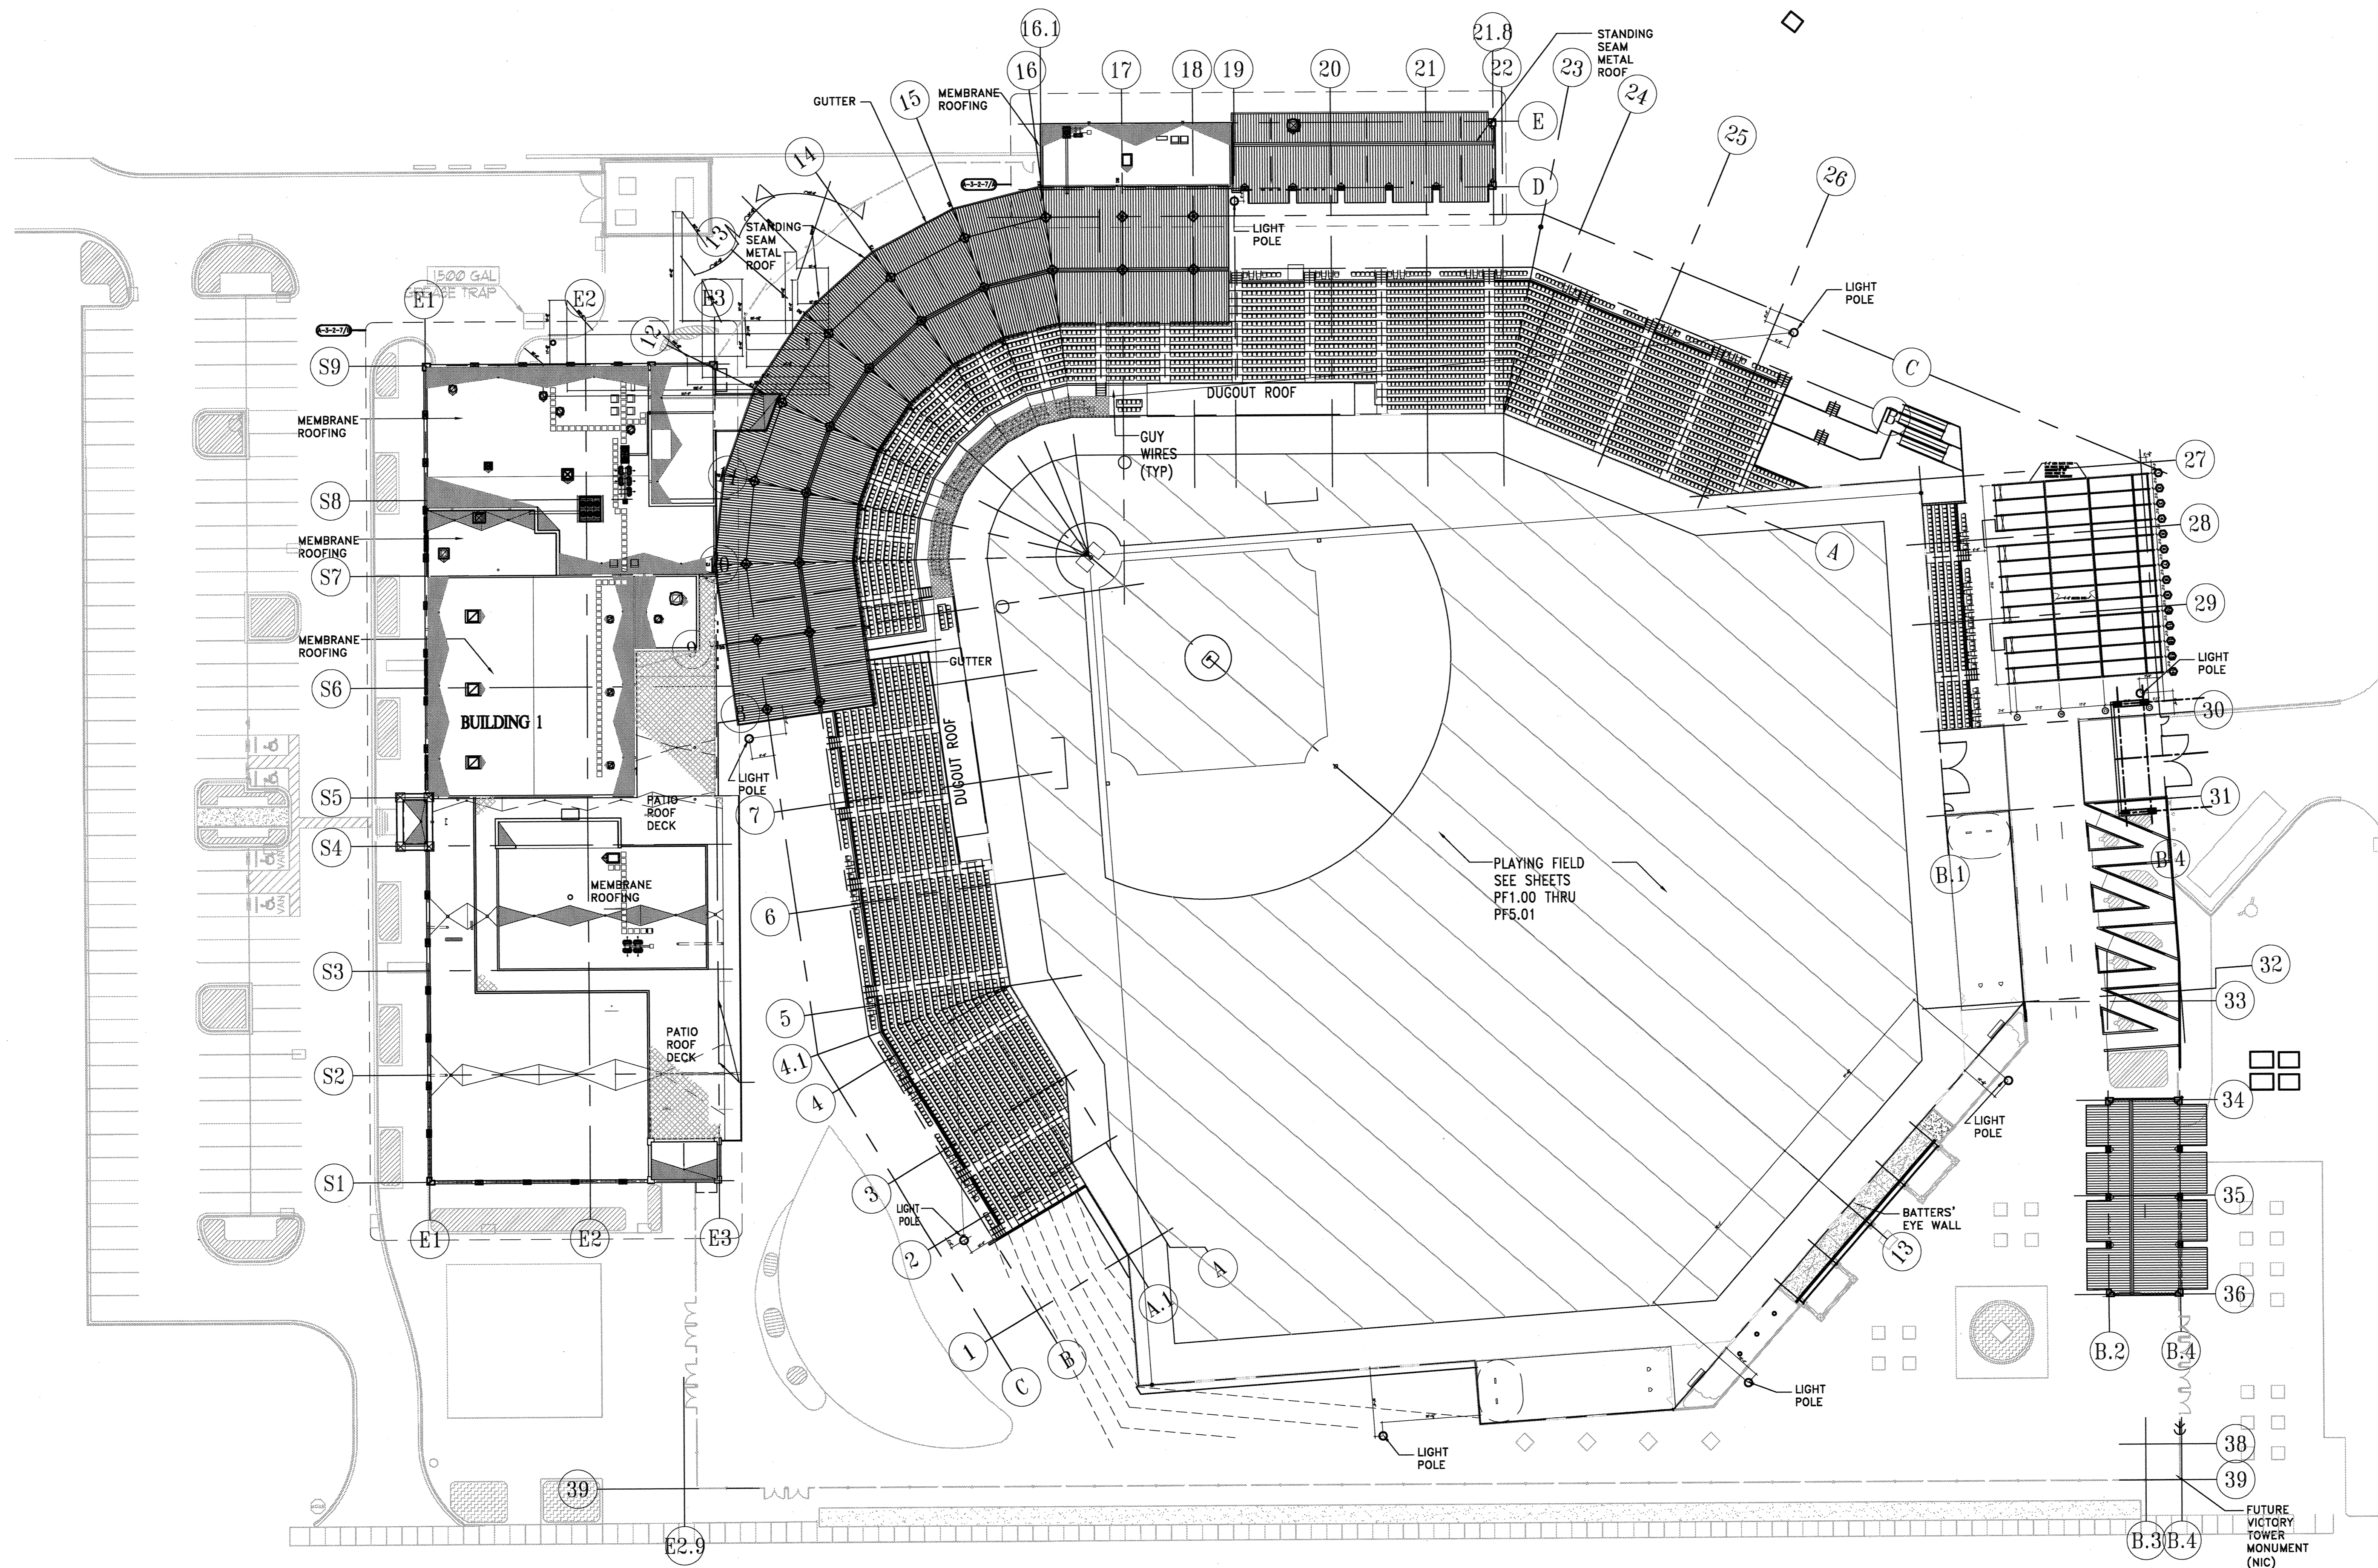

**A** ROOF LEVEL REF. PLAN

1/32"=1'-0"

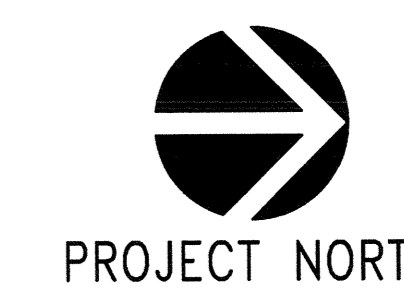

**CDA ARCHITECTS**  
 1136 Washington Street, Suite 600  
 Columbia, South Carolina 29201  
 803-799-6502 (P)  
 803-799-2014 (F)

**HOK**  
 SPORT • VENUE • EVENT


HOK SPORTS FACILITIES GROUP, LLC  
 Architecture, Engineering, Planning,  
 Interiors, Facility Programming  
 300 Wyandotte, Suite 300  
 Kansas City, Missouri 64105

**Baseball Stadium  
 Stadium Construction Package**

State Project #H27-6004-MJ-C  
**SOUTH CAROLINA**  
 UNIVERSITY OF  
 Campus Planning & Construction  
 Columbia, South Carolina, 29206

CONSTRUCTION DOCUMENT  
 SUBMITTAL  
 May 14, 2007

NO.	DATE	DESCRIPTION
10-04-07	ADDENDUM - 2	
JAN 2008	V.E. REVISIONS	
12/17/09 As Per EC		

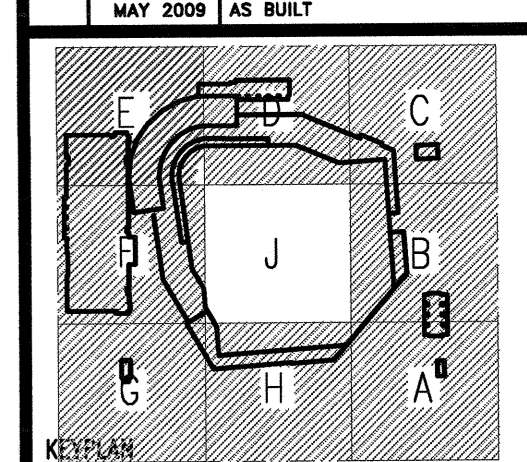


PROJECT NO. 04-193  
 ISSUED BY: CDA ARCHITECTS  
 DRAWN BY:  
 REVIEWED BY:  
 ISSUE DATE:  
 SHEET TITLE:

ROOF LEVEL REFERENCE PLAN

DISCIPLINE - CATEGORY - SUB-CATEGORY - SHEET  
**A1-4 VE**

F:\Projects\04193\Drawings\VE CHANGED FILES\AS BUILT\A1-1 VE FIELD LEVEL REFERENCE PLAN.dwg

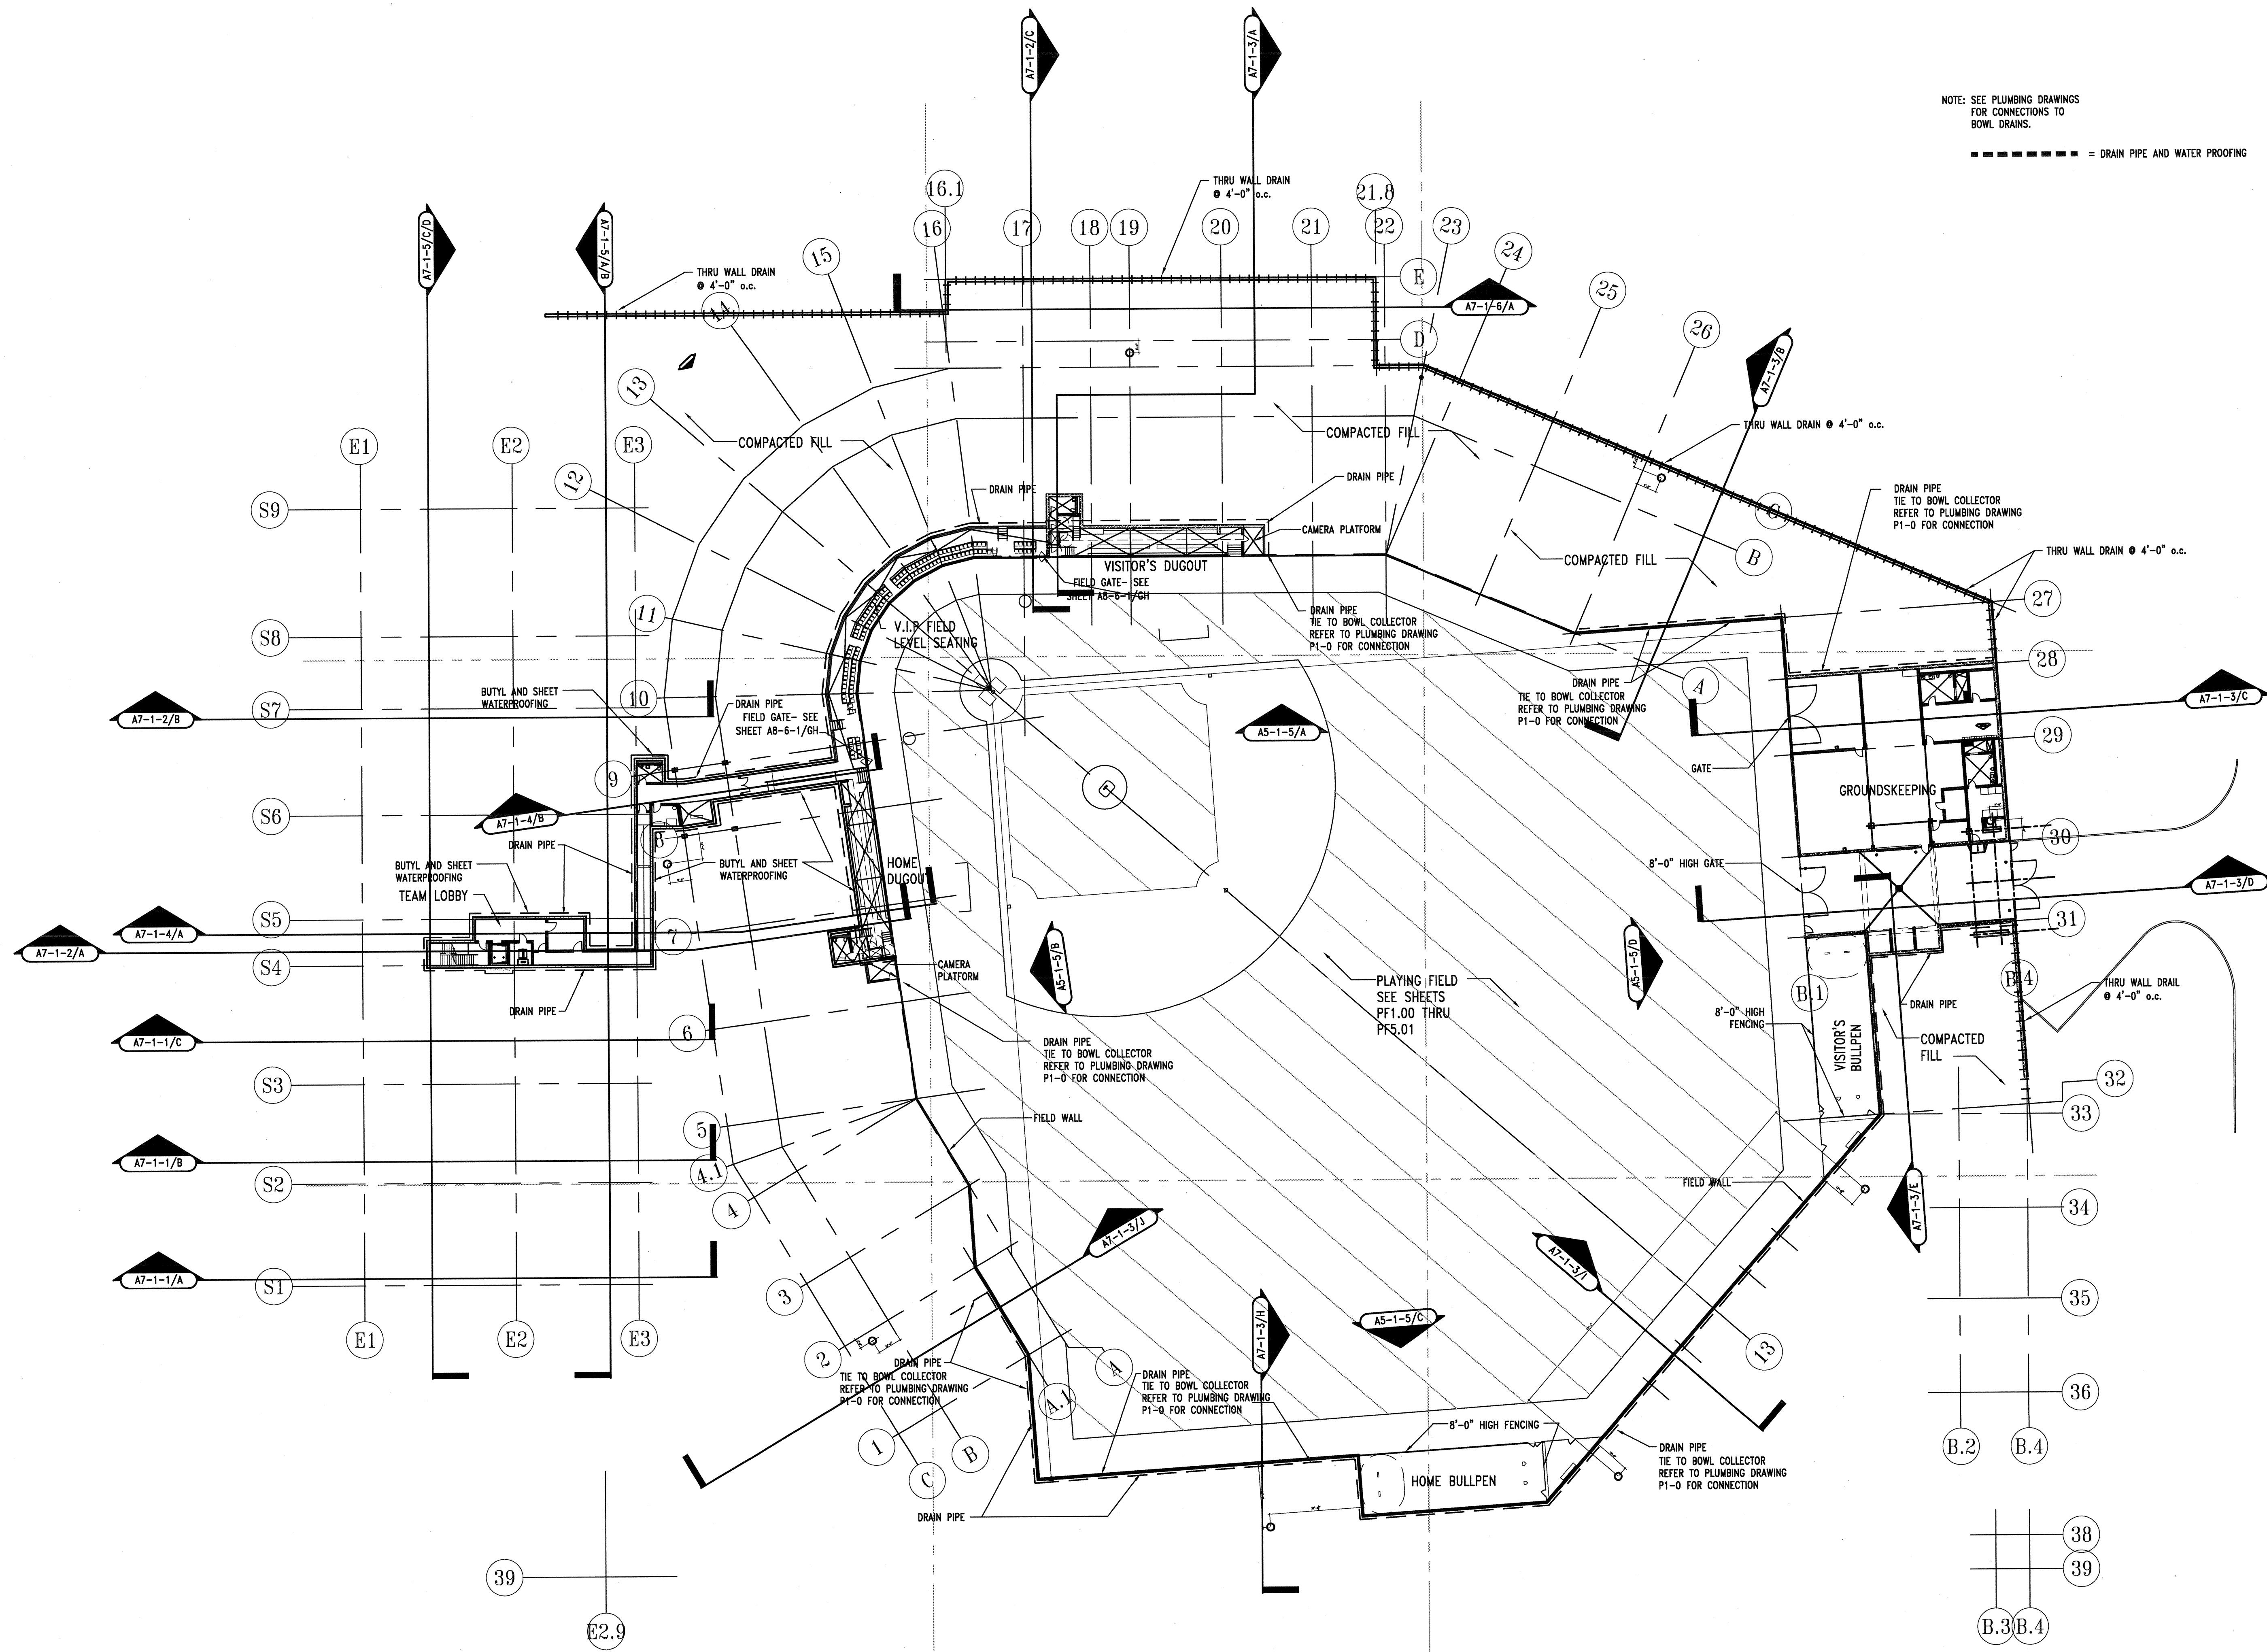

**CDA ARCHITECTS**  
 1136 Washington Street, Suite 600  
 Columbia, South Carolina 29201  
 803-799-6502 (P)  
 803-799-2014 (F)

**HOK**  
 SPORT+VENUE+EVENT


HOK SPORTS FACILITIES GROUP, LLC  
 Architecture, Engineering, Planning,  
 Interiors, Facility Programming  
 300 Wyandotte, Suite 300  
 Kansas City, Missouri 64105

**Baseball Stadium Construction Package**  
 Stadium Construction Package  
 State Project #H27-6004-14J-C

UNIVERSITY OF SOUTH CAROLINA  
 Campus Planning & Construction  
 Columbia, South Carolina, 29208

CONSTRUCTION DOCUMENT  
 SUBMITTAL  
 May 14, 2007


NO.	DATE	DESCRIPTION
10	04-07	ADDENDUM - 2
11	JAN 2008	V.E. REVISIONS
4/17/08 As BUILT		

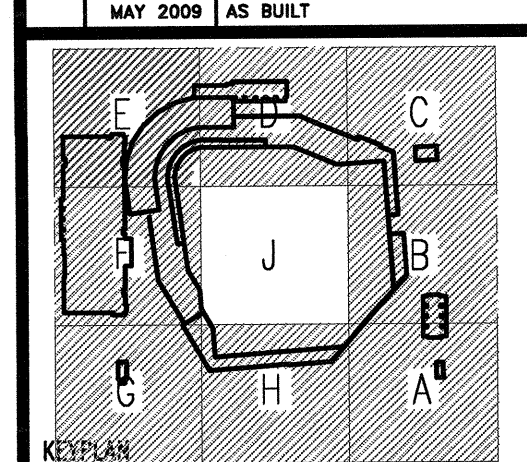

PROJECT NO. 04-193  
 ISSUED BY: CDA ARCHITECTS  
 DRAWN BY:  
 REVIEWED BY:  
 ISSUE DATE:  
 SHEET TITLE:


FIELD LEVEL REFERENCE PLAN

DISCIPLINE - CATEGORY - SUB-CATEGORY - SHEET  
**A1-1 VE**

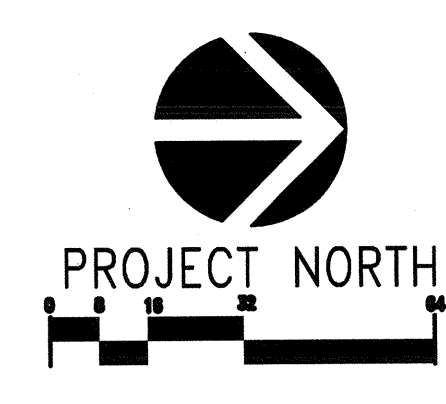

**A** FIELD LEVEL REF. PLAN  
 1/32"=1'-0"


NO.	DATE	DESCRIPTION
10-24-07		ADDENDUM - 2
1	JAN 2008	V.E. REVISIONS
1/17/08 As Built		

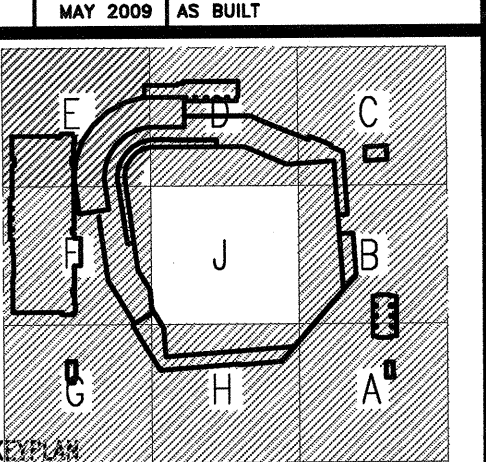


PROJECT NO. 04-193	ISSUED BY: CDA ARCHITECTS
DRAWN BY:	REVIEWED BY:
ISSUE DATE:	
SHEET TITLE:	

MAIN CONCOURSE LEVEL  
 REFERENCE PLAN


DISCIPLINE - CATEGORY - SUB-CATEGORY - SHEET  
**A1-2 VE**

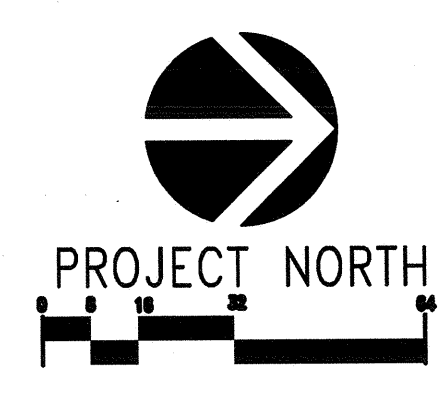

**A MAIN CONCOURSE LEVEL REF. PLAN**  
 1/32"=1'-0"

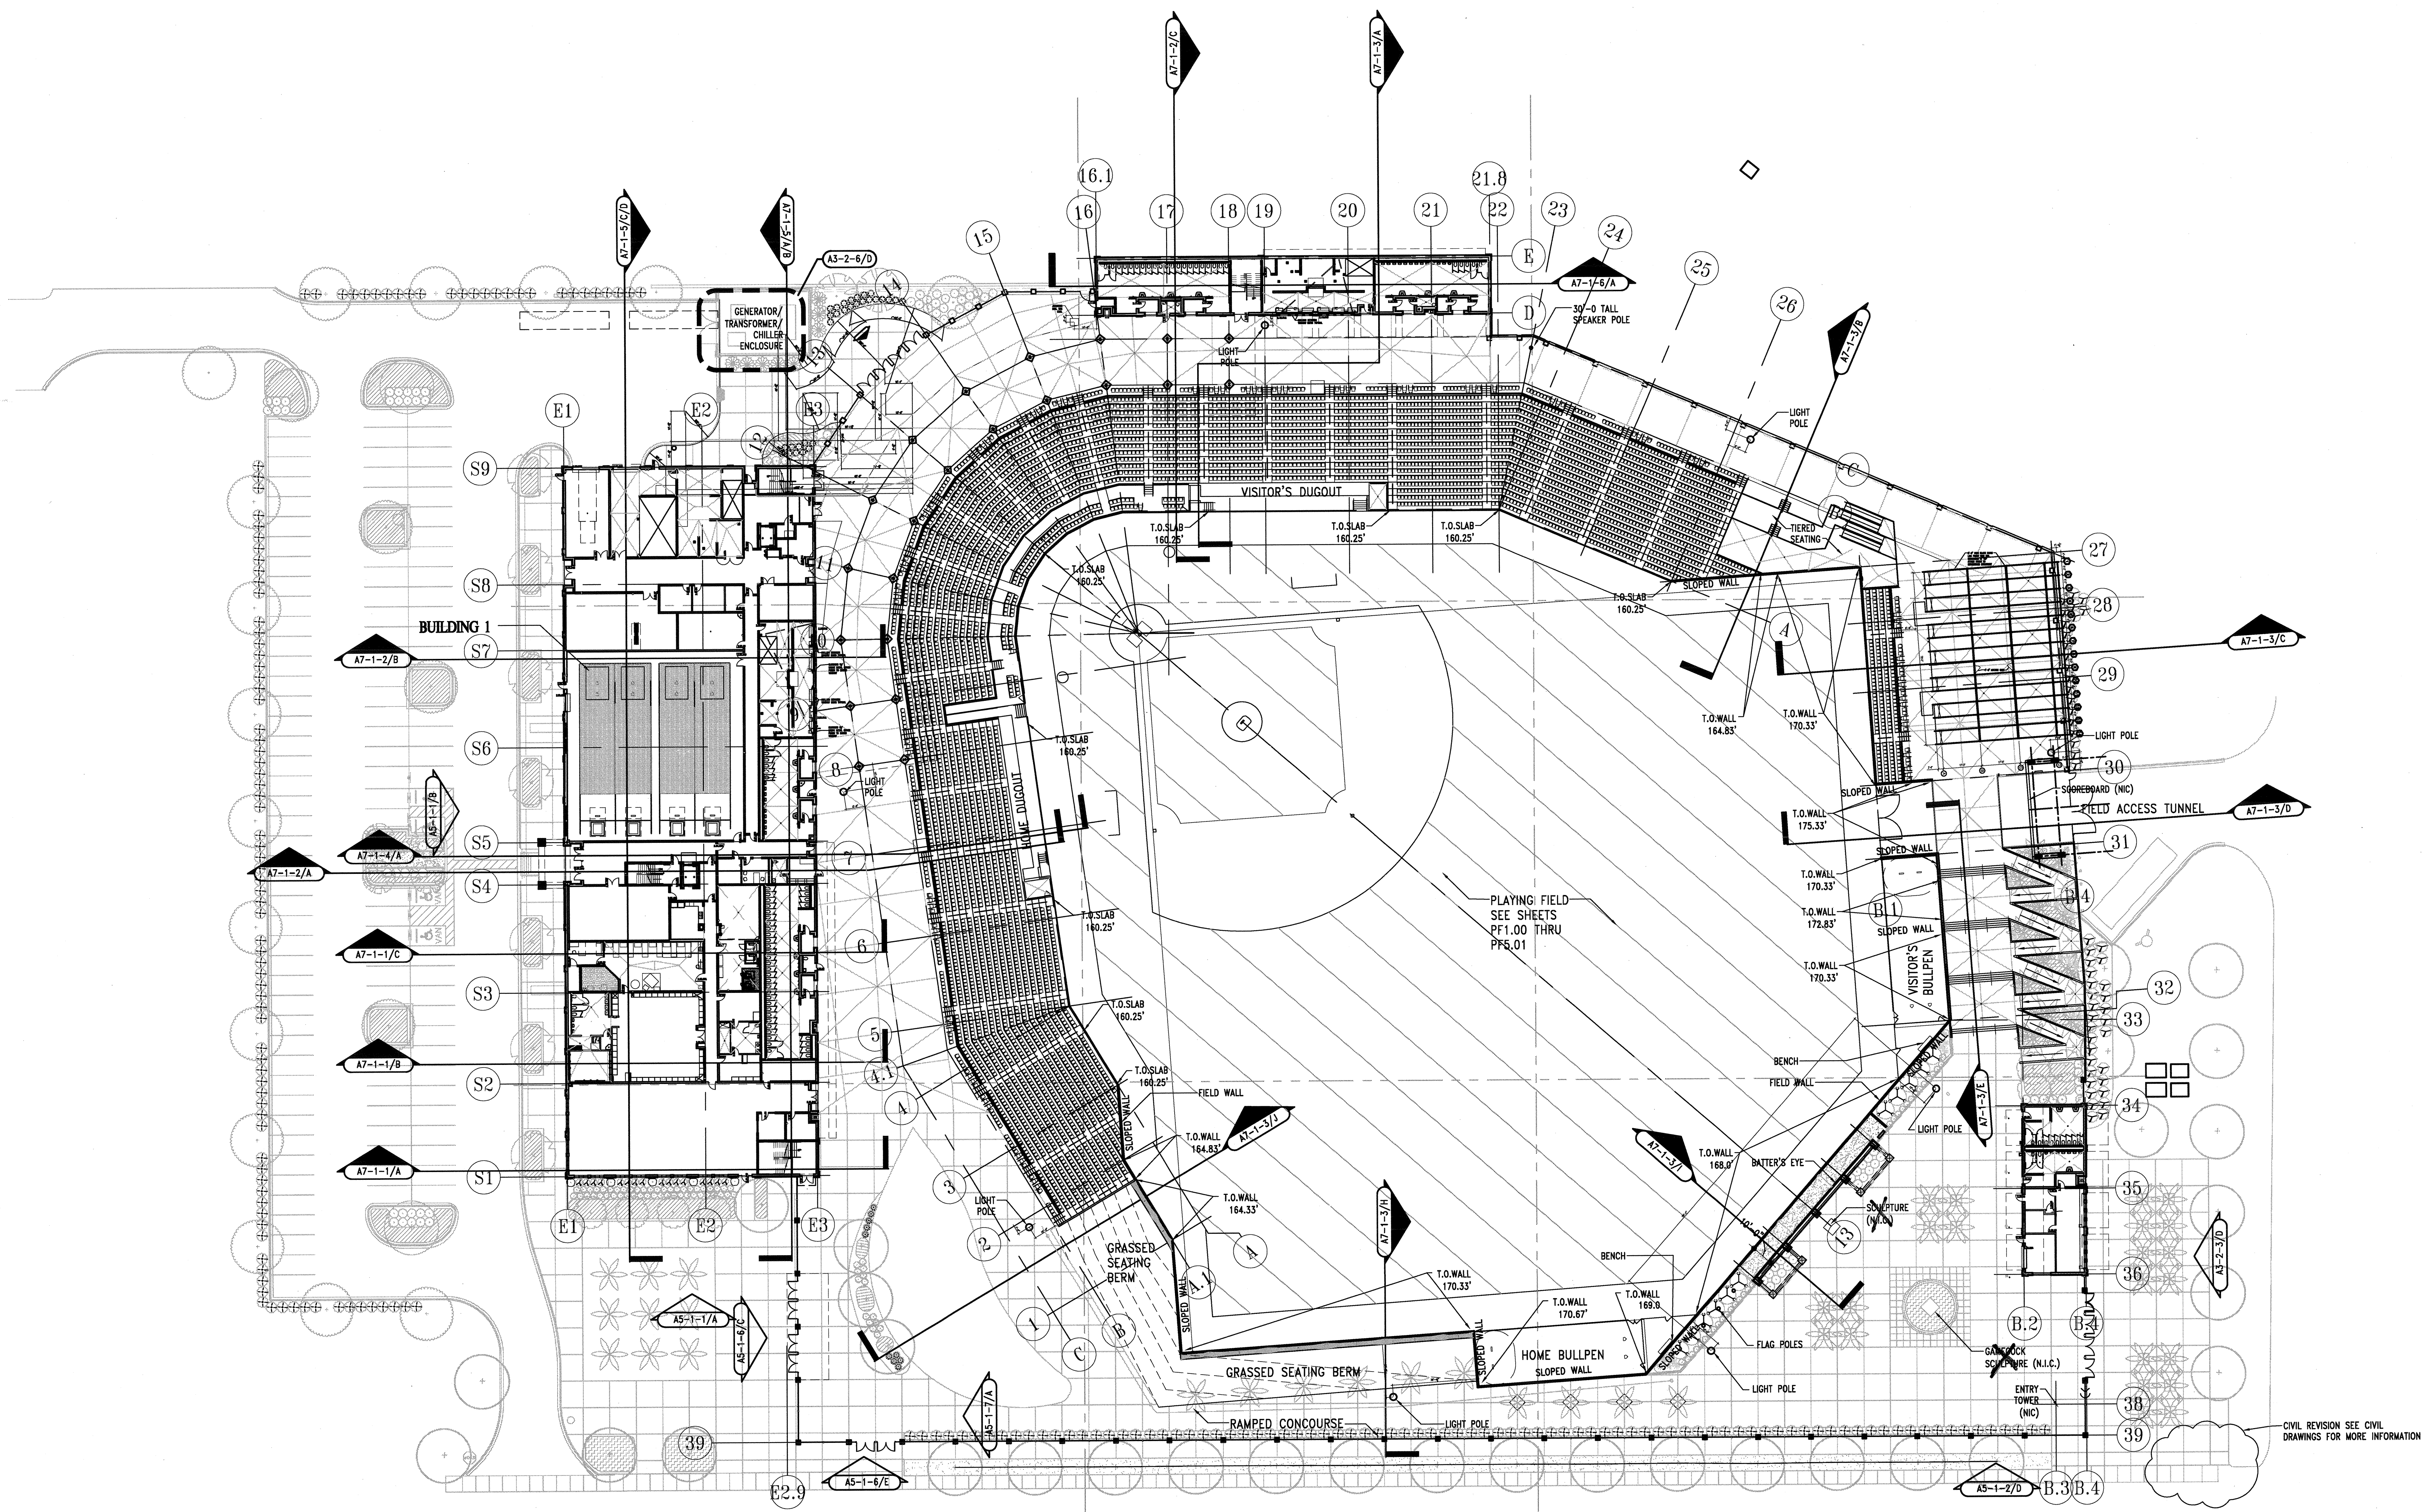

F:\Projects\04193\Drawings\VE Documents 121007\VE CHANGED FILES\AS BUILT\A1-2 VE MAIN CONCOURSE REFERENCE PLAN.dwg

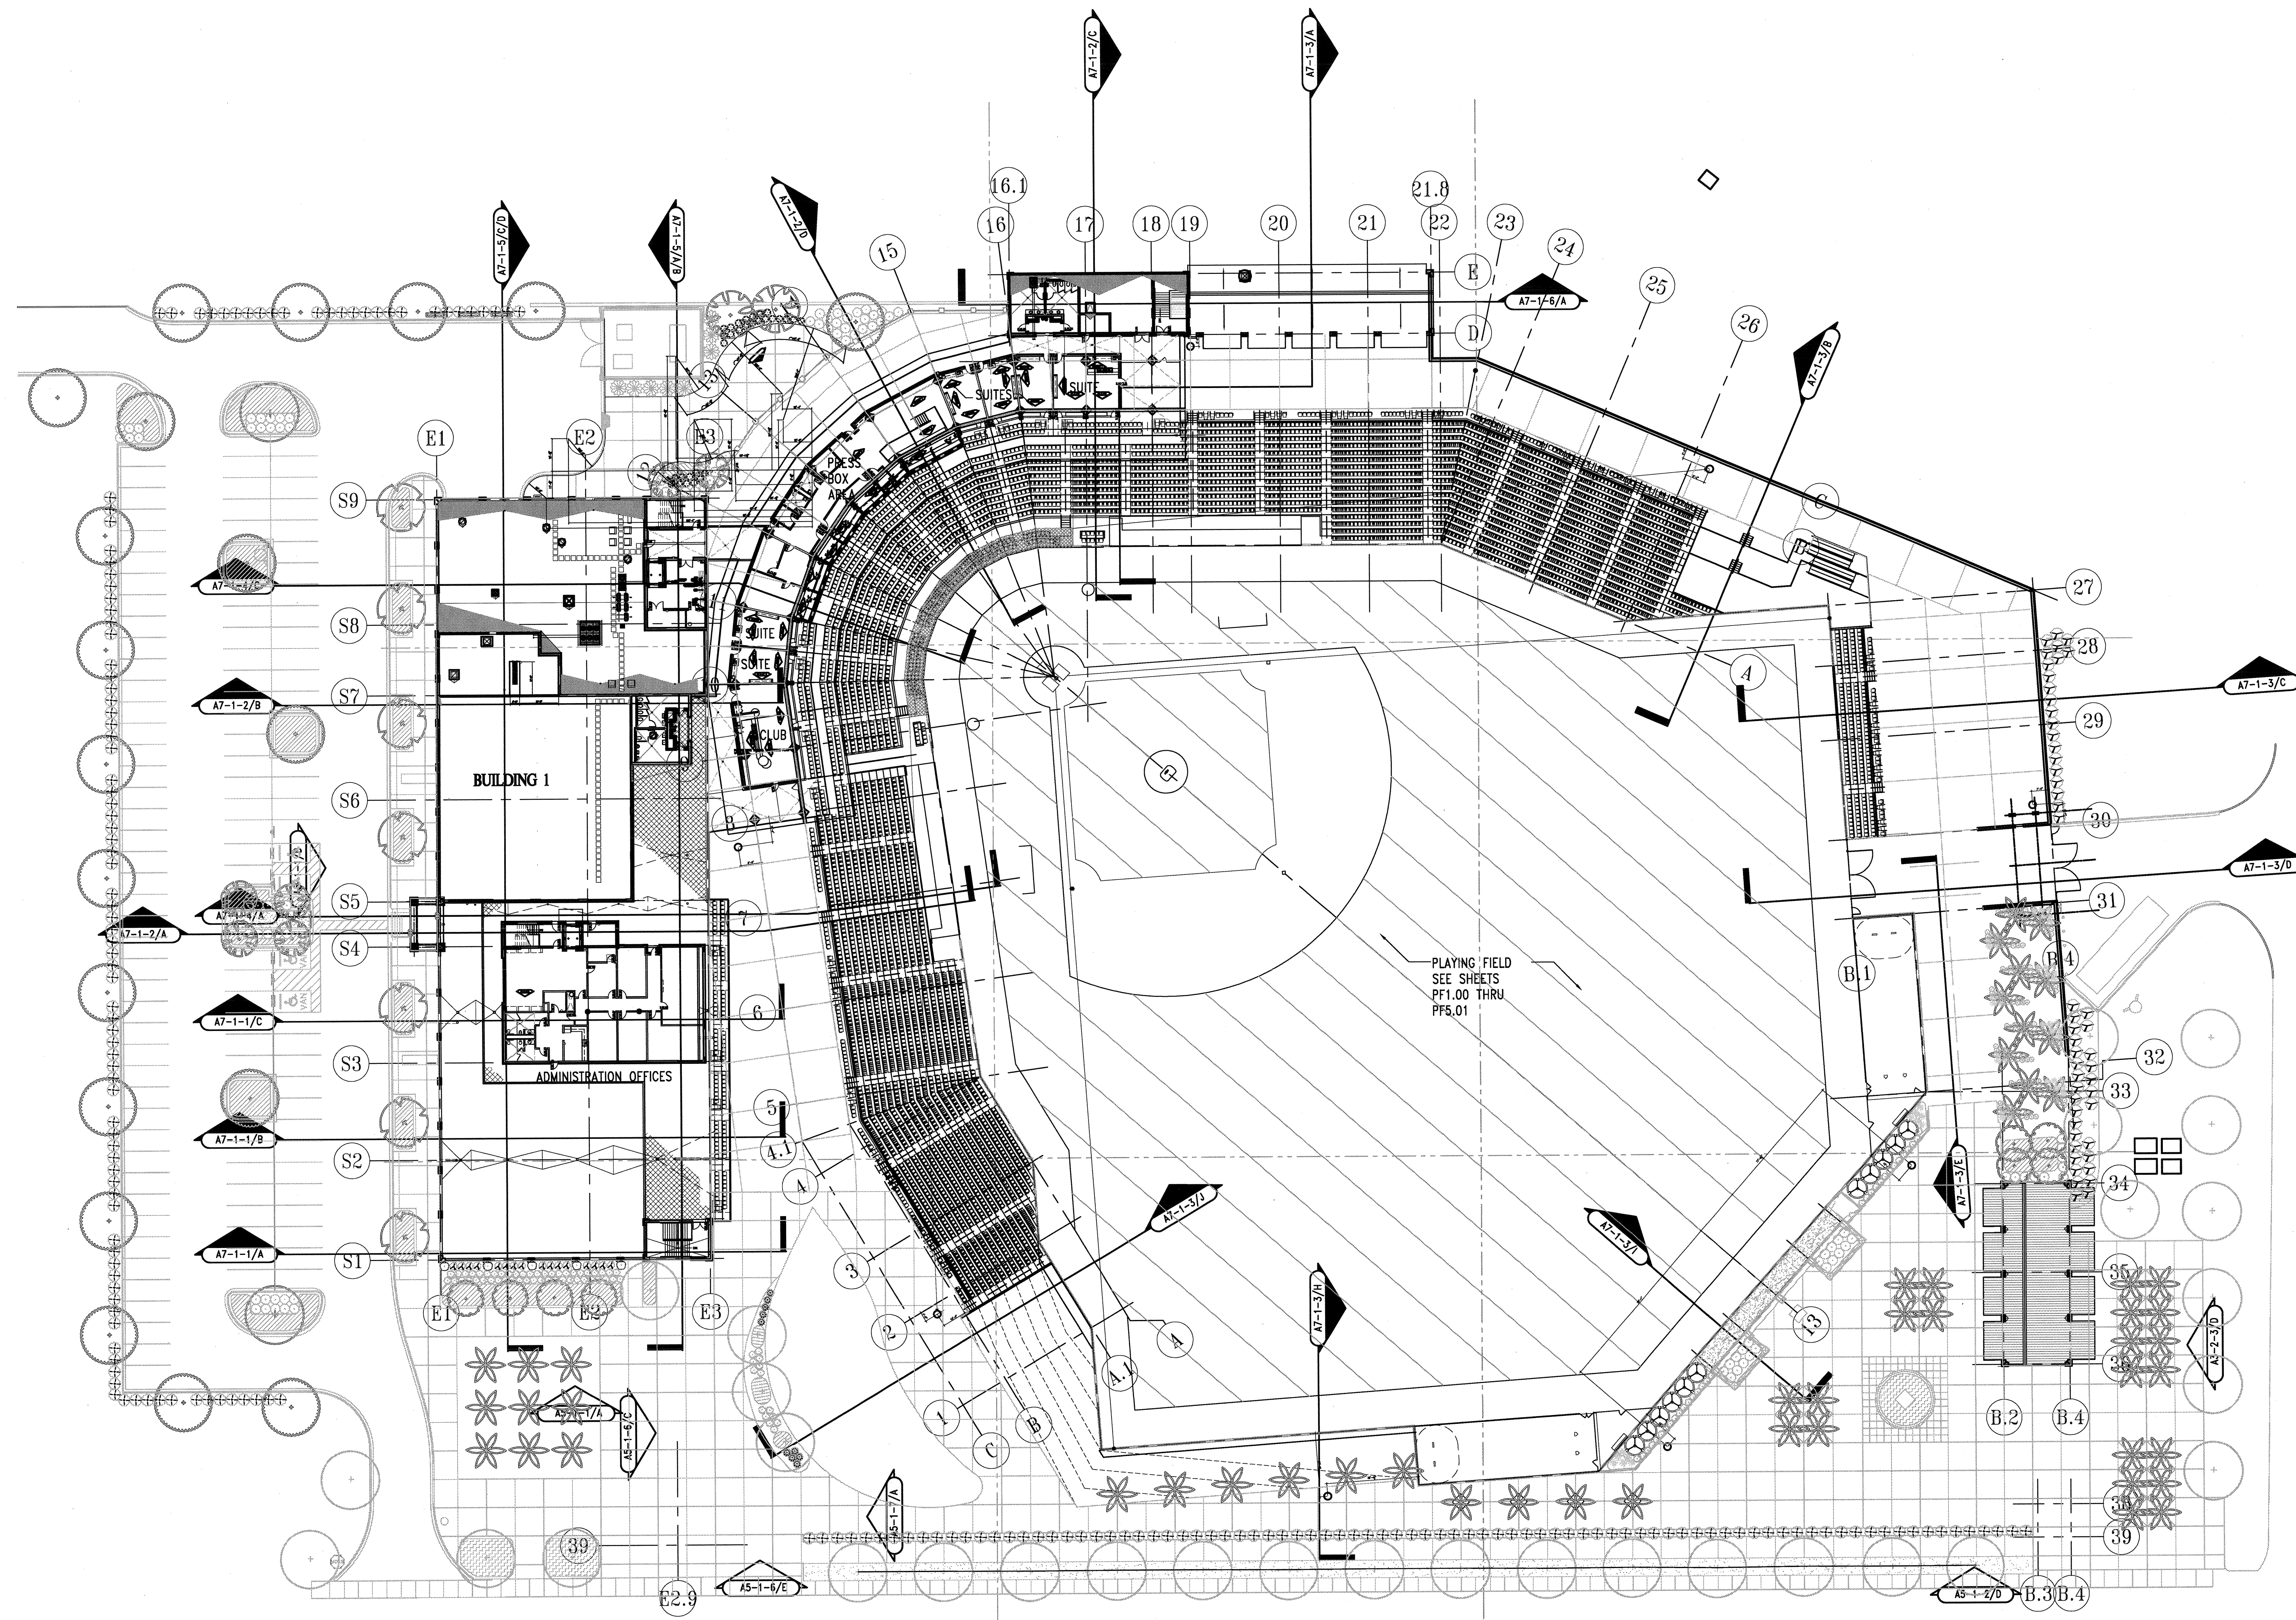

**A** SUITE LEVEL REF. PLAN

1/32"=1'-0"




**CDA ARCHITECTS**  
 1136 Washington Street, Suite 600  
 Columbia, South Carolina 29201  
 803-799-8502 (P)  
 803-799-2014 (F)

**HOK**  
 SPORT+VENUE+EVENT  
 HOK SPORTS FACILITIES GROUP, LLC  
 Architecture, Engineering, Planning,  
 Interiors, Facility Programming  
 300 Wyandotte, Suite 300  
 Kansas City, Missouri 64105

**Baseball Stadium  
 Stadium Construction Package**  
 State Project # R127-6004-10-C  
 UNIVERSITY OF  
**SOUTH CAROLINA**  
 Campus Planning & Construction  
 Columbia, South Carolina, 29208

CONSTRUCTION DOCUMENT  
 SUBMITTAL  
 May 14, 2007

NO.	DATE	DESCRIPTION
1	10-04-07	ADDENDUM - 2
2	JAN 2008	V.E. REVISIONS
6/17/07 AS BUILT		
MAY 2009 AS BUILT		

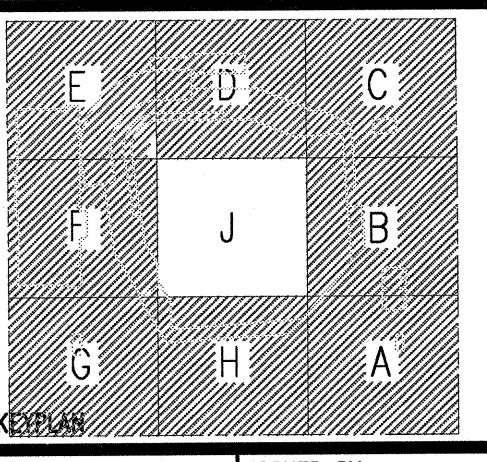

PROJECT NO. 14-193  
 ISSUED BY: CDA ARCHITECTS  
 DRAWN BY:  
 REVIEWED BY:

ISSUE DATE:  
 SHEET TITLE:  
**SUITE LEVEL REFERENCE PLAN**

DISCIPLINE - CATEGORY - SUB-CATEGORY - SHEET  
**A1-3 VE**